

DATE SUBMITTED: 12/1/86

PERMIT # _____

FEE 10⁰⁰

SIGN PERMIT

GRAND JUNCTION PLANNING DEPARTMENT

BUSINESS NAME: Shenanzigans

BUSINESS ADDRESS: 1810 No. Ave

STREET FRONTAGE: FRONT _____ FT. SIDE _____ FT.

BUILDING FRONTAGE: FRONT _____ FT. SIDE _____ FT.

TRAFFIC LANE: FRONT 4 FT. SIDE 2 FT.

HEIGHT OF SIGN: 30' FT. CLEARANCE TO GRADE: 17' FT.


AREA OF SIGN: 268^{sq} SQ. FT. AREA OF EXISTING SIGNS: NONE SQ. FT.

TOTAL ALLOWED AREA: FRONT 276 SQ. FT. SIDE _____ SQ. FT.
61^{sq} new

TYPE OF SIGN

*SKETCH

- ON PREMISE
- OFF PREMISE
- FREE STANDING
- PROJECTING
- ROOF
- FLUSH WALL
- ILLUMINATED
- OTHER

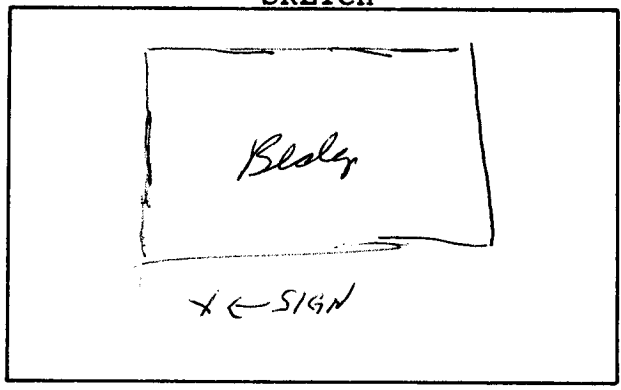

*Include: Streets, Property Lines, Proposed Sign Location.

COMMENTS Double face sign on
2 steel poles - Removing top section
Replacing with new section.

PROPERTY OWNER: Shenanzigans

ADDRESS: 1810 No Ave

CONTRACTOR: Western Now

ADDRESS: 456 No Ave

PHONE: _____

Alan Hickey
signature

APPROVED BY: [Signature]

DATE APPROVED: 12/1/86

- FINAL PERMIT
- WILL REQUIRE SEPARATE PERMIT