

DATE SUBMITTED: 7-22-87

PERMIT # 100

FEE \$15⁰⁰

226

SIGN PERMIT

GRAND JUNCTION PLANNING DEPARTMENT

BUSINESS NAME: Horizon Inn

BUSINESS ADDRESS: 754 Horizon

STREET FRONTAGE: FRONT 245' FT. SIDE 361' FT.

BUILDING FRONTAGE: FRONT 180' FT. SIDE 300' FT.

TRAFFIC LANE: FRONT 4 FT. SIDE 2 FT.

HEIGHT OF SIGN: 40' FT. CLEARANCE TO GRADE: 14' FT.

AREA OF SIGN: 160 SQ. FT. AREA OF EXISTING SIGNS: 133 SQ. FT.


TOTAL ALLOWED AREA: FRONT 397 SQ. FT. SIDE 237 SQ. FT.

TYPE OF SIGN

- ON PREMISE
- OFF PREMISE
- FREE STANDING
- PROJECTING
- ROOF
- FLUSH WALL
- ILLUMINATED
- OTHER

COMMENTS Sign on 2 steel poles.

*SKETCH

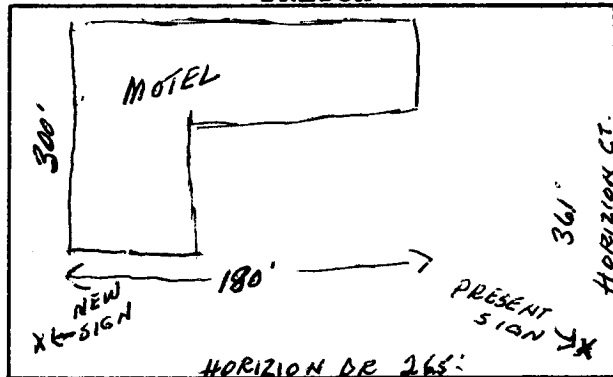

*Include: Streets, Property Lines, Proposed Sign Location.

PROPERTY OWNER: Horizon Inn

ADDRESS: 754 Horizon Dr

CONTRACTOR: Western News

ADDRESS: 456 No. Ave

PHONE: _____

Alan Siskey
Signature

APPROVED BY: Karl McPherson

DATE APPROVED: 7/22/87

- FINAL PERMIT
- WILL REQUIRE SEPARATE PERMIT electrical permit.