

DATE SUBMITTED: JULY 8, 1987

PERMIT # _____

FEE 5.00

SIGN PERMIT

GRAND JUNCTION PLANNING DEPARTMENT

BUSINESS NAME: IMMULATE HEART OF MARY CHURCH

BUSINESS ADDRESS: 776 BOOKCLIFF, GRAND JUNCTION, COLORADO 81501

STREET FRONTAGE: N/A FRONT _____ FT. SIDE _____ FT.

BUILDING FRONTAGE: N/A FRONT _____ FT. SIDE _____ FT.

TRAFFIC LANE: FRONT _____ FT. SIDE _____ FT.

HEIGHT OF SIGN: 5' FT. CLEARANCE TO GRADE: _____ FT.

AREA OF SIGN: 27 SQ. FT. AREA OF EXISTING SIGNS: 20 SQ. FT.

TOTAL ALLOWED AREA: FRONT _____ SQ. FT. SIDE _____ SQ. FT.


*Section 5-7-3B - 24 of 14.
"5-7-7(a) - 25 of 14"*

TYPE OF SIGN

- | | |
|--|--------------------------------------|
| <input checked="" type="checkbox"/> ON PREMISE | <input type="checkbox"/> ROOF |
| <input type="checkbox"/> OFF PREMISE | <input type="checkbox"/> FLUSH WALL |
| <input type="checkbox"/> FREE STANDING | <input type="checkbox"/> ILLUMINATED |
| <input type="checkbox"/> PROJECTING | <input type="checkbox"/> OTHER |

COMMENTS _____

***SKETCH**

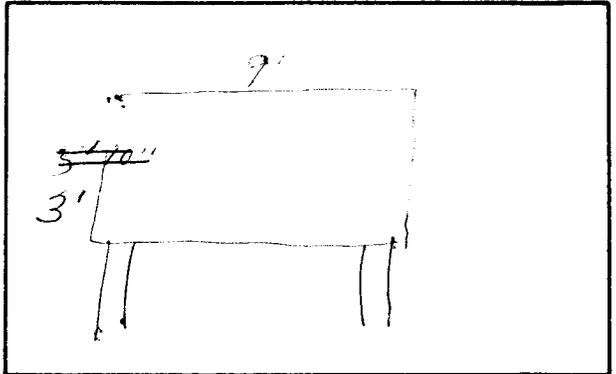

*Include: Streets, Property Lines, Proposed Sign Location.

PROPERTY OWNER: BISHOP ARTHUR N. TAFOYA -DIOCESE OF PUEBLO

ADDRESS: 1001 N. GRAND AVE., PUEBLO, CO 81003

CONTRACTOR: Salazar Sign Co

ADDRESS: 556 Ashley Lane

PHONE: 243-0071

Joe C. Salazar
Signature

APPROVED BY: Kathy Portman (Kim)

DATE APPROVED: 7/10/87

*C. Robert Haberman
242-6121*

- | | |
|---|----|
| <input checked="" type="checkbox"/> FINAL PERMIT | 49 |
| <input type="checkbox"/> WILL REQUIRE SEPARATE PERMIT | |