

DATE SUBMITTED: October 3, 1988

PERMIT # _____

2945-092-10-014

FEE \$10.00

SIGN PERMIT

GRAND JUNCTION PLANNING DEPARTMENT

BUSINESS NAME: Diggle

BUSINESS ADDRESS: 2440 Hwy 64.50 (Mass Mall)

STREET FRONTAGE: FRONT 250 FT. SIDE 190 FT.

BUILDING FRONTAGE: FRONT 100' FT. SIDE 100' FT.

TRAFFIC LANE: FRONT 4 Ln. FT. SIDE 2 Ln FT.

HEIGHT OF SIGN: 7 1/2' FT. CLEARANCE TO GRADE: 2 1/2' FT.

AREA OF SIGN: 30' 50' 5' 10' 50' Setters 63 SQ. FT. AREA OF EXISTING SIGNS: NA SQ. FT.

TOTAL ALLOWED AREA: FRONT 113 375 SQ. FT. SIDE 142.5 SQ. FT.

Bldg facade = 200 sq. ft.

TYPE OF SIGN

*SKETCH

Revised location O.K.

- ON PREMISE
- OFF PREMISE
- FREE STANDING
- PROJECTING
- ROOF
- FLUSH WALL
- ILLUMINATED
- OTHER

COMMENTS Setters 3 Sets

3-24" 4-18"

$$\begin{array}{r} \times 4 \# \\ 3 \\ \hline 12 \end{array}$$

$$\begin{array}{r} 2.25 \# \\ \times 4 \\ \hline 9 \end{array}$$
21 x 3 (63#)


PROPERTY OWNER: _____

ADDRESS: _____

CONTRACTOR: GRAND JUNCTION SIGNS

ADDRESS: 2915 HILL AVENUE

PHONE: 245-2950

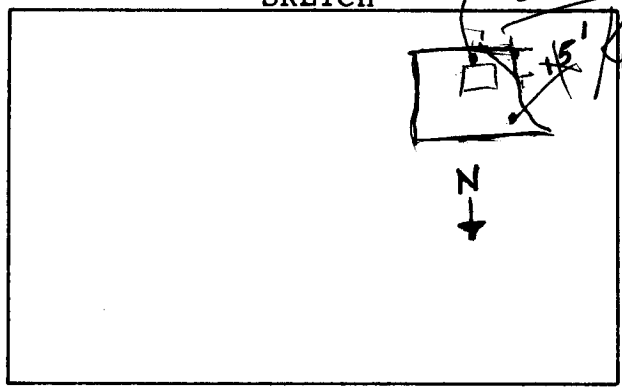

*Include: Streets, Property Lines, Proposed Sign Location.

Jim Cook
Signature

APPROVED BY: Kathy Postner

DATE APPROVED: 10/3/88

total allowance on side street = 142.5 sq. ft.
free standing = 50 sq. ft.
flush wall = 21 sq. ft.
total allowance front linear Bldg facade = 200 sq. ft.

- FINAL PERMIT
- WILL REQUIRE SEPARATE PERMIT

flush wall on front = 21 sq. ft.
" " on east side = 21 sq. ft.