

DATE SUBMITTED: 11-13-89

PERMIT # _____
FEE 3 @ 5 ea / \$15.00

SIGN PERMIT

GRAND JUNCTION PLANNING DEPARTMENT

BUSINESS NAME: MEL'S SERVICE CENTER

BUSINESS ADDRESS: 1162 UTE AVE.

STREET FRONTAGE: FRONT 100' FT. SIDE 125' FT.

BUILDING FRONTAGE: FRONT 50' FT. SIDE 50' FT.

TRAFFIC LANE: FRONT _____ FT. SIDE _____ FT.

HEIGHT OF SIGN: 8'-0" FT. CLEARANCE TO GRADE: 4'-0" FT.

AREA OF SIGN: 96 SQ. FT. AREA OF EXISTING SIGNS: 0 SQ. FT.


TOTAL ALLOWED AREA: FRONT 175 SQ. FT. SIDE 218.75 SQ. FT.

TYPE OF SIGN

- ON PREMISE
- OFF PREMISE
- FREE STANDING
- PROJECTING
- ROOF
- 2 - FLUSH WALL
- ILLUMINATED
- OTHER

COMMENTS _____

*SKETCH

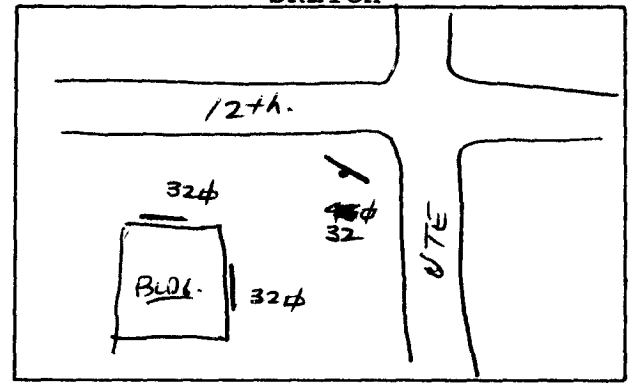

*Include: Streets, Property Lines, Proposed Sign Location.

PROPERTY OWNER: ROBERT S. COBURN

ADDRESS: 3770 BLAIR RD.

CONTRACTOR: BUD'S SIGNS

ADDRESS: 1055 UTE

PHONE: 245-7700

[Signature]
Signature

APPROVED BY: Kathy Metzger

DATE APPROVED: 11/13/89

- FINAL PERMIT
- WILL REQUIRE SEPARATE PERMIT