

DATE SUBMITTED: 8/17/90

PERMIT # _____

TAX SCHEDULE #: 2945-112-00971

FEE 5.00

SIGN PERMIT ✓

GRAND JUNCTION PLANNING DEPARTMENT

BUSINESS NAME: St Mary Hospital

BUSINESS ADDRESS: 2635 N 17th

STREET FRONTAGE: 7 FRONT 630 FT. P SIDE 495 FT.

BUILDING FRONTAGE: FRONT 56 FT. SIDE 149 FT.

TRAFFIC LANE: FRONT 4 FT. SIDE 4 FT.

HEIGHT OF SIGN: 3 FT. CLEARANCE TO GRADE: 7 FT.


AREA OF SIGN: 18 SQ. FT. AREA OF EXISTING SIGNS: _____ SQ. FT.

TOTAL ALLOWED AREA: FRONT 945 SQ. FT. SIDE 742.5 SQ. FT.

TYPE OF SIGN

*SKETCH

- | | |
|---------------------------------------------------|-------------------------------------------------|
| <input checked="" type="checkbox"/> ON PREMISE | <input type="checkbox"/> ROOF |
| <input type="checkbox"/> OFF PREMISE | <input type="checkbox"/> FLUSH WALL |
| <input checked="" type="checkbox"/> FREE STANDING | <input checked="" type="checkbox"/> ILLUMINATED |
| <input type="checkbox"/> PROJECTING | <input type="checkbox"/> OTHER |

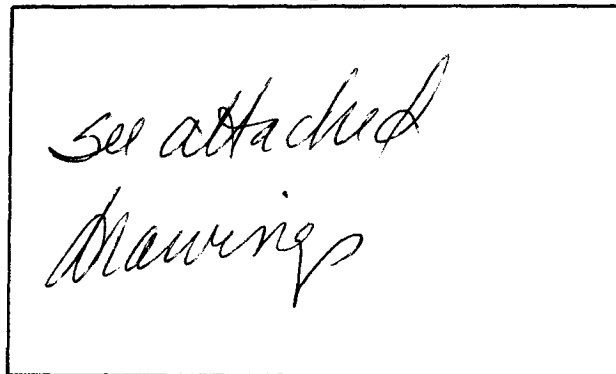

COMMENTS _____

*Include: Streets, Property Lines, Proposed Sign Location.

PROPERTY OWNER: St Mary Foundation

ADDRESS: 2635 N 17th

CONTRACTOR: Grand Jet Signs

ADDRESS: 2915 Hill

PHONE: 245-2950

Barbara Fattua
Signature

APPROVED BY: Kathy Peterson

DATE APPROVED: 8/17/90

- FINAL PERMIT
- WILL REQUIRE SEPARATE PERMIT


7' 55" ± E 32' Conc.
Driveway section

7' 96" P.T.
B.O.W. 39.5' Lt.

Proposed sign

6 ft behind sidewalk
O.K.ed by Jim White
MO with advance plat
8/13/90

SHEET NO. 7

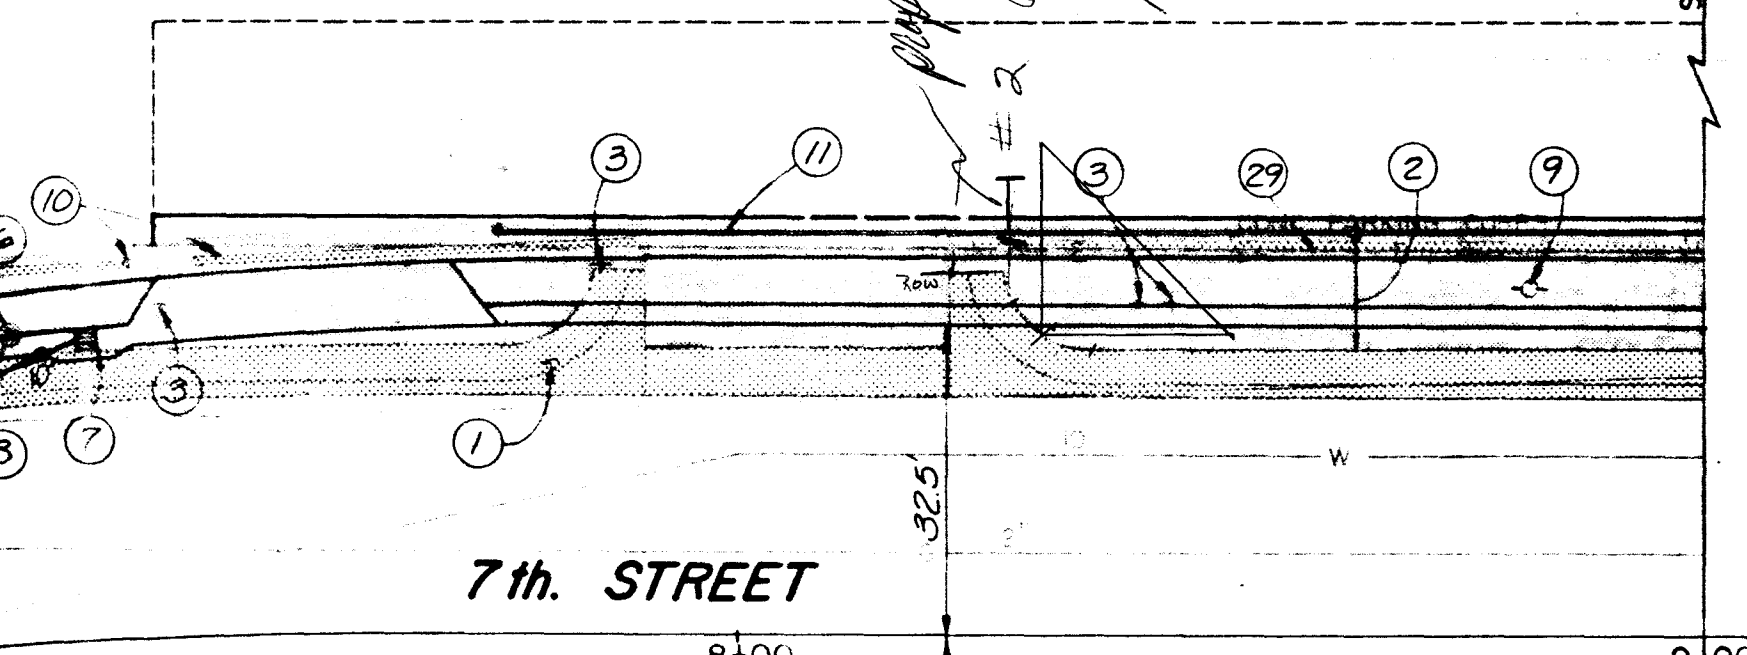

7th STREET

8+00

9+00

Replaced w/ Concrete
Not Sod As Shown
In Item 30.

32.5'

35.5'


2

Row

W

Lot "A" East Entrance


#2

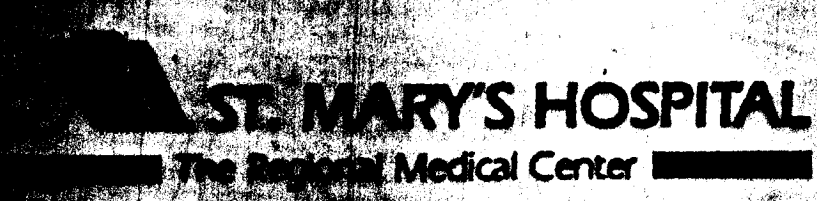

**VISITORS
ENTRANCE**


367

View from South

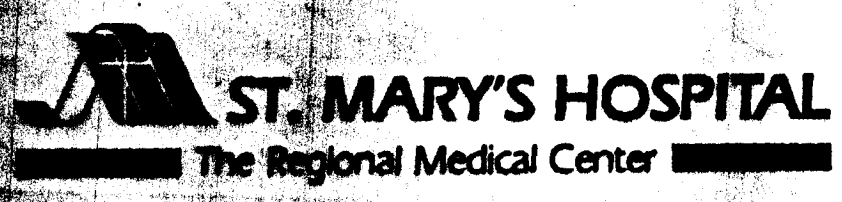

**VISITORS ENTRANCE
EMERGENCY**

View from North

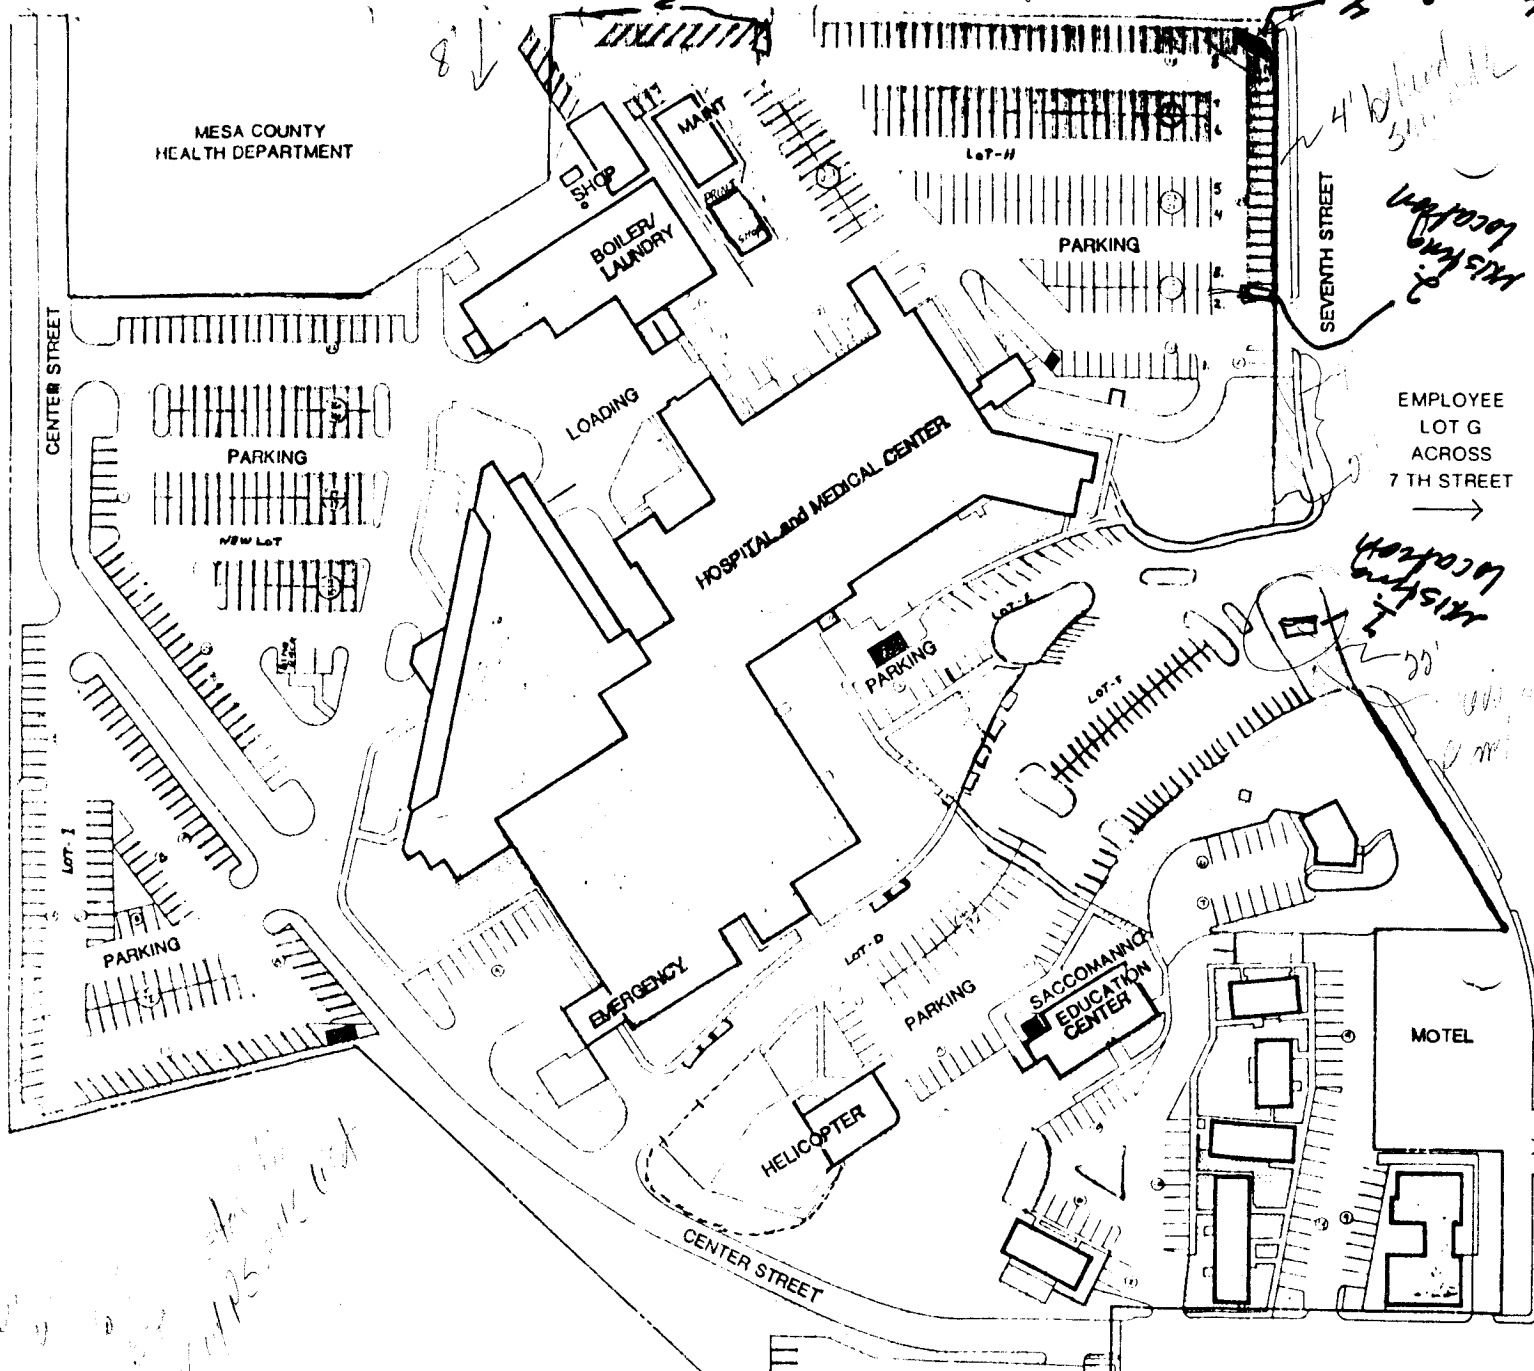


from front lot 20' by 100' from 7th
16' from pavement
20' triangle

4' by 100' by 100'
30' by 100'

EMPLOYEE LOT G ACROSS 7 TH STREET →



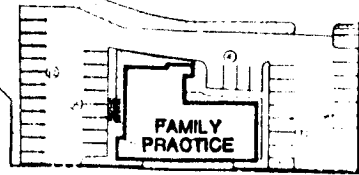

Pattern - bring up north 1/2'
7/10' - behind 7' - 10' - 10' - 10'
30' - 10'

St. Mary's Employee Parking

- Day and Evening Shifts
- Night Shift (11 p.m. to 7 a.m.)
- Bike Racks

Employees parking on hospital property must display a St. Mary's Parking Sticker on the rear of vehicle.

