



SIGN PERMIT

Community Development Department
250 North 5th Street
Grand Junction, CO 81501
(303) 244-1430

PERMIT NO. 47111 ✓
Date Submitted 12/6/93 ✓
FEE \$ 10.00 ✓
Tax Schedule: 2701-364-00-026
Zone: H0

STREET ADDRESS 750 1/4 Horizon Dr. ADDRESS 2495 E
OWNER ADDRESS 750 1/4 Horizon Dr. LICENSE NO 2930179

- 1. FLUSH WALL 2 Square Feet per Linear Foot of Building Facade
- 2. ROOF 2 Square Feet per Linear Foot of Building Facade
- 3. FREE-STANDING 2 Traffic Lanes - 0.75 Square Feet x Street Frontage
4 or more Traffic Lanes - 1.5 Square Feet x Street Frontage
- 4. PROJECTING 0.5 Square Feet per Each Linear Foot of Building Facade
- 5. OFF-PREMISE See #3 Spacing Requirements; Not > 300 Square Feet or < 15 Square Feet

Externally Illuminated Internally Illuminated Non-Illuminated

(1 - 5) Area of Proposed Sign 98 Square Feet
(1,2,4) Building Facade NA Linear Feet
(1 - 4) Street Frontage 20' Linear Feet
(2,4,5) Height to Top of Sign 25' Feet Clearance to Grade 18' Feet
(5) Distance from all Existing Off-Premise Signs within 600 Feet NA Feet

<u>Existing Signage/Type</u>	
<u>NONE</u>	Sq Ft
_____	Sq Ft
_____	Sq Ft
_____	Sq Ft
Total Existing:	_____ Sq Ft

FOR OFFICE USE ONLY:

Signage Allowed on Parcel

Building _____ Sq Ft


Free-Standing _____ Sq Ft

Total Allowed: _____ Sq Ft

COMMENTS: This sign is approved with planned development Special Permit See File #

NOTE: No sign may exceed 300 square feet. A separate sign permit is required for each sign. Attach a sketch of proposed and existing signage including types, dimensions, lettering, abutting streets, alleys, easements, property lines, and locations. All signs require a separate permit from the Building Department.


J. G. [Signature] 12-293 Kristen K. [Signature] 12/7/93
Applicant's Signature Date Approved By Date

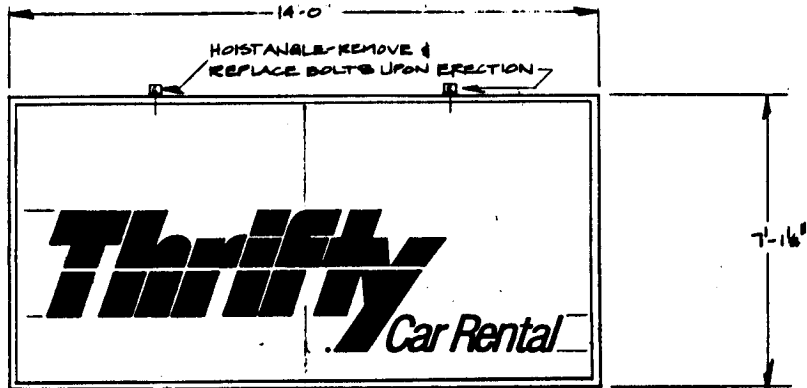

5/8" - 11 HEX NUT T' WELD TO INSIDE OF COLUMN FOR
 5/8" - 11 X 3" BOLT (AS 2'S)
 5/8" FLAT WASHER
 5/8" LOCK WASHER
 (4) ERF / SIGN
 ALL STL. PL.

3/4" - 10 x 1/4" HHMB
 3/4" LOCK WASHER
 3/4" ANCHOR NUT IN COLUMN
 (2) ERF PER SIGN

1 ADDER

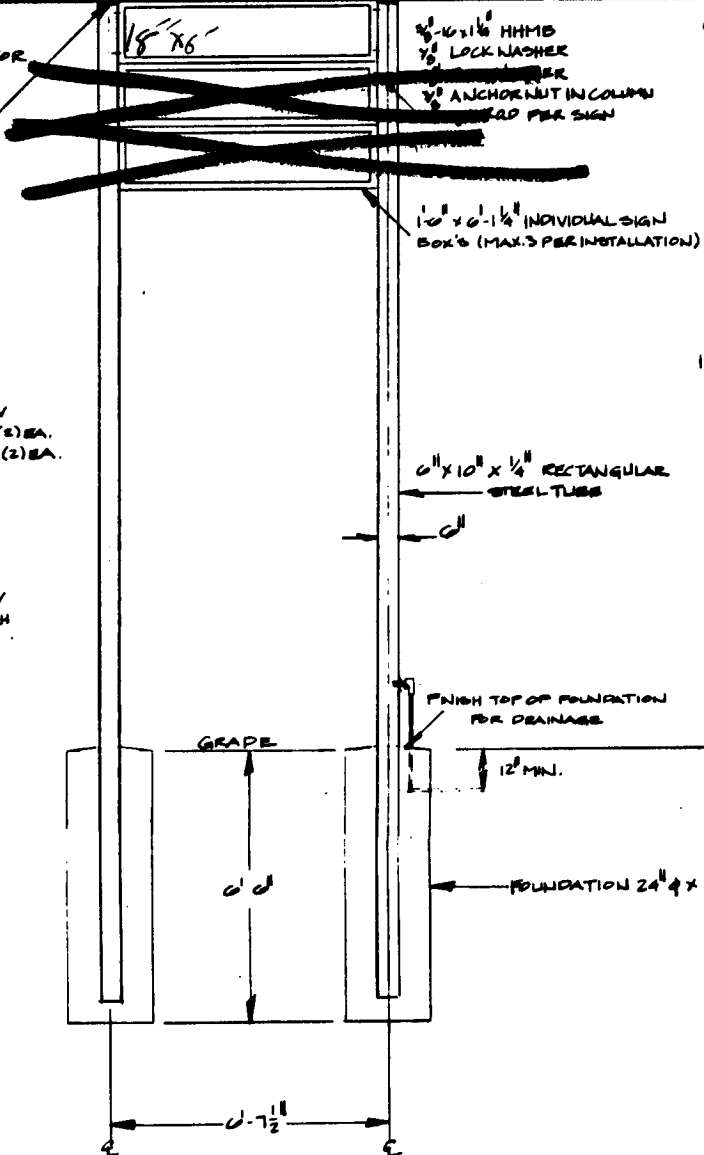

NOTES (14' x 7'-1 1/4" SIGN):

- 1) ELECTRICAL LOAD 12.0 AMPS / 120V
- 2) BALLAST REQ. UNJ. 51-771 (2) EA.
- 3) (4) LAMPS REQ. UNJ. 51-793 J (2) EA.
- 4) AREA OF SIGN 90 FT²
- 5) APPROX. WGT. OF SIGN 350 LBS.

NOTES (1'-6" x 6'-1 1/4" SIGN):

- 1) ELECTRICAL LOAD 1.0 AMP / 120V
- 2) BALLAST REQ. UNJ. 51-601 X-LH
- 3) LAMPS REQ. (2) P72TZ / HO / CH
- 4) AREA OF SIGN 9 FT²
- 5) APPROX. WGT. OF SIGN

NOTES (GENERAL):

- 1) DESIGN WIND LOAD 30 P.S.F.
- 2) SERVICE SIGN THRU HINGED FACE
- 3) ONE 15A / 120V CIRCUIT REQ. FOR 7' x 14' SIGN ALONE OR ONE 20A / 120V CIRCUIT REQ. FOR 7' x 14' SIGN PLUS UP TO TWO 1'-6" x 6' SIGNS OR TWO 15A / 120V CIRCUITS REQ. FOR ALL FOUR SIGNS

FRONT ELEVATION

1/2" = 1'-0"

VION Visual Communication, Inc. DALLAS, TEXAS		THIRTY CAR RENTAL TULSA, OKLA.		
		ERECTION DRAW'G FOR: 14' x 7'-1 1/4" D/P SIGN		
DATE	SCALE	ENGINEER	FILE NO.	SHEET NO.
4-21-86	NOTED	POWELL	103A P	40-1