GERAND JURG GERAND	SIGN PERMIT Community Development Department 250 North 5th Street Grand Junction, CO 81501 (303) 244-1430	PERMIT NO Date Submitted $\underline{\$ - (0.95)}$ FEE \$ <u>5.00</u> Tax Schedule <u>2945-142-02-013</u> Zone <u>(1-2</u>				
BUSINESS NAME STREET ADDRESS PROPERTY OWNER OWNER ADDRESS	DAnova ShAmock ADDR	RACTOR WOJTEIN WENN ISE NO 2450160 ESS 2495 Indussand PHONENO 242-7847				
 [] 1. FLUSH W [] 2. ROOF [] 3. FREE-STA [] 4. PROJECT [] 5. OFF-PRED [] 5. OFF-PRED 	2 Square Feet per Linear2 Square Feet per Linear2 Traffic Lanes - 0.75 S4 or more Traffic Lanes1NG0.5 Square Feet per eachMISESee #3 Spacing Requirer	Foot of Building Facade Foot of Building Facade quare Feet x Street Frontage - 1.5 Square Feet x Street Frontage Linear Foot of Building Facade ments; Not > 300 Square Feet or < 15 Square Feet Illuminated [] Non-Illuminated				
 (1 - 5) Area of Proposed Sign Square Feet (1 - 5) Area of Proposed Sign Square Feet (1,2,4) Building Facade Linear Feet (1 - 4) Street Frontage Unit North Que, (2,4,5) Height to Top of Sign Feet Clearance to Grade Feet (5) Distance from all Existing Off-Premise Signs within 600 Feet Feet 						
(1 - 5) Area of Pr (1,2,4) Building F (1 - 4) Street From (2,4,5) Height to 7	acade <u>2540</u> Linear Feet tage 10177 ²⁰ Linear Feet 1 Fop of Sign <u>/ 2</u> Feet Clea	rance to Grade <u>6</u> Feet				
(1 - 5) Area of Pr (1,2,4) Building F (1 - 4) Street From (2,4,5) Height to 7 (5) Distance fr Existing Signage/Ty \mathcal{E} Free s rand \mathcal{B} Flock wall	acade <u>2</u> Linear Feet tage <u>John ²⁰</u> Linear Feet Top of Sign <u>/2</u> Feet Clea om all Existing Off-Premise Signs v	rance to Grade <u>6</u> Feet				

Applicant's Signature

B-10.95 Kathy Portm Date Approved By <u>, 15</u> Date 8

Wester Veon 2950/60 495 Industrem 242-7843 Iding Facade Iding Facade Street Frontage
lding Facade Street Frontage
Feet x Street Frontage of Building Facade 300 Square Feet or < 15 Square Feet ed [] Non-Illuminated
Frade Feet Feet Feet
FOR OFFICE USE ONLY: Signage Allowed on Parcel Building <u>62</u> Sq Ft Free-Standing <u>300</u> Sq Ft Fotal Allowed: <u>300</u> Sq Ft
) I I I I I I

Applicant's Signature

<u>8-1095</u> Date

hatly lot m Approved By

	SIGN PERMIT Community Development Department 250 North 5th Street Grand Junction, CO 81501 (303) 244-1430	PERMIT NO Date Submitted $\underline{\$ - 10.9\$}$ FEE $\$ _ 5.00$ Tax Schedule $2945 - 142 - 02 - 013$ Zone $\underline{(-2)}$
BUSINESS NAME STREET ADDRESS PROPERTY OWNER OWNER ADDRESS	201 NORth Ave LICEN DiAmond Shamlon ADDR	RACTOR WOSTATN NORM ISE NO 2950/60 ESS 2495 Endustrial PHONENO 242-7843
 [X] 1. FLUSH W [] 2. ROOF [] 3. FREE-STA [] 4. PROJECT [] 5. OFF-PRE 	ANDING 2 Square Feet per Linear ANDING 2 Traffic Lanes - 0.75 So4 or more Traffic Lanes FING 0.5 Square Feet per each MISE See #3 Spacing Requirer	 Foot of Building Facade Foot of Building Facade quare Feet x Street Frontage 1.5 Square Feet x Street Frontage Linear Foot of Building Facade nents; Not > 300 Square Feet or < 15 Square Feet Illuminated [] Non-Illuminated
L J Externally Illu		
 (1,2,4) Building F (1 - 4) Street From (2,4,5) Height to 7 	roposed Sign $\frac{1025}{25}$ Square Fee Facade $\frac{273}{25}$ Linear Feet Intage Linear Feet N	orth Ave. rance to Grade <u>15</u> Feet

Applicant's Signature

Kathy Pater Approved By <u>8-10.95</u> Date

5 Ďate

•				(B)			
GRAND JUN	SIGN PERMIT		PERMIT NO				
6			Date Submitted 8-1	0-95			
			FEE \$ 35.00				
COLORADO	250 North 5th Stre		Tax Schedule 2745-	-142-02-013			
	Grand Junction, C	O 81501	Zone <u>(</u>				
	(303) 244-1430						
BUSINESS NAME 0	Arrowed Sh.	Amrock CONTI	RACTOR West	a Near			
STREET ADDRESS	DOI WORTH	Ave LICEN		6/			
PROPERTY OWNER	D'Amoud	Shamoch ADDR	0.44	ides xeite			
OWNER ADDRESS	JOI NORTH	Ave TELEP	HONENO 2427	843			
<u></u>				·····			
1. FLUSH W			Foot of Building Facade				
[] 2. ROOF2 Square Feet per Linear Foot of Building Facade[] 3. FREE-STANDING2 Traffic Lanes - 0.75 Square Feet x Street Frontage							
	4 or more Traffic Lanes - 1.5 Square Feet x Street Frontage						
	[] 4. PROJECTING 0.5 Square Feet per each Linear Foot of Building Facade						
[] 5. OFF-PREM	MISE	See #3 Spacing Requirem	ents; Not > 300 Square Fee	t or < 15 Square Feet			
[] Externally Illur	ninated	[X] Internally	Illuminated	[] Non-Illuminated			
(1 - 5) Area of Pro	oposed Sign 🖌	20.25 Square Fee	t,				
	acade 303	Linear Feet	2'				
	tage 24013	7Linear Feet 2nd	51.				
(2,4,5) Height to Top of Sign /8 Feet Clearance to Grade /5 Feet							
(5) Distance from all Existing Off-Premise Signs within 600 Feet Feet							
			r				
Existing Signage/Ty	pe		FOR OFFICE	USE ONLY:			
E Free Sh	Auding	<u>/57</u> Sq Ft	Signage Allow	ved on Parcel			
A Fligh W	rall'	40 Sq Ft	Building	120 Sq Ft			
		Sq Ft	Free-Standing				
Tot	al Existing:	1	Total Allowed				
100							
COMMENTS:							


Applicant's Signature

10.95 Date

Approved By

5 <u>Date</u>

20° 400 Diamond Shamrock 2' 13.5' 10.25 Corner Store 18" 151 10' Car Wash 18"

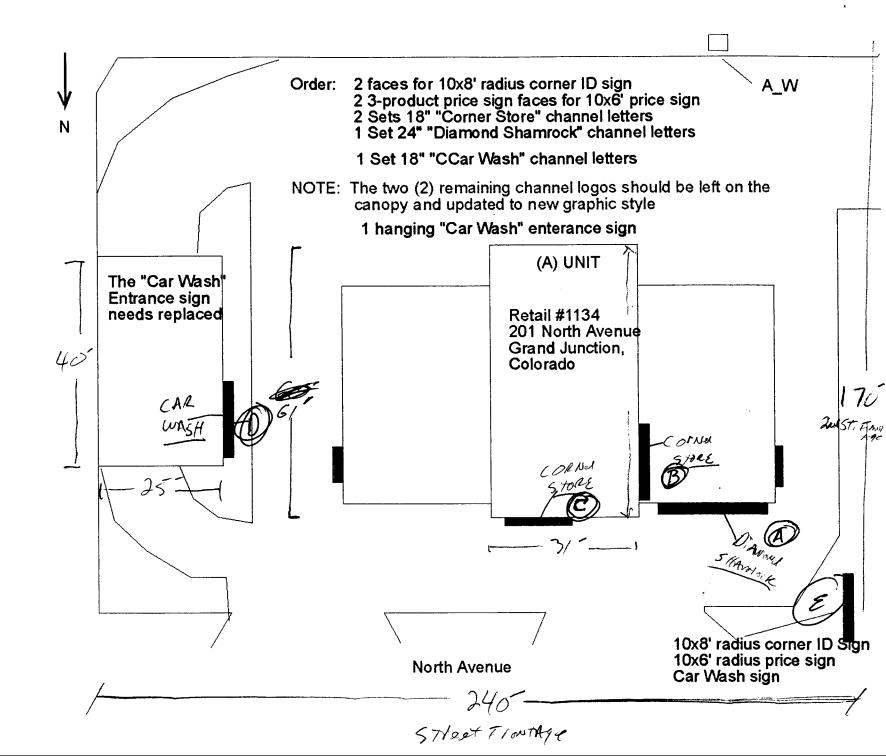

 $-\lambda$