


Ipswich Inn
 2222 North Ave
 Grand Tct. Co. 81501
 245-124-00-020

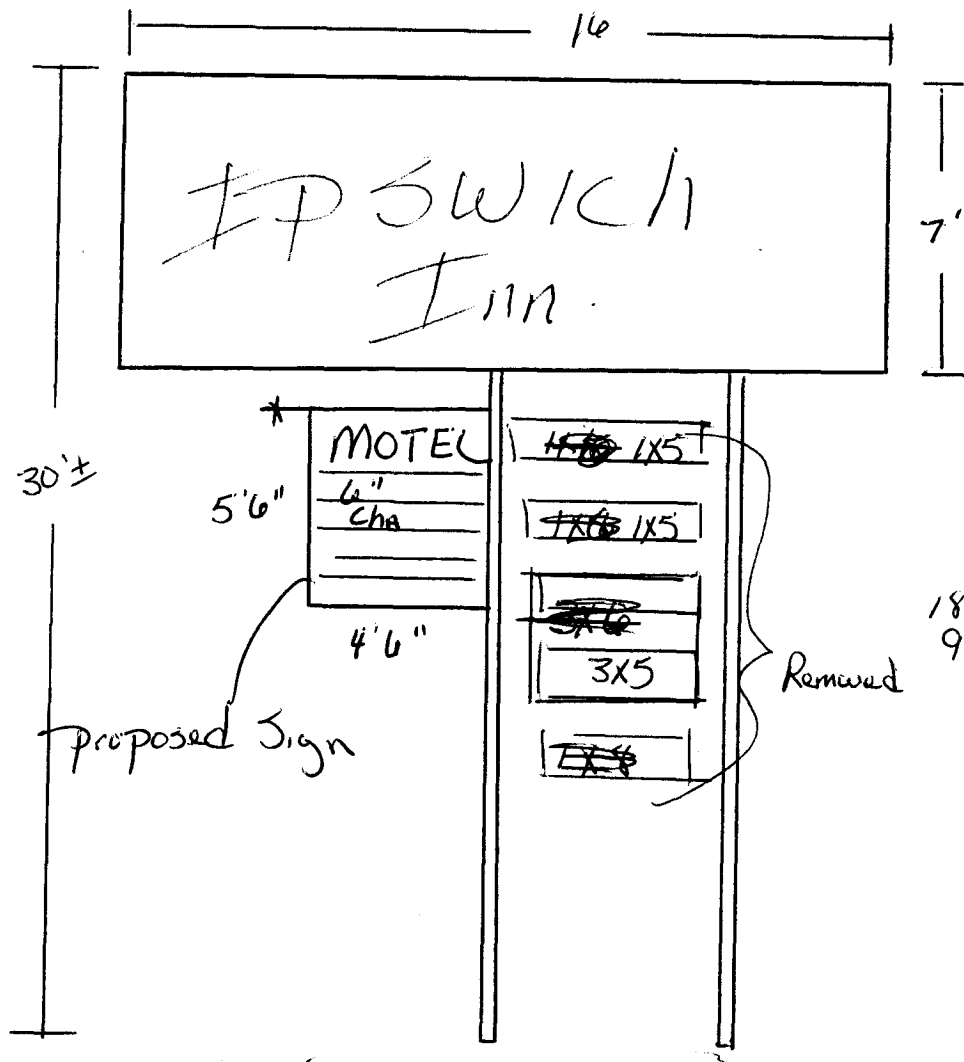

188 x 1.5 = 282 F3
 92 x 2 = 184 Fw

2222 North Ave

