

PERMIT NO		
Date Submitted	8-8-99	
FEE \$	<u>00 </u>	
Tax Schedule	2945-1	53-00-103
Zone/_		

BUSINESS NAME Di Amoud So	ham lock CONTRACTOR	Western Near	
STREET ADDRESS 2525 B	LICENSE NO	2950/60	
^	5h Am Mode ADDRESS	2415 Industrial	
OWNER ADDRESS 2525 By	TELEPHONE	10 2427843	
	•		
-V-			
1. FLUSH WALL	2 Square Feet per Linear Foot of	•	
[] 2. ROOF	2 Square Feet per Linear Foot of	•	
[] 3. FREE-STANDING	3. FREE-STANDING 2 Traffic Lanes - 0.75 Square Feet x Street Frontage		
[] 4. PROJECTING	4 or more Traffic Lanes - 1.5 Square Feet x Street Frontage ING 0.5 Square Feet per each Linear Foot of Building Facade		
[] 5. OFF-PREMISE		ot > 300 Square Feet or < 15 Square Feet	
[] S. OIT REWISE	oce #3 opacing requirements, re-	or > 300 square reet of < 13 square reet	
[] Externally Illuminated	Internally Illumin	nated [] Non-Illuminated	
(1 - 5) Area of Proposed Sign	46 Square Feet		
(1,2,4) Building Facade 60	Linear Feet		
(1 - 4) Street Frontage 300	Linear Feet Brondway	,	
` '	Feet Clearance t	/	
(2,4,5) Height to Top of Sign			
(5) Distance from all Existing	g Off-Premise Signs within 6	00 Feet Feet	
Existing Signage/Type	•	FOR OFFICE USE ONLY:	
E) Free STANDING	Sq Ft	Signage Allowed on Parcel	
(1) / W	10	ih a	
\mathcal{G} \mathcal{F} \mathcal{U}		Building /20 Sq Ft	
	Sq Ft	Free-Standing 450 Sq Ft	
Total Existing:	Sq Ft	Total Allowed: 450 Sq Ft	
	158	700	
COMMENTS:	1~8		
		permit is required for each sign. Attach	
a sketch of proposed and existing signage including types, dimensions, lettering, abutting streets, alleys,			
easements, property lines, and locations. All signs require a separate permit from the Building			
Department.			
1/11/	0 0 0 12	0 1	
(154/1	8-8-95 L.W.	. Vad. 8/9/9/	
Applicant's Signature	Poto Park	Provid Pr	



PERMIT NO	V
Date Submitted	8-8.95
FEE \$ <u>5.00</u>	
Tax Schedule	2945-153-00-103
Zone/	

BUSINESS NAME DiAmond So	hamlock CONTRACTOR	Wasten dear	
STREET ADDRESS 25 25 5	LICENSE NO	2950160	
PROPERTY OWNER Diamond	Shancock ADDRESS	2495 Tridustrial	
OWNER ADDRESS 25 25 Br	ord cure TELEPHONEN	_	
			
1. FLUSH WALL	2 Square Feet per Linear Foot of	Building Facade	
[] 2. ROOF	2 Square Feet per Linear Foot of Building Facade		
[] 3. FREE-STANDING	2 Traffic Lanes - 0.75 Square Feet x Street Frontage		
I 1 4 DDOJECTING	4 or more Traffic Lanes - 1.5 Squ	_	
[] 4. PROJECTING	0.5 Square Feet per each Linear I		
[] 5. OFF-PREMISE	See #3 Spacing Requirements; No	ot > 300 Square Feet or < 15 Square Feet	
[] Externally Illuminated	[X] Internally Illumir	noted [] Non Illuminated	
	M) Internally mullin	nated [] Non-Illuminated	
(1 - 5) Area of Proposed Sign	46 Square Feet		
· · ·	2 Linear Feet		
	25 Linear Feet mon. Rd.		
(1 - 4) Street Frontage	フレー・		
(2,4,5) Height to Top of Sign	Feet Clearance to	Grade /8 Feet	
(5) Distance from all Existing	g Off-Premise Signs within 6	00 Feet Feet	
Existing Signage/Type		FOR OFFICE USE ONLY:	
A	Margary		
1/10e STANDAU	Sq Ft	Signage Allowed on Parcel	
A Flush wall	Sq Ft	Building 67 Sq Ft	
6) AU	18 Sq Ft	Free-Standing 168 Sq Ft	
	100		
Total Existing:	Sq Ft	Total Allowed: //// Sq Ft	
COMMENTS	/8		
COMMENTS:			
NOTE: No sign may exceed 300 s	quare feet. A separate sign r	permit is required for each sign. Attach	
a sketch of proposed and existing signage including types, dimensions, lettering, abutting streets, alleys,			
easements, property lines, and locations. All signs require a separate permit from the Building			
Department.			
/1/_ ////	DOS WAL	and alane	
1/7 fely	8-695 Kathy	1811m 8/9/95	
Applicant's Signature	Date 'App	roved By / Date	




PERMIT NO	
Date Submitted 8-	8-95
FEE \$ 5,00	
Tax Schedule 29	45-153-00-103
Zone	

0	1		
BUSINESS NAME	hAmrock CONTRACTOR	Western New	
	LICENSE NO_	2950160	
PROPERTY OWNER	Sh Armsock ADDRESS	2495 INDUSTRIAL	
OWNER ADDRESS 255 Bloom	duay TELEPHONEN	0_242.7843	
1. FLUSH WALL	2 Square Feet per Linear Foot of	Building Facade	
[] 2. ROOF	2 Square Feet per Linear Foot of		
[] 3. FREE-STANDING	2 Traffic Lanes - 0.75 Square Feet x Street Frontage		
I I A DROWGERNIC	4 or more Traffic Lanes - 1.5 Square Feet x Street Frontage		
[] 4. PROJECTING	0.5 Square Feet per each Linear I	_	
[] 5. OFF-PREMISE	See #3 Spacing Requirements; No	ot > 300 Square Feet or < 15 Square Feet	
[] Externally Illuminated	Internally Illumin	nated [] Non-Illuminated	
(1 - 5) Area of Proposed Sign	/8 Square Feet		
(1,2,4) Building Facade 60	Linear Feet Broadway		
(1-4) Street Frontage 300	Linear Feet		
(2,4,5) Height to Top of Sign	-/2 Feet Clearance to	o Grade / Feet	
	g Off-Premise Signs within 6		
(5) Distance from all Existing	; On-1 lemise signs whim o	oo reetreet	
Existing Signage/Type	4.	FOR OFFICE USE ONLY:	
(E) Free Standing	Sq Ft	Signage Allowed on Parcel	
D Clock to the	Sq Ft	Building 120 Sq Ft	
T/ /	110	11/0	
12) Prost wall	Sq Ft	Free-Standing 430 Sq Ft	
Total Existing:	Sq Ft	Total Allowed: <u>450</u> Sq Ft	
D Fush Wall	46		
COMMENTS:	86		
		permit is required for each sign. Attach	
a sketch of proposed and existing signage including types, dimensions, lettering, abutting streets, alleys,			
easements, property lines, and locations. All signs require a separate permit from the Building			
Department.			
	11 1/4	0//////////////////////////////////////	
(19 thlul	8/8/98 Kath	4 Portre 8/9/95	
Applicant's Signature	Date App	roved By Date	
l	•	-	



PERMIT NO.	
Date Submitted 48/75	
FEE \$ <u>5.00</u> Tax Schedule <u>1945-/53</u>	0-103
Zone('-/	

BUSINESS NAME / Amoud	5/HAMTOCK CONT	RACTOR # W	exten dear
STREET ADDRESS 2505 1	LICEN LICEN	NSENO 295 a	160
PROPERTY OWNER DAMONS	Sh Annock ADDR	RESS 2495	IndustRIAL About
OWNER ADDRESS 2525	Stondary TELE	PHONENO 242-7	843
	(
1. FLUSH WALL	2 Squara Fact per Linea	r Foot of Building Facade	
1 2. ROOF		-	
[] 3. FREE-STANDING	2 Square Feet per Linear Foot of Building Facade2 Traffic Lanes - 0.75 Square Feet x Street Frontage		
		- 1.5 Square Feet x Street F	rontage
[] 4. PROJECTING	0.5 Square Feet per each	Linear Foot of Building Fac	cade
[] 5. OFF-PREMISE	See #3 Spacing Requirer	nents; Not > 300 Square Fe	et or < 15 Square Feet
[] Externally Illuminated	Internally	Illuminated	[] Non-Illuminated
(1 - 5) Area of Proposed Sign	/8 Square Fee	of	
` ' -	32Linear Feet m		
(1,2,4) Building Facade		640 <i>FC</i> .	
(1 - 4) Street Frontage 225	Linear Feet	//	^-
$(2,4,5)$ Height to Top of Sign $\underline{}$	Feet Clea	rance to Grade	Feet
(5) Distance from all Existing	g Off-Premise Signs v	vithin 600 Feet	Feet
		 	
Existing Signage/Type	140 59 FT.	FOR OFFICE	E USE ONLY:
A Flush hards	46 Sq Ft	Signage Alloy	wed on Parcel
e that well			//
B Hish wall	<u>46</u> Sq Ft	Building <u>(</u>	Sq Ft
e Plush wall	Sq Ft	Free-Standing	g / / / Sq Ft
Total Existing:	Sq Ft	Total Allowe	d: //e X Sq Ft
<u> </u>	Hla		
COMMENTS:			
NOTE: No sign may exceed 300 s	square feet A senarat	e sion nermit is require	d for each sign Attach
a sketch of proposed and existing s			
easements, property lines, and lo			
Department.			
1/11/		, ,	
///////////////////////////////////////	ckha i	Val. Ward	alalaz
17kg	0/0/75	arry form	× 8/9/95
Applicant's Signature	/ Datte	Approved By	/ Date

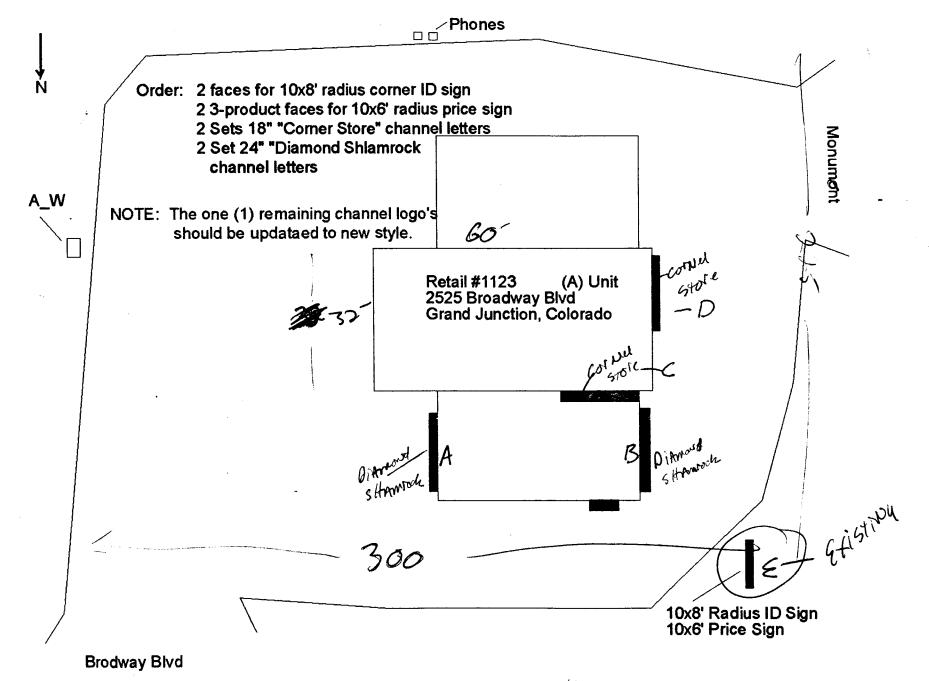

Dismond Shamrock 2

Gorner Store 18"

(Sinus 240)