



SIGN PERMIT

Community Development Department
 250 North 5th Street
 Grand Junction, CO 81501
 (970) 244-1430

Permit No. _____
 Date Submitted 5-3-96
 FEE \$ 25.00 + 100.00
 Tax Schedule 2945-124-19-023
 Zone C-1

BUSINESS NAME HOLLYWOOD CLIPS CONTRACTOR SIGNS FIRST
 STREET ADDRESS 1123 NORTH 23RD ST. LICENSE NO. 2960975
 PROPERTY OWNER _____ ADDRESS 750 NORTH AVE.
 OWNER ADDRESS _____ TELEPHONE NO. 256-1877

1. FLUSH WALL 2 Square Feet per Linear Foot of Building Facade
Face Change Only (2,3 & 4):
 2. ROOF 2 Square Feet per Linear Foot of Building Facade
 3. FREE-STANDING 2 Traffic Lanes - 0.75 Square Feet x Street Frontage
 4 or more Traffic Lanes - 1.5 Square Feet x Street Frontage
 4. PROJECTING 0.5 Square Feet per each Linear Foot of Building Facade

Existing Externally or Internally Illuminated - No Change in Electrical Service Non-Illuminated

- (1 - 4) Area of Proposed Sign 32 Square Feet
 (1,2,4) Building Facade 24 Linear Feet
 (1 - 4) Street Frontage 106.2 Linear Feet
 (2,4) Height to Top of Sign 11 Feet Clearance to Grade 7 Feet

Existing Signage/Type:	
<u>MARQUE (PROJECTING)</u>	<u>15</u> Sq. Ft.
	Sq. Ft.
	Sq. Ft.
Total Existing:	<u>15</u> Sq. Ft.

● FOR OFFICE USE ONLY ●		
Signage Allowed on Parcel:		
Building	<u>48</u>	Sq. Ft.
Free-Standing	<u>78</u>	Sq. Ft.
Total Allowed:	<u>78</u>	Sq. Ft.

COMMENTS: ATTACHED SITE PLAN IS INSUFFICIENT TO UNDERSTAND PROPOSAL BUT SINCE THE SIGN HAS ALREADY BEEN INSTALLED THERE IS LITTLE POINT IN CHANGING IT.



NOTE: No sign may exceed 300 square feet. A separate sign permit is required for each sign. Attach a sketch of proposed and existing signage including types, dimensions, lettering, abutting streets, alleys, easements, property lines, and locations.

[Signature] 5/3/96 Bill Nehl 5-9-96
 Applicant's Signature Date Community Development Approval Date

(White: Community Development)


(Canary: Applicant)

(Pink: Code Enforcement)

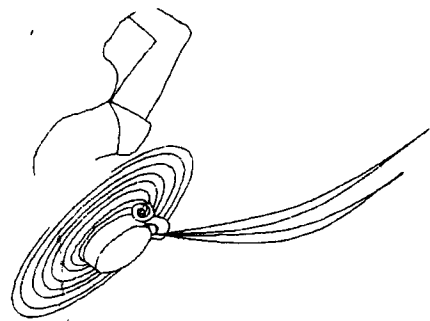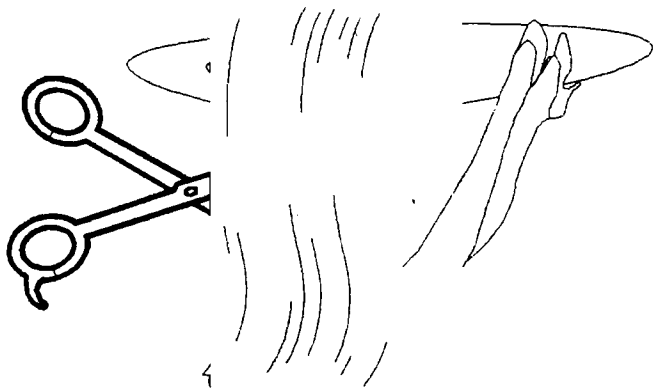

DOOLLYWOOD
CLIPS

SOUTH SIDE OF BUILDING

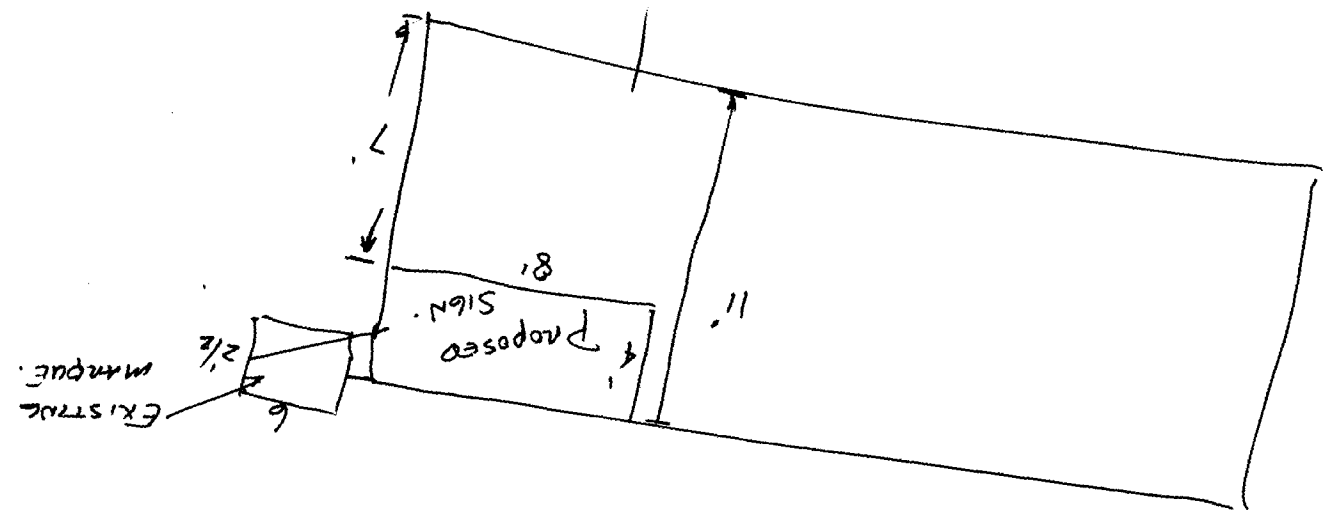

EXISTING MARQUE

Proposed SIGN

2 1/2'

6

8'

11'

7'