



SIGN CLEARANCE

Community Development Department
250 North 5th Street
Grand Junction, CO 81501
(970) 244-1430

Clearance No. _____
Date Submitted 4/17/96 ✓
FEE \$ 25⁰⁰
Tax Schedule 2945-134-03-050
Zone C-2

BUSINESS NAME ULTRA-BOND
STREET ADDRESS 2458 I-70B
PROPERTY OWNER _____
OWNER ADDRESS _____

CONTRACTOR SIGNS FIRST
LICENSE NO. 2960475
ADDRESS 950 NORTH AVE.
TELEPHONE NO. 256-1877 (BRIAN)

- 1. FLUSH WALL 2 Square Feet per Linear Foot of Building Facade
- 2. ROOF 2 Square Feet per Linear Foot of Building Facade
- 3. FREE-STANDING 2 Traffic Lanes - 0.75 Square Feet x Street Frontage
4 or more Traffic Lanes - 1.5 Square Feet x Street Frontage
- 4. PROJECTING 0.5 Square Feet per each Linear Foot of Building Facade
- 5. OFF-PREMISE See #3 Spacing Requirements; Not > 300 Square Feet or < 15 Square Feet

Externally Illuminated Internally Illuminated Non-Illuminated

- 1 - 5) Area of Proposed Sign 40 Square Feet
- (1,2,4) Building Facade _____ Linear Feet
- (1 - 4) Street Frontage 108⁴ Linear Feet
- (2,4,5) Height to Top of Sign 23 Feet Clearance to Grade 14 Feet
- (5) Distance from all Existing Off-Premise Signs within 600 Feet 200 Feet NA

Existing Signage/Type: <u>FREE STANDING</u>	
<u>OSBORN & SONS.</u>	<u>32</u> Sq. Ft.
	Sq. Ft.
	Sq. Ft.
Total Existing:	<u>32</u> Sq. Ft.

● FOR OFFICE USE ONLY ●	
Signage Allowed on Parcel:	
Building	<u>Unknown</u> Sq. Ft.
Free-Standing	<u>162</u> Sq. Ft.
Total Allowed:	<u>Unknown</u> Sq. Ft.

COMMENTS: PROPOSED SIGN WILL ATTACH TO TOP OF EXISTING PER LAYOUT.



NOTE: No sign may exceed 300 square feet. A separate sign clearance is required for each sign. Attach a sketch of proposed and existing signage including types, dimensions, lettering, abutting streets, alleys, easements, property lines, and locations. **A SEPARATE PERMIT FROM THE BUILDING DEPARTMENT IS REQUIRED.**

[Signature] 4/17/96 [Signature] 4/19/96
 Applicant's Signature Date Community Development Approval Date
 (White: Community Development) (Canary: Applicant) (Pink: Building Dept) (Goldenrod: Code Enforcement)

WINDSHIELD



NOT REPLACEMENT!

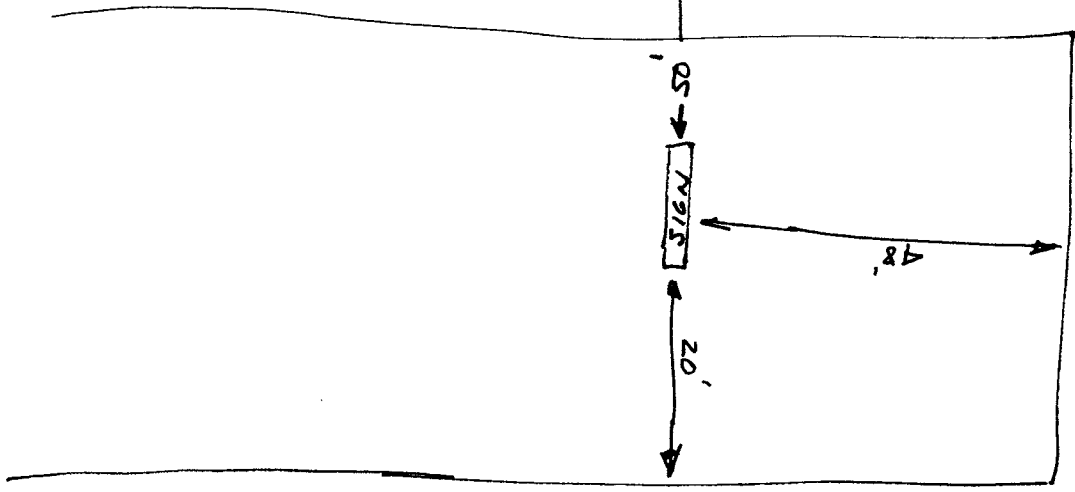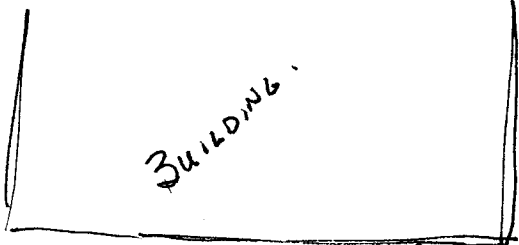

DRIVE
ENTRY

FRONTAGE
ROAD

