



SIGN PERMIT

Community Development Department
 250 North 5th Street
 Grand Junction, CO 81501
 (970) 244-1430

Permit No. _____
 Date Submitted 6-9-97
 FEE \$ 25.00
 Tax Schedule 2945-151-00-0012
 Zone C-2

BUSINESS NAME MECHANICAL INSULATION SUPPLY CO CONTRACTOR PLATINUM SIGNS
 STREET ADDRESS 827 N. 1ST STREET LICENSE NO. 2970732
 PROPERTY OWNER SCOTT HOWARD ADDRESS _____
 OWNER ADDRESS 422 BRACH DRIVE 81503 TELEPHONE NO. 970-523-7682

1. FLUSH WALL 2 Square Feet per Linear Foot of Building Facade
Face Change Only (2,3 & 4):
 2. ROOF 2 Square Feet per Linear Foot of Building Facade
 3. FREE-STANDING 2 Traffic Lanes - 0.75 Square Feet x Street Frontage
 4 or more Traffic Lanes - 1.5 Square Feet x Street Frontage
 4. PROJECTING 0.5 Square Feet per each Linear Foot of Building Facade

Existing Externally or Internally Illuminated - No Change in Electrical Service Non-Illuminated

- (1 - 4) Area of Proposed Sign 32' Square Feet
 (1,2,4) Building Facade 100'51 Linear Feet
 (1 - 4) Street Frontage 60' Linear Feet
 (2,4) Height to Top of Sign _____ Feet Clearance to Grade _____ Feet

Existing Signage/Type:	Sq. Ft.
	Sq. Ft.
	Sq. Ft.
	Sq. Ft.
Total Existing:	<u>0</u> Sq. Ft.

● FOR OFFICE USE ONLY ●		
Signage Allowed on Parcel:	<u>1st Street</u>	
Building	<u>102</u>	Sq. Ft.
Free-Standing	<u>90</u>	Sq. Ft.
Total Allowed:	<u>102</u>	Sq. Ft.

COMMENTS: _____

NOTE: No sign may exceed 300 square feet. A separate sign permit is required for each sign. Attach a sketch of proposed and existing signage including types, dimensions, lettering, abutting streets, alleys, easements, property lines, and locations.

[Signature] Applicant's Signature 6-9-97 Date [Signature] Community Development Approval 6/10/97 Date
 (White: Community Development) (Canary: Applicant) (Pink: Code Enforcement)

#B

2 of 3



SIGN PERMIT

Community Development Department
250 North 5th Street
Grand Junction, CO 81501
(970) 244-1430

Permit No. _____
Date Submitted 6-9-97
FEE \$ 500
Tax Schedule 2945-151-00-012
Zone C-2

BUSINESS NAME MECHANICAL INSULATION SUPPLY CO CONTRACTOR PLATINUM SIGNS
STREET ADDRESS 827 N. 1ST LICENSE NO. 2970752
PROPERTY OWNER SCOTT HOWARD ADDRESS _____
OWNER ADDRESS 422 BRACH DR TELEPHONE NO. 970 523 7682
81503

- 1. FLUSH WALL 2 Square Feet per Linear Foot of Building Facade
- Face Change Only (2,3 & 4):
- 2. ROOF 2 Square Feet per Linear Foot of Building Facade
- 3. FREE-STANDING 2 Traffic Lanes - 0.75 Square Feet x Street Frontage
4 or more Traffic Lanes - 1.5 Square Feet x Street Frontage
- 4. PROJECTING 0.5 Square Feet per each Linear Foot of Building Facade

Existing Externally or Internally Illuminated - No Change in Electrical Service Non-Illuminated

(1 - 4) Area of Proposed Sign 32' Square Feet
(1,2,4) Building Facade 54' Linear Feet
(1 - 4) Street Frontage 60 Linear Feet
(2,4) Height to Top of Sign _____ Feet Clearance to Grade _____ Feet

Existing Signage/Type:	
FLUSH WALL SOUTH SIDE	32 Sq. Ft.
	Sq. Ft.
	Sq. Ft.
Total Existing:	32 Sq. Ft.

● FOR OFFICE USE ONLY ●		
Signage Allowed on Parcel:	<u>1st Street</u>	
Building	<u>102</u>	Sq. Ft.
Free-Standing	<u>90</u>	Sq. Ft.
Total Allowed:	<u>102</u>	Sq. Ft.

COMMENTS:

NOTE: No sign may exceed 300 square feet. A separate sign permit is required for each sign. Attach a sketch of proposed and existing signage including types, dimensions, lettering, abutting streets, alleys, easements, property lines, and locations.

[Signature] 6-9-97 [Signature] 6/10/97
Applicant's Signature Date Community Development Approval Date

(White: Community Development) (Canary: Applicant) (Pink: Code Enforcement)

#C



SIGN PERMIT

Community Development Department
250 North 5th Street
Grand Junction, CO 81501
(970) 244-1430

Permit No. _____
Date Submitted 6-9-97
FEE \$ 500
Tax Schedule 2945-151-00-012
Zone C-2

BUSINESS NAME Mechanical Insulation Supply Co CONTRACTOR PLATINUM SIGNS
STREET ADDRESS 827 N. 1st. LICENSE NO. 2970732
PROPERTY OWNER SCOTH HOWARD ADDRESS _____
OWNER ADDRESS 822 BRACH DR TELEPHONE NO. 970 523 7682
81503

- 1. FLUSH WALL 2 Square Feet per Linear Foot of Building Facade
- Face Change Only (2,3 & 4):
- 2. ROOF 2 Square Feet per Linear Foot of Building Facade
- 3. FREE-STANDING 2 Traffic Lanes - 0.75 Square Feet x Street Frontage
4 or more Traffic Lanes - 1.5 Square Feet x Street Frontage
- 4. PROJECTING 0.5 Square Feet per each Linear Foot of Building Facade

Existing Externally or Internally Illuminated - No Change in Electrical Service Non-Illuminated

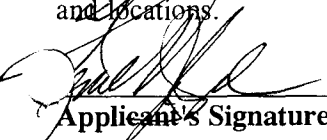

- (1 - 4) Area of Proposed Sign 32 Square Feet
- (1,2,4) Building Facade 100' SA Linear Feet
- (1 - 4) Street Frontage 60 Linear Feet
- (2,4) Height to Top of Sign _____ Feet Clearance to Grade _____ Feet

Existing Signage/Type:		
FLUSH WALL	SOUTH SIDE	32 Sq. Ft.
FLUSH WALL	WEST SIDE	32 Sq. Ft.
		Sq. Ft.
Total Existing:		64 Sq. Ft.

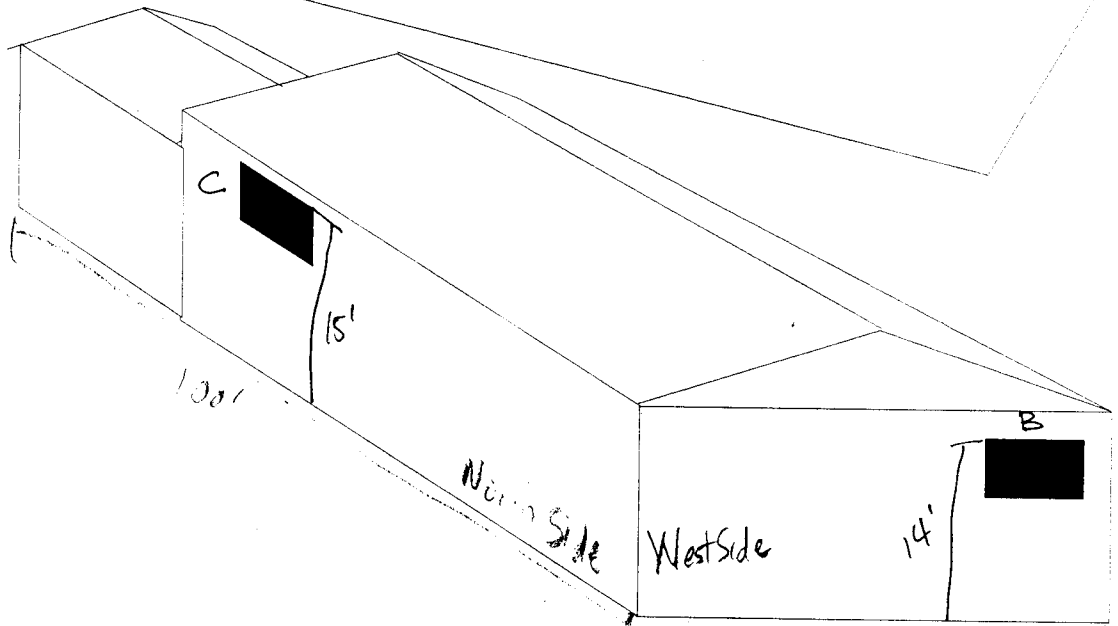
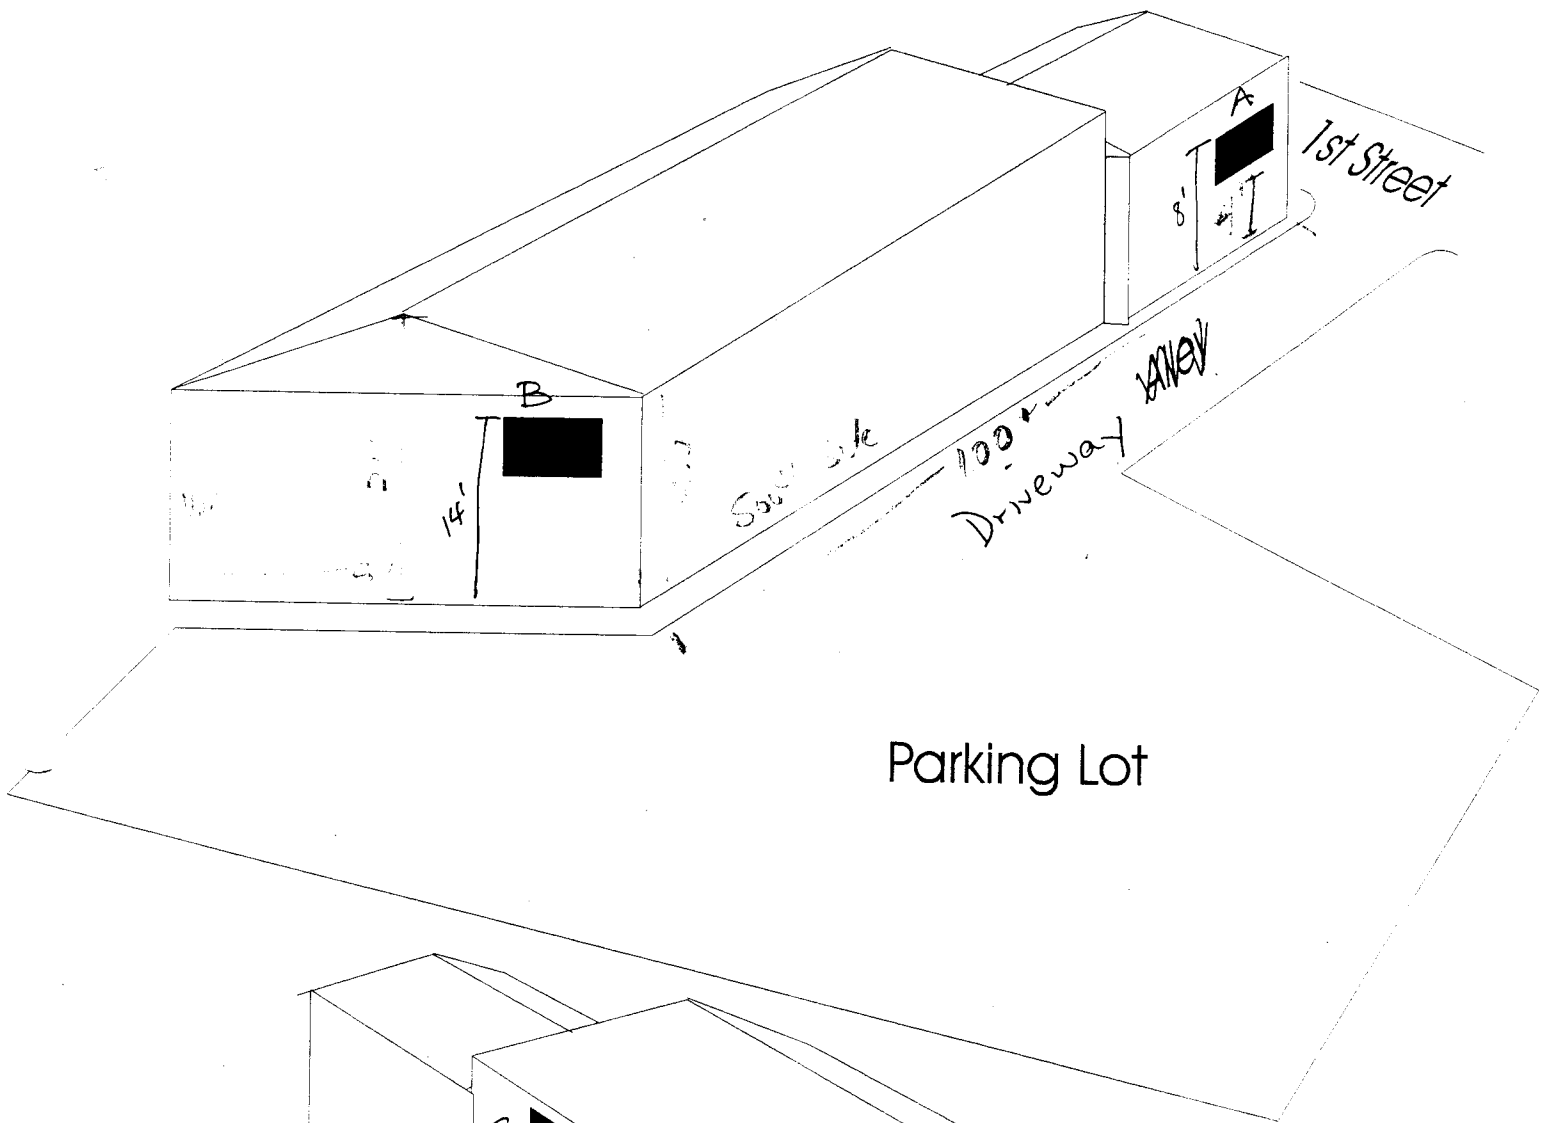
● FOR OFFICE USE ONLY ●	
Signage Allowed on Parcel:	<u>1st Street</u>
Building	<u>102</u> Sq. Ft.
Free-Standing	<u>90</u> Sq. Ft.
Total Allowed:	<u>102</u> Sq. Ft.

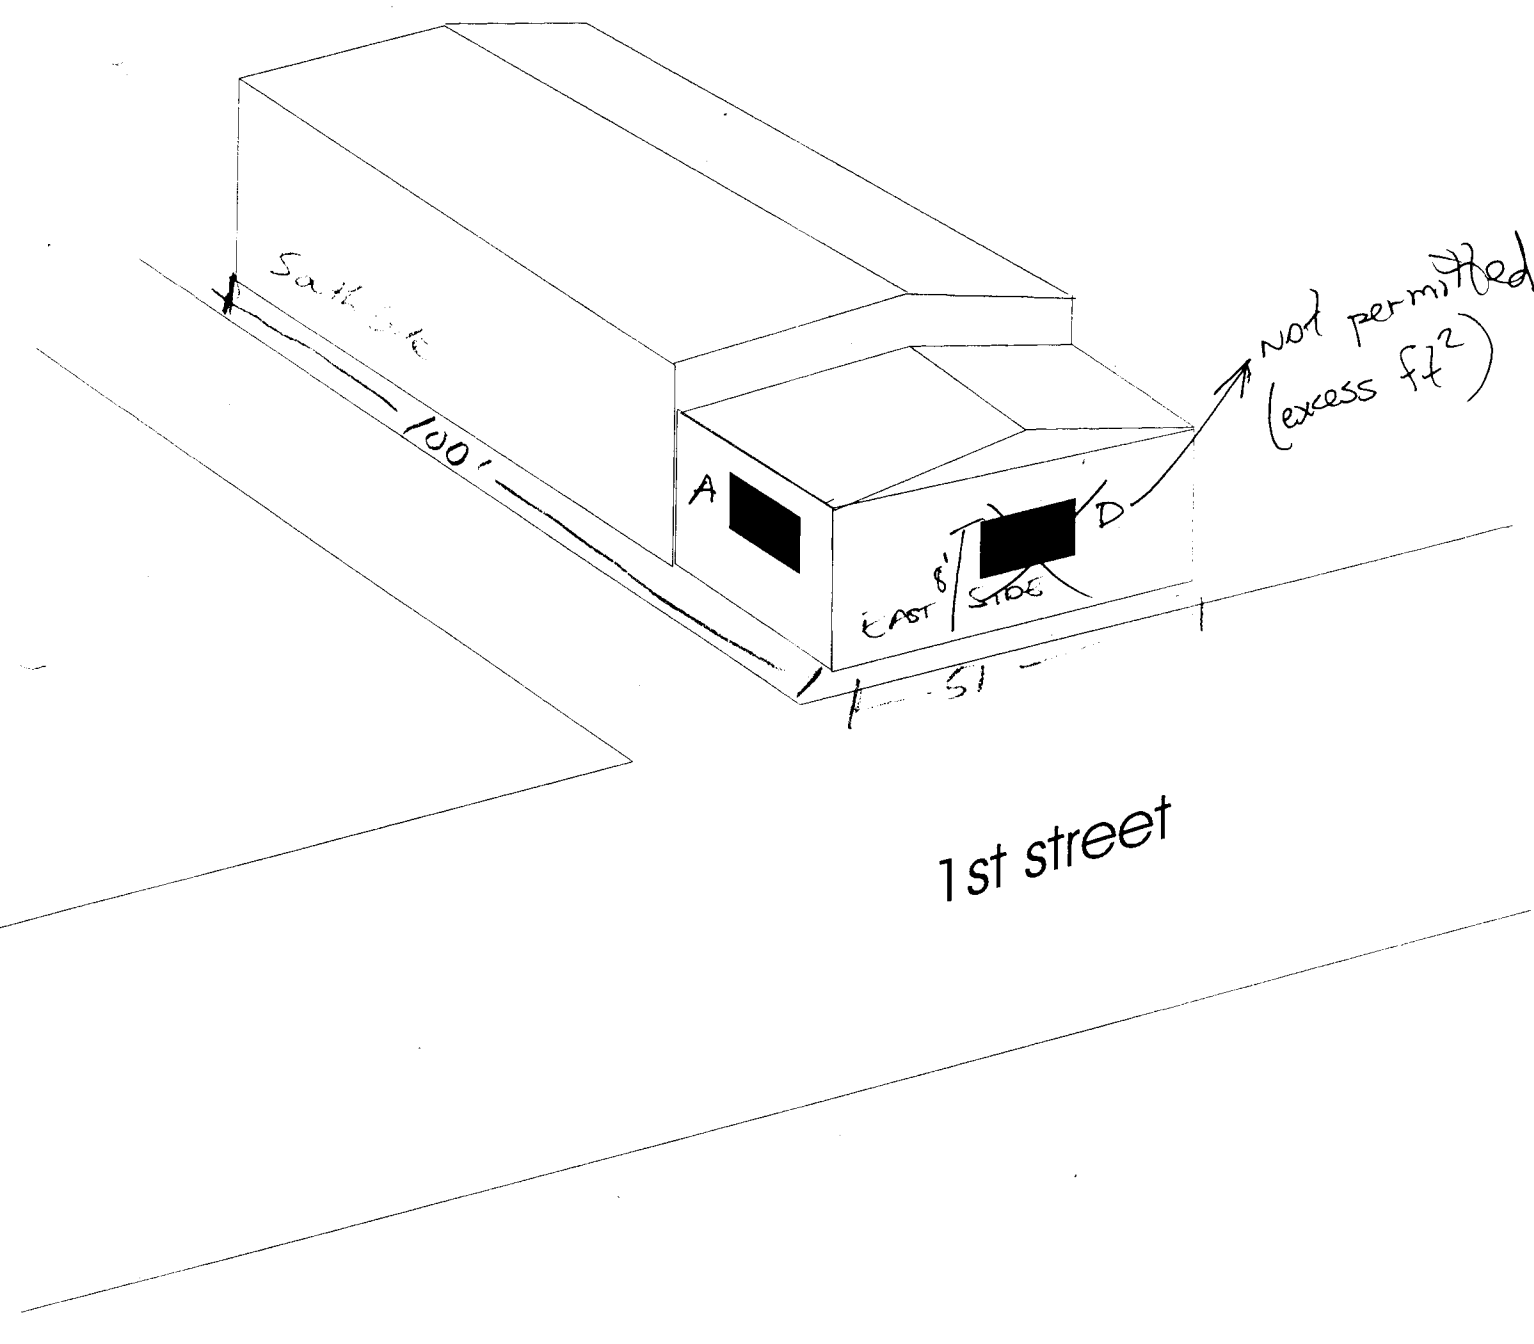
COMMENTS:

NOTE: No sign may exceed 300 square feet. A separate sign permit is required for each sign. Attach a sketch of proposed and existing signage including types, dimensions, lettering, abutting streets, alleys, easements, property lines, and locations.


6-9-97

6/10/97

(White: Community Development) (Canary: Applicant) (Pink: Code Enforcement)





not permitted
(excess ft²)

1st street

60ft 1st street
8' 100'

8X7

1-800-711-6601

257-9492

**Mechanical
Insulation
Supply Co.**



Signs A, B, C, D ~~on~~ white background with Blue Letters
on Paint-Loc Metal