

(White: Community Development)

SIGN CLEARANCE

Community Development Department 250 North 5th Street Grand Junction, CO 81501 (970) 244-1430


	V
Clearance No.	59304
Date Submitted	2-24-97
FEE\$25.00	
Tax Schedule 26	97-364-00-061
Zone I-1	

(Goldenrod: Code Enforcement)

	(9/0) 244-1430	20						
-	· · · · · · · · · · · · · · · · · · ·							
STREE PROPE	ET ADDRESS 2173 (ERTY OWNER SCOT	XTRAILER SAKT RIVER RD, LOTI T MURDOCK RS LOVELAND CO 80537	LICENSE NO. 29 ADDRESS 2495	60490 5-Indu	STRAIL B.G			
[] 2 X 3 [] 4	1. FLUSH WALL 2. ROOF 3. FREE-STANDING 4. PROJECTING 5. OFF-PREMISE	2 Square Feet per Linear I 2 Square Feet per Linear I 2 Traffic Lanes - 0.75 Squ 4 or more Traffic Lanes - 0.5 Square Feet per each I	2 Square Feet per Linear Foot of Building Facade 2 Square Feet per Linear Foot of Building Facade 2 Traffic Lanes - 0.75 Square Feet x Street Frontage 4 or more Traffic Lanes - 1.5 Square Feet x Street Frontage 0.5 Square Feet per each Linear Foot of Building Facade See #3 Spacing Requirements; Not > 300 Square Feet or < 15 Square Feet					
[] Externally Illuminated	[X] Internally	Illuminated	[] N	on-Illuminated			
(1,2,4) (1 - 4) (2,4,5) (5)	Street Frontage 1680 Height to Top of Sign 2 Distance from all Existing 6		eet Feet	D OFFICE US	E ONLY O			
Exist	ing Signage/Type:	Ç _a		● FOR OFFICE USE ONLY ● Signage Allowed on Parcel:				
			. Ft. Signage Allow . Ft. Building		6 0 Sq. Ft.			
	Total Existing:		Ft. Free-Standing Total Allo	<u> </u>	1545 Sq. Ft.			
COM	MENTS:							
propo	sed and existing signage incl	square feet. A separate sign luding types, dimensions, lette RMIT FROM THE BUILD	ering, abutting streets, a	alleys, easemen	nts, property lines,			
-1.4	Do Allan	2-24-97	miles		2-26-97			
Appli	cant's Signature	Date Com	munity Development	Approval	Date			

(Pink: Building Dept)

(Canary: Applicant)

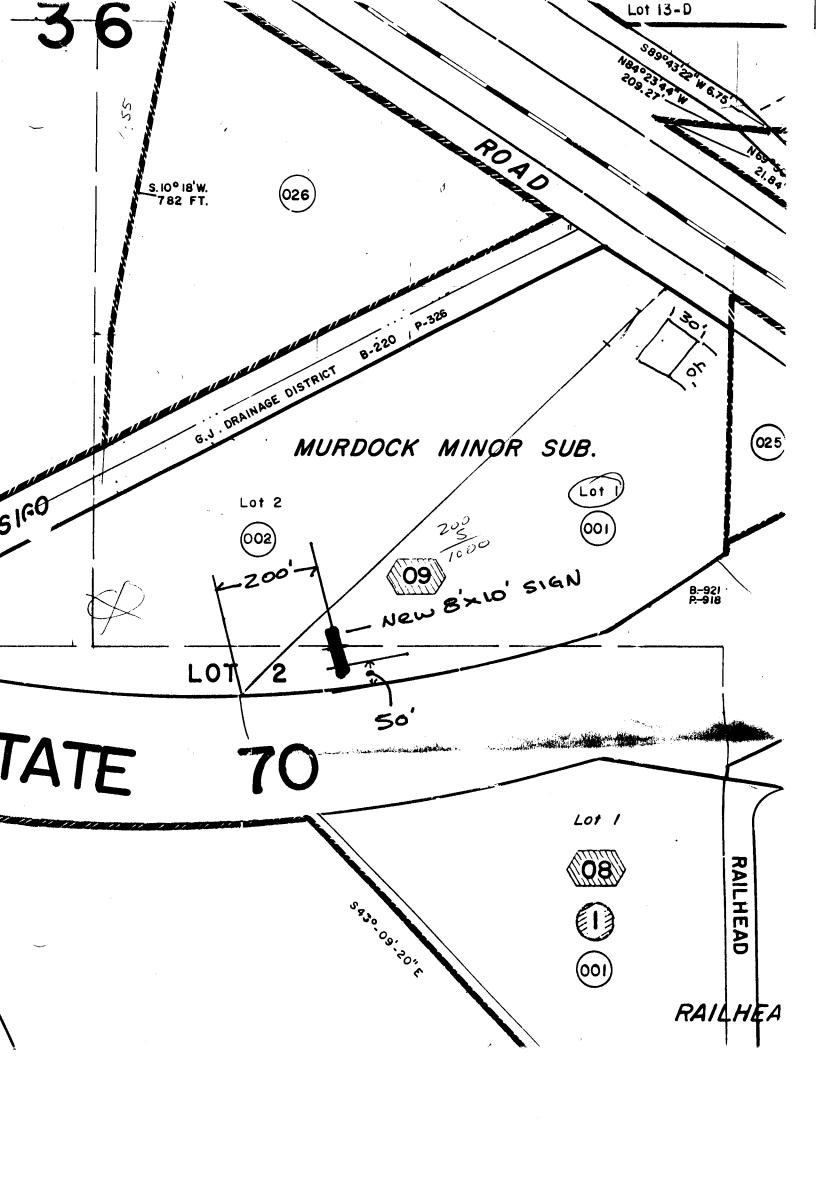



101

14' Above Grade