

Sign Permit

Community Development Department 250 North 5th Street Grand Junction, CO 81501 (970) 244-1430

\ \ \ \ \ \ \ \ \ \ \ \ \ \ \ \ \ \ \	
Permit No.	
Date Submitted <u>3-13-97</u>	
FEE \$ 5.00	
Tax Schedule 2943-073-17-00	7
7 one 1-1	

BUSINESS NAME AMERICA'S 7	BEST FIRMOUR	E CONTRA	ACTOR BUO'S SU	SUS		
STREET ADDRESS 2830 NON	TH AVE.		ENO. 2970109			
OPERTY OWNER BRAY & CO AD			ADDRESS 1055 UTE			
OWNER ADDRESS 1015 N. 1			TELEPHONE NO. 245-1100			
FLUSH WALL	2 Square Feet per	Linear Foot of B	Building Facade			
Face Change Only (2,3 & 4):						
[] 2. ROOF	2 Square Feet per Linear Foot of Building Facade					
3. FREE-STANDING		2 Traffic Lanes - 0.75 Square Feet x Street Frontage				
		-	re Feet x Street Frontage			
[] 4. PROJECTING	0.5 Square Feet p	er each Linear Fo	oot of Building Facade			
Existing Externally or Internally I	lluminated - No Cha	nge in Electrical	Service []	Non-Illuminated		
	€	e to Grade 19	Feet			
(1 - 4) Street Frontage	€	e to Grade _/9	Feet FOR OFFICE	CE USE ONLY ●		
(2,4) Height to Top of Sign	€	e to Grade/9 Sq. Ft.				
Existing Signage/Type:	€		● FOR OFFIC			
Existing Signage/Type:	€	Sq. Ft.	• FOR OFFICE Signage Allowed on Pa	rcel: NORTH AVE		
Existing Signage/Type:	€	Sq. Ft. Sq. Ft. Sq. Ft.	FOR OFFICE Signage Allowed on Pa	1,543 Sq. Ft.		
2,4) Height to Top of Sign Z Existing Signage/Type: see attached photo Total Existing:	Feet Clearance	Sq. Ft. Sq. Ft. Sq. Ft. Sq. Ft.	For OFFICE Signage Allowed on Pa Building Free-Standing Total Allowed:	1,543 Sq. Ft. 1,077.50Sq. Ft. 1,548 Sq. Ft.		








NEW LEXAN SIGN FACES 156" X 60"

TO BE INSTALLED IN EXISTING MARQUE SIGN (SAME COLOR SCHEME AS BUILDING SIGNAGE)







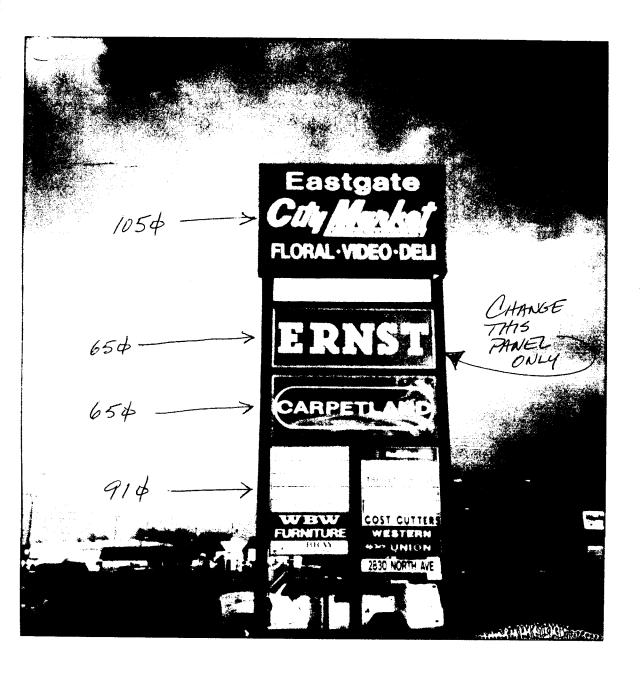

NEW FACE = 65 \$
WHOLE SIGN = 328 \$