



SIGN PERMIT

(A)

Community Development Department
250 North 5th Street
Grand Junction, CO 81501
(970) 244-1430

Permit No. _____
Date Submitted 5-18-98
FEE \$ 25
Tax Schedule 2945-113-19-005
Zone C-2

BUSINESS NAME Rescue Mission
~~MUNCHIES PIZZA~~
STREET ADDRESS 350 NORTH AVE
PROPERTY OWNER _____
OWNER ADDRESS _____

CONTRACTOR SIGN GALLERY
LICENSE NO. 2980251
ADDRESS 1048 INDEPENDENT AVE
TELEPHONE NO. 246-6400

- 1. FLUSH WALL 2 Square Feet per Linear Foot of Building Facade
- Face Change Only (2,3 & 4):
- 2. ROOF 2 Square Feet per Linear Foot of Building Facade
- 3. FREE-STANDING 2 Traffic Lanes - 0.75 Square Feet x Street Frontage
4 or more Traffic Lanes - 1.5 Square Feet x Street Frontage
- 4. PROJECTING 0.5 Square Feet per each Linear Foot of Building Facade

Existing Externally or Internally Illuminated - No Change in Electrical Service Non-Illuminated

(1 - 4) Area of Proposed Sign 103.5 Square Feet
(1,2,4) Building Facade 80 Linear Feet
(1 - 4) Street Frontage 100 Linear Feet
(2,4) Height to Top of Sign 20 Feet Clearance to Grade 12 Feet

NORTH AVENUE FRONTAGE

Existing Signage/Type:	
Flush Light	5.5 Sq. Ft.
Freestanding (Security Sign)	14 Sq. Ft.
Total Existing:	14 Sq. Ft.


● FOR OFFICE USE ONLY ●	
Signage Allowed on Parcel:	
Building	160 Sq. Ft.
Free-Standing	150 Sq. Ft.
Total Allowed:	160 Sq. Ft.

COMMENTS: MEASUREMENTS of BUILDING SIGN on NORTH AVE.

NOTE: No sign may exceed 300 square feet. A separate sign permit is required for each sign. Attach a sketch of proposed and existing signage including types, dimensions, lettering, abutting streets, alleys, easements, property lines, and locations.

[Signature] 5-11-98 [Signature] 5/19/98
Applicant's Signature Date Community Development Approval Date

(White: Community Development) (Canary: Applicant) (Pink: Code Enforcement)

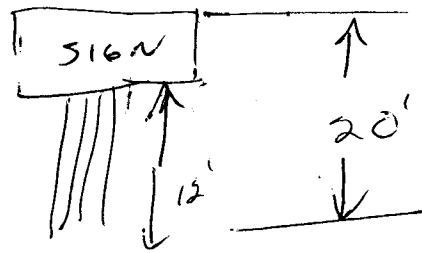

(A)

A
SMILING
FACE


MUNCHIES

PIZZA & DELI

255-9009 DELIVERY

@ HANGABLE POSITION **SPAGHETTI \$3.99**

KARAOKI FRI & SAT 9-12

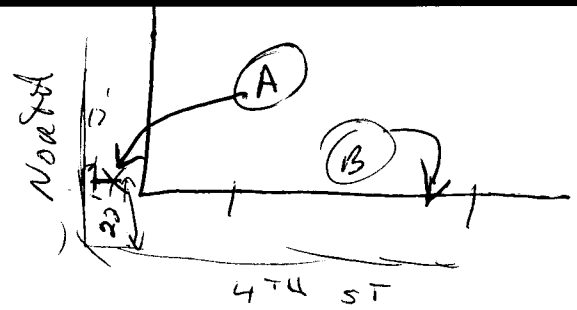

(A) SIGN POLES ARE SET BACK 17' FROM NORTH
1/2 22' FROM 4TH ST.

(B) PLUS SMALL SIGN


**RESCUE —
— MISSION**

DONATIONS ACCEPTED