


$S_{\text{IGN}} P_{\text{ERMIT}}$

Community Development Department 250 North 5th Street Grand Junction, CO 81501 (970) 244-1430

Permit No.			
Date Subr	nitted	7-28-9	8
FEE \$ Z	5.00		
Tax Sched	ule 29	45-09	418-001
	- 2 -		

				=			
RUSINESS NAI	ME 56525 R	D. COMPHEX	CONTD	ACTOR BUDS.	Sails		
STREET ADDRESS 565 25 ROAD			LICENSE NO. 2980109				
PROPERTY OWNER KEN GROGAN			ADDRESS 1055 UTE				
OWNER ADDRESS SAME				TELEPHONE NO. 245-7700			
		111 :	×:	#:	*		
[]1.	FLUSH WALL	2 Square Feet per Linear	Foot of E	Building Facade			
Face Change On [] 2.	<i>nly (2,3 & 4):</i> ROOF	2 Square Feet per Linear	D4 67	vitari, m			
1 1 2.	x Street Frontage						
<i>y</i> Ç3.	FREE-STANDING	ŭ					
[]4.	4 or more Traffic Lanes - 1.5 Square Feet x Street Frontage 1 4. PROJECTING 0.5 Square Feet per each Linear Foot of Building Facade						
		•					
[] Existing Ext	ternally or Internally Ill	uminated - No Change in F	lectrical	Service 🔀	Non-Illuminate	ed	
(1 - 4) Street	11	inear Feet inear Feet Feet Clearance to Gra	de <u></u>	Feet			
	Existing Signage/Type:			● FOR OFFICE USE ONLY ●			
Existing Signag	ge/Type:			● FOR OFFIC	E USE ONLY		
Existing Signage FMSH		## 60sq.	Ft.	• FOR OFFICE Signage Allowed on Part			
		Sq.				Sq. Ft.	
			Ft.	Signage Allowed on Par			
FrusH		Sq. 1	Ft.	Signage Allowed on Par Building		Sq. Ft.	
Total COMMENTS: NOTE: No si proposed and e and locations.	Existing: gn may exceed 300 squisting signage including the state of	Sq.	Ft. Ft. Ft. gn permiering, about the munity	Signage Allowed on Para Building Free-Standing Total Allowed: It is required for each soutting streets, alleys, each of the streets alleys all the streets all	ign. Attach a sements, prop	Sq. Ft. Sq. Ft. Sq. Ft. sketch of erty lines,	

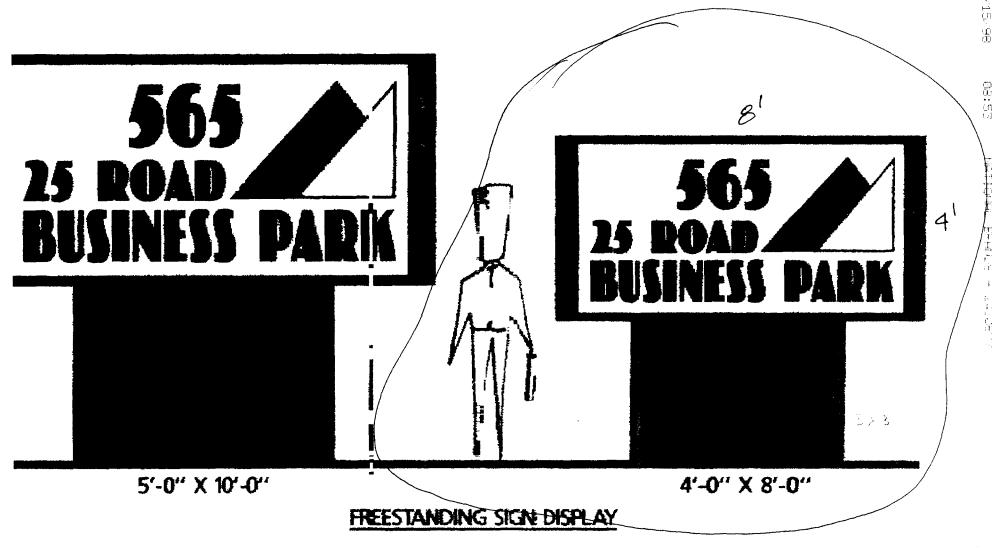

- NON ILLUMINATED SIGN
- TYPICAL SHEET METAL CABINET
- .125" DI-BONE: ALUMANUM FACES
- SHEET METAL BASE STUCCO BINISH /

Buo - Just wanted to confirm The 4x8 SIGN USING

LOGO AS Shown. PLEASE CONFER WITH GRES SCHAEFER
AS TO PLACEMENT Along 25 Rd. Thanks VE. 1 PR FTA.??

