



(A)

SIGN CLEARANCE

Community Development Department
250 North 5th Street
Grand Junction, CO 81501
(970) 244-1430

Clearance No. 104684
Date Submitted 4-2-98
FEE \$ 25.00
Tax Schedule 2945-124-00-019
Zone C-1

BUSINESS NAME CARVILLE'S AUTO MART
STREET ADDRESS 1240 N. 21 ST
PROPERTY OWNER ROYCE CARVILLE
OWNER ADDRESS SAME

CONTRACTOR PLATINUM SIGNS
LICENSE NO. 2980732
ADDRESS 620 NGLAND
TELEPHONE NO. 260-3057

- 1. FLUSH WALL 2 Square Feet per Linear Foot of Building Facade
- 2. ROOF 2 Square Feet per Linear Foot of Building Facade
- 3. FREE-STANDING 2 Traffic Lanes - 0.75 Square Feet x Street Frontage
4 or more Traffic Lanes - 1.5 Square Feet x Street Frontage
- 4. PROJECTING 0.5 Square Feet per each Linear Foot of Building Facade
- 5. OFF-PREMISE See #3 Spacing Requirements; Not > 300 Square Feet or < 15 Square Feet

Externally Illuminated Internally Illuminated Non-Illuminated

- 5) Area of Proposed Sign 16 Square Feet
- (1,2,4) Building Facade 40 Linear Feet
- (1 - 4) Street Frontage 280 Linear Feet
- (2,4,5) Height to Top of Sign 15 Feet Clearance to Grade 13 Feet
- (5) Distance from all Existing Off-Premise Signs within 600 Feet _____ Feet

North Ave

Existing Signage/Type:	
POLE SIGN N. 21 ST	64 Sq. Ft.
POLE SIGN NORTH AVE	100 Sq. Ft.
POLE SIGN NORTH AVE	64 Sq. Ft.
Total Existing:	Sq. Ft.

● FOR OFFICE USE ONLY ●	
Signage Allowed on Parcel:	<i>small bldg only</i>
Building	80 Sq. Ft.
Free-Standing	420 Sq. Ft.
Total Allowed:	420 Sq. Ft.

POLE SIGN NORTH AVE 32

COMMENTS:

NOTE: No sign may exceed 300 square feet. A separate sign clearance is required for each sign. Attach a sketch of proposed and existing signage including types, dimensions, lettering, abutting streets, alleys, easements, property lines, and locations. **A SEPARATE PERMIT FROM THE BUILDING DEPARTMENT IS REQUIRED.**

[Signature]
Applicant's Signature

4-2-98
Date

[Signature]
Community Development Approval

4/6/98
Date

(White: Community Development) (Canary: Applicant) (Pink: Building Dept) (Goldenrod: Code Enforcement)



SIGN CLEARANCE

(B)

Community Development Department
250 North 5th Street
Grand Junction, CO 81501
(970) 244-1430

Clearance No. 641634
Date Submitted 4-2-98
FEE \$ 5.00
Tax Schedule 2945-124-00-019
Zone C-1

BUSINESS NAME CARVILLE'S AUTO MART
STREET ADDRESS 1240 N. 21 ST
PROPERTY OWNER ROYCE CARVILLE
OWNER ADDRESS SAME

CONTRACTOR PLATINUM SIGNS
LICENSE NO. 2980732
ADDRESS 620 NOLANO
TELEPHONE NO. 260-3057

- 1. FLUSH WALL 2 Square Feet per Linear Foot of Building Facade
- 2. ROOF 2 Square Feet per Linear Foot of Building Facade
- 3. FREE-STANDING 2 Traffic Lanes - 0.75 Square Feet x Street Frontage
4 or more Traffic Lanes - 1.5 Square Feet x Street Frontage
- 4. PROJECTING 0.5 Square Feet per each Linear Foot of Building Facade
- 5. OFF-PREMISE See #3 Spacing Requirements; Not > 300 Square Feet or < 15 Square Feet

Externally Illuminated Internally Illuminated Non-Illuminated

- 5) Area of Proposed Sign 16 Square Feet
- (1,2,4) Building Facade 40 Linear Feet
- (1 - 4) Street Frontage 280 Linear Feet
- (2,4,5) Height to Top of Sign 15 Feet Clearance to Grade 11 Feet
- (5) Distance from all Existing Off-Premise Signs within 600 Feet _____ Feet

North Ave

Existing Signage/Type:	
<u>POLE SIGN</u>	<u>64</u> Sq. Ft.
<u>ROOF SIGN</u>	<u>16</u> Sq. Ft.
<u>AWNING</u>	<u>30</u> Sq. Ft.
Total Existing:	_____ Sq. Ft.

● FOR OFFICE USE ONLY ●	
Signage Allowed on Parcel:	<u>small bldg only</u>
Building	<u>80</u> Sq. Ft.
Free-Standing	<u>420</u> Sq. Ft.
Total Allowed:	<u>420</u> Sq. Ft.

COMMENTS: _____

NOTE: No sign may exceed 300 square feet. A separate sign clearance is required for each sign. Attach a sketch of proposed and existing signage including types, dimensions, lettering, abutting streets, alleys, easements, property lines, and locations. **A SEPARATE PERMIT FROM THE BUILDING DEPARTMENT IS REQUIRED.**

[Signature] 4-2-98 [Signature] 4/6/98
 Applicant's Signature Date Community Development Approval Date

(White: Community Development) (Canary: Applicant) (Pink: Building Dept) (Goldenrod: Code Enforcement)



SIGN CLEARANCE

(C)

Community Development Department
250 North 5th Street
Grand Junction, CO 81501
(970) 244-1430

Clearance No. 604634
Date Submitted 4-2-98
FEE \$ 5.00
Tax Schedule 2945-124-00-019
Zone C-1

BUSINESS NAME CARVILLE'S AUTO MART
STREET ADDRESS 1240 N. 21 ST
PROPERTY OWNER ROYCE CARVILLE
OWNER ADDRESS SAME

CONTRACTOR PLATINUM SIGNS
LICENSE NO. 2980732
ADDRESS 620 NOLAND
TELEPHONE NO. 260-3057

- 1. FLUSH WALL 2 Square Feet per Linear Foot of Building Facade
- 2. ROOF 2 Square Feet per Linear Foot of Building Facade
- 3. FREE-STANDING 2 Traffic Lanes - 0.75 Square Feet x Street Frontage
4 or more Traffic Lanes - 1.5 Square Feet x Street Frontage
- 4. PROJECTING 0.5 Square Feet per each Linear Foot of Building Facade
- 5. OFF-PREMISE See #3 Spacing Requirements; Not > 300 Square Feet or < 15 Square Feet

Externally Illuminated Internally Illuminated Non-Illuminated

- 5) Area of Proposed Sign 16 Square Feet
- (1,2,4) Building Facade 40 Linear Feet
- (1 - 4) Street Frontage 280 Linear Feet
- (2,4,5) Height to Top of Sign 15 Feet Clearance to Grade 13 Feet
- (5) Distance from all Existing Off-Premise Signs within 600 Feet _____ Feet

North Ave

Existing Signage/Type:	
<u>POLE SIGN</u>	<u>64</u> Sq. Ft.
<u>ROOF SIGN</u>	<u>16</u> Sq. Ft.
<u>ROOF SIGN</u>	<u>16</u> Sq. Ft.
Total Existing:	_____ Sq. Ft.


● FOR OFFICE USE ONLY ●	
Signage Allowed on Parcel:	<u>small bldg only</u>
Building	<u>80</u> Sq. Ft.
Free-Standing	<u>420</u> Sq. Ft.
Total Allowed:	<u>420</u> Sq. Ft.

COMMENTS: _____

NOTE: No sign may exceed 300 square feet. A separate sign clearance is required for each sign. Attach a sketch of proposed and existing signage including types, dimensions, lettering, abutting streets, alleys, easements, property lines, and locations. **A SEPARATE PERMIT FROM THE BUILDING DEPARTMENT IS REQUIRED.**



[Signature] 4-2-98 [Signature] 4/6/98
 Applicant's Signature Date Community Development Approval Date

(White: Community Development) (Canary: Applicant) (Pink: Building Dept) (Goldenrod: Code Enforcement)

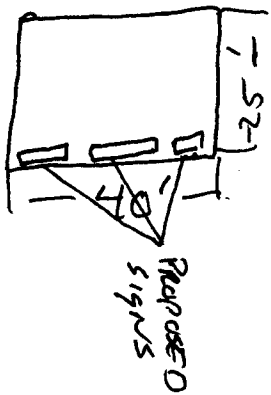

N. 21st

280'

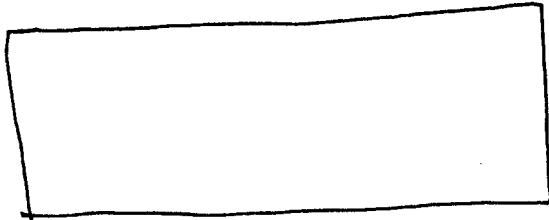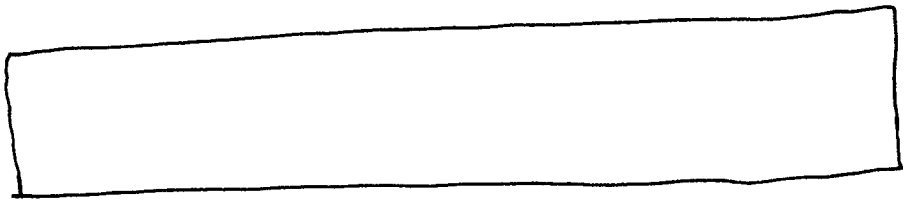

Existing sign

Existing sign

305'

NORTH AVE

2'x8' / A

BUY HERE - PAY HERE

4'x4' - B




2'x8' / C

FINANCING AVAILABLE
CASH + JOB = CAR




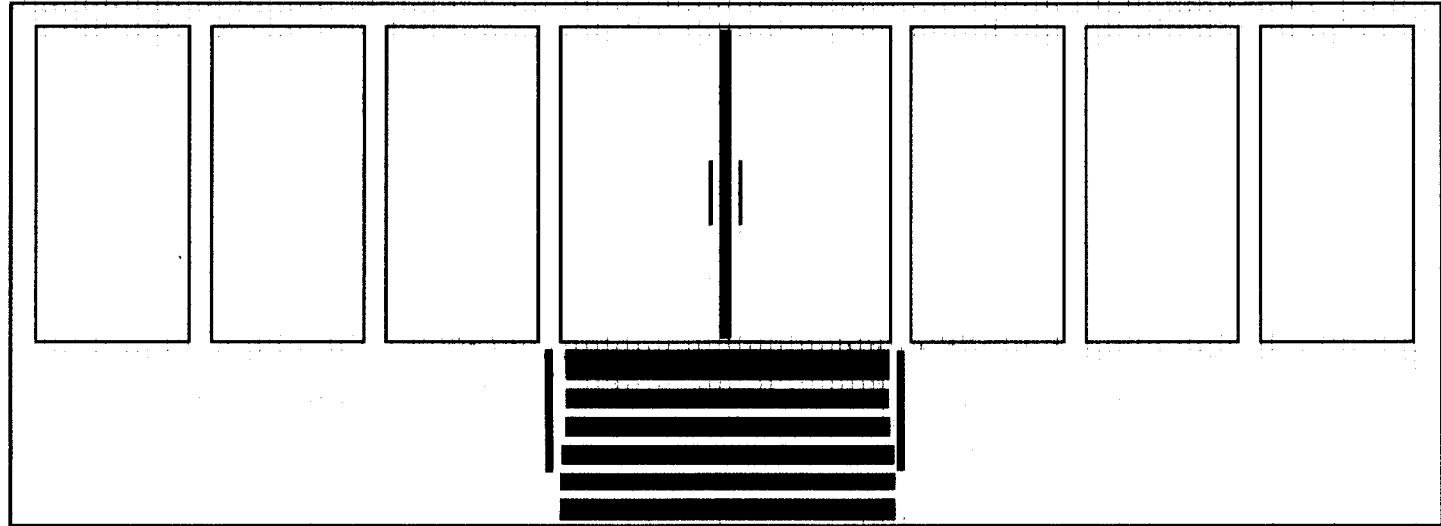

+ Need=dimension (distance) between roof & bottom of signs
+ Need side views of all 3 signs
to show bracing proposed




THIS ARTWORK WAS PREPARED BY AND IS THE PROPERTY OF PLATINUM SIGN CO. ANY UNAUTHORIZED USE OF SAME, IN WHOLE OR PART IS PROHIBITED.

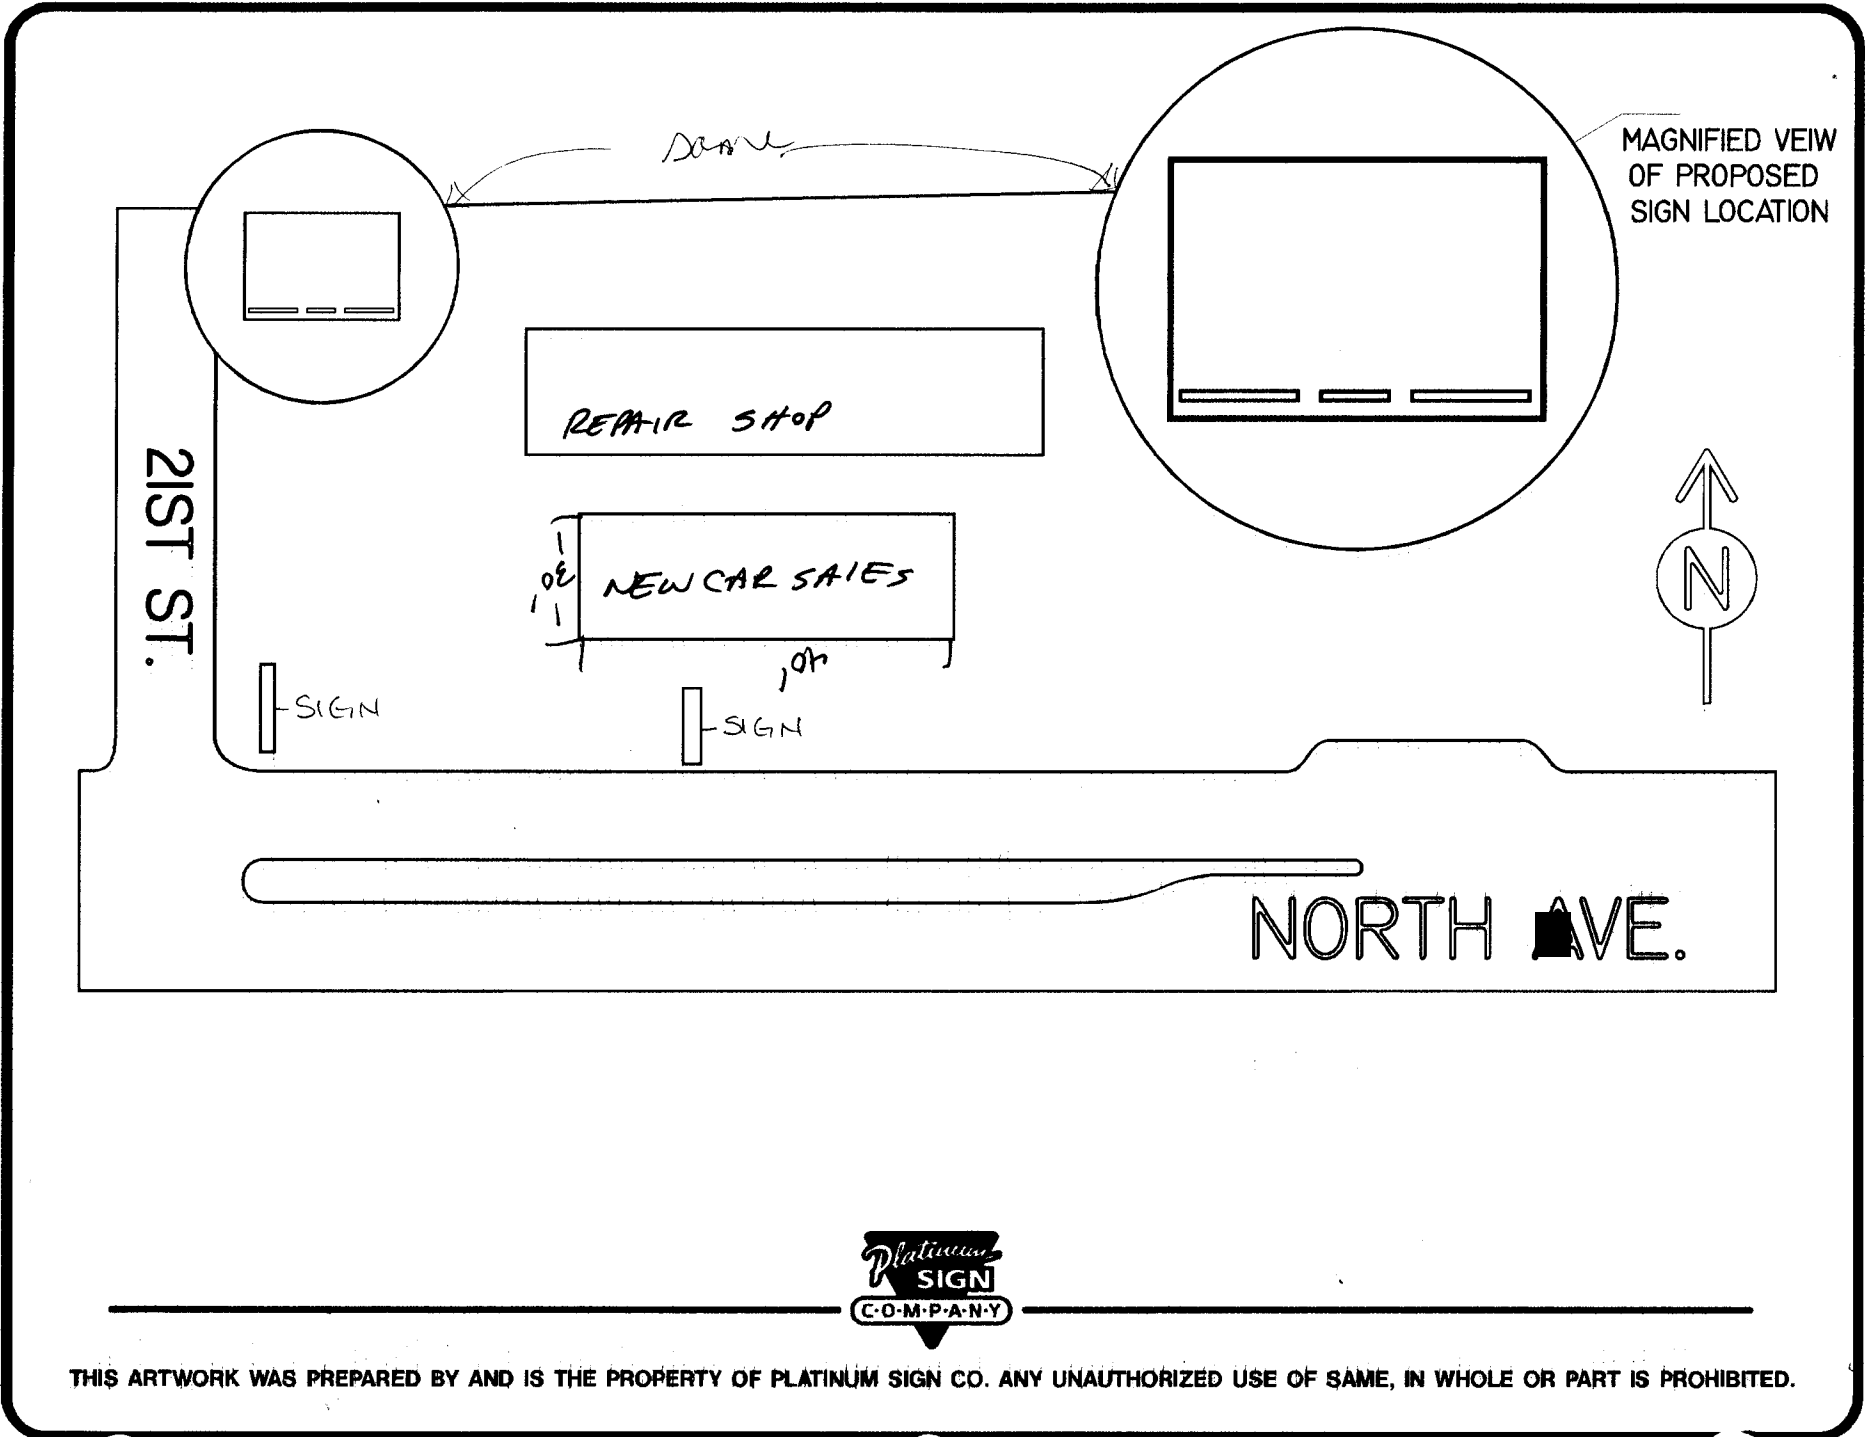


THIS ARTWORK WAS PREPARED BY AND IS THE PROPERTY OF PLATINUM SIGN CO. ANY UNAUTHORIZED USE OF SAME, IN WHOLE OR PART IS PROHIBITED.

SIGN

ANGLED VEIW

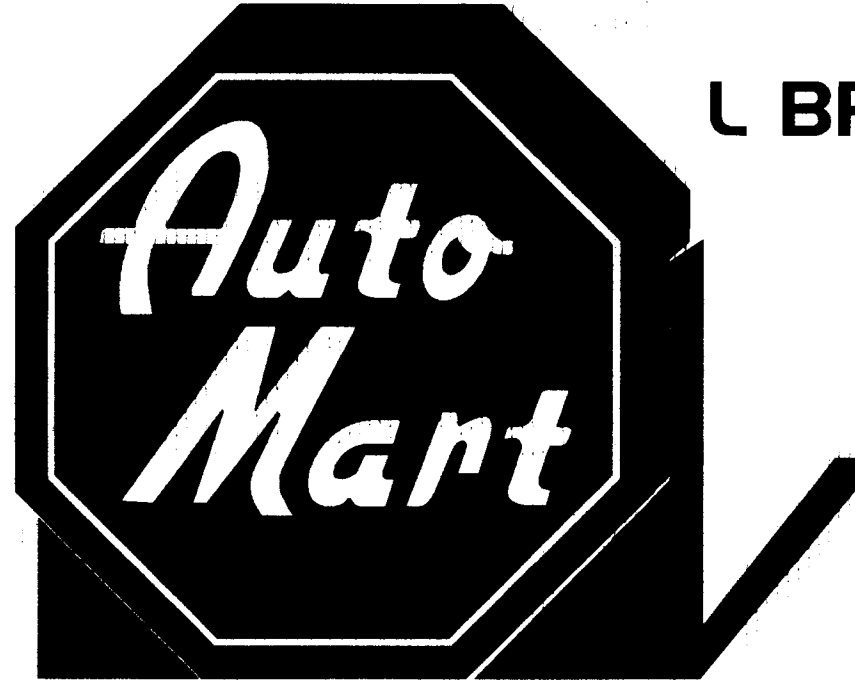

L BRACKETS

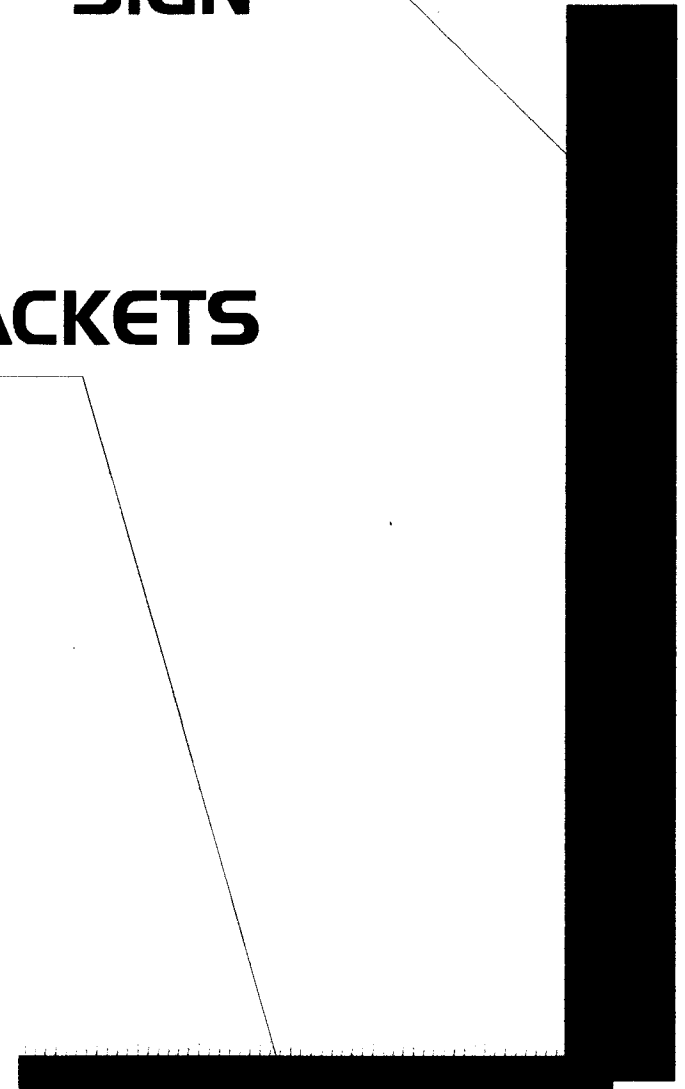

THIS ARTWORK WAS PREPARED BY AND IS THE PROPERTY OF PLATINUM SIGN CO. ANY UNAUTHORIZED USE OF SAME, IN WHOLE OR PART IS PROHIBITED.