



SIGN PERMIT

Community Development Department
 250 North 5th Street
 Grand Junction, CO 81501
 (970) 244-1430

Permit No. _____
 Date Submitted 3-19-98
 FEE \$ 25.-
 Tax Schedule 2945-131-02.012
 Zone B-3

BUSINESS NAME Jantor Electronics
 STREET ADDRESS 2513 BELFORD
 PROPERTY OWNER Sound Co.
 OWNER ADDRESS 2513 BELFORD

CONTRACTOR ARLO'S SIGN DESIGN
 LICENSE NO. 295-143-26-006
 ADDRESS 3018 MARKET WAY
 TELEPHONE NO. 970-434-0939

- 1. FLUSH WALL 2 Square Feet per Linear Foot of Building Facade
- Face Change Only (2,3 & 4):**
- 2. ROOF 2 Square Feet per Linear Foot of Building Facade
- 3. FREE-STANDING 2 Traffic Lanes - 0.75 Square Feet x Street Frontage
- 4 or more Traffic Lanes - 1.5 Square Feet x Street Frontage
- 4. PROJECTING 0.5 Square Feet per each Linear Foot of Building Facade

Existing Externally or Internally Illuminated - No Change in Electrical Service Non-Illuminated

(1 - 4) Area of Proposed Sign 32 Square Feet
 (1,2,4) Building Facade 120 Linear Feet
 (1 - 4) Street Frontage 150 Linear Feet
 (2,4) Height to Top of Sign 12 Feet Clearance to Grade 8 Feet

Existing Signage/Type:	
<u>4x8 Sound Co</u>	<u>32</u> Sq. Ft.
<u>2x2 General Elect</u>	<u>4</u> Sq. Ft.
<u>Plastic 8" Letters</u>	<u>8</u> Sq. Ft.
Total Existing:	<u>44</u> Sq. Ft.

● FOR OFFICE USE ONLY ●	
Signage Allowed on Parcel:	
Building	<u>240</u> Sq. Ft.
Free-Standing	<u>112.5</u> Sq. Ft.
Total Allowed	<u>240</u> Sq. Ft.

COMMENTS:

NOTE: No sign may exceed 300 square feet. A separate sign permit is required for each sign. Attach a sketch of proposed and existing signage including types, dimensions, lettering, abutting streets, alleys, easements, property lines, and locations.

[Signature] ant's Signature 3/19/98 Date [Signature] Community Development Approval 3/20/98 Date

(Community Development) (Canary: Applicant) (Pink: Code Enforcement)

8'


Taylor Electronics

"The Personal Service You Deserve"

**TV • VCR • AUDIO
SPECIALISTS**

4'

2513 BELFORD

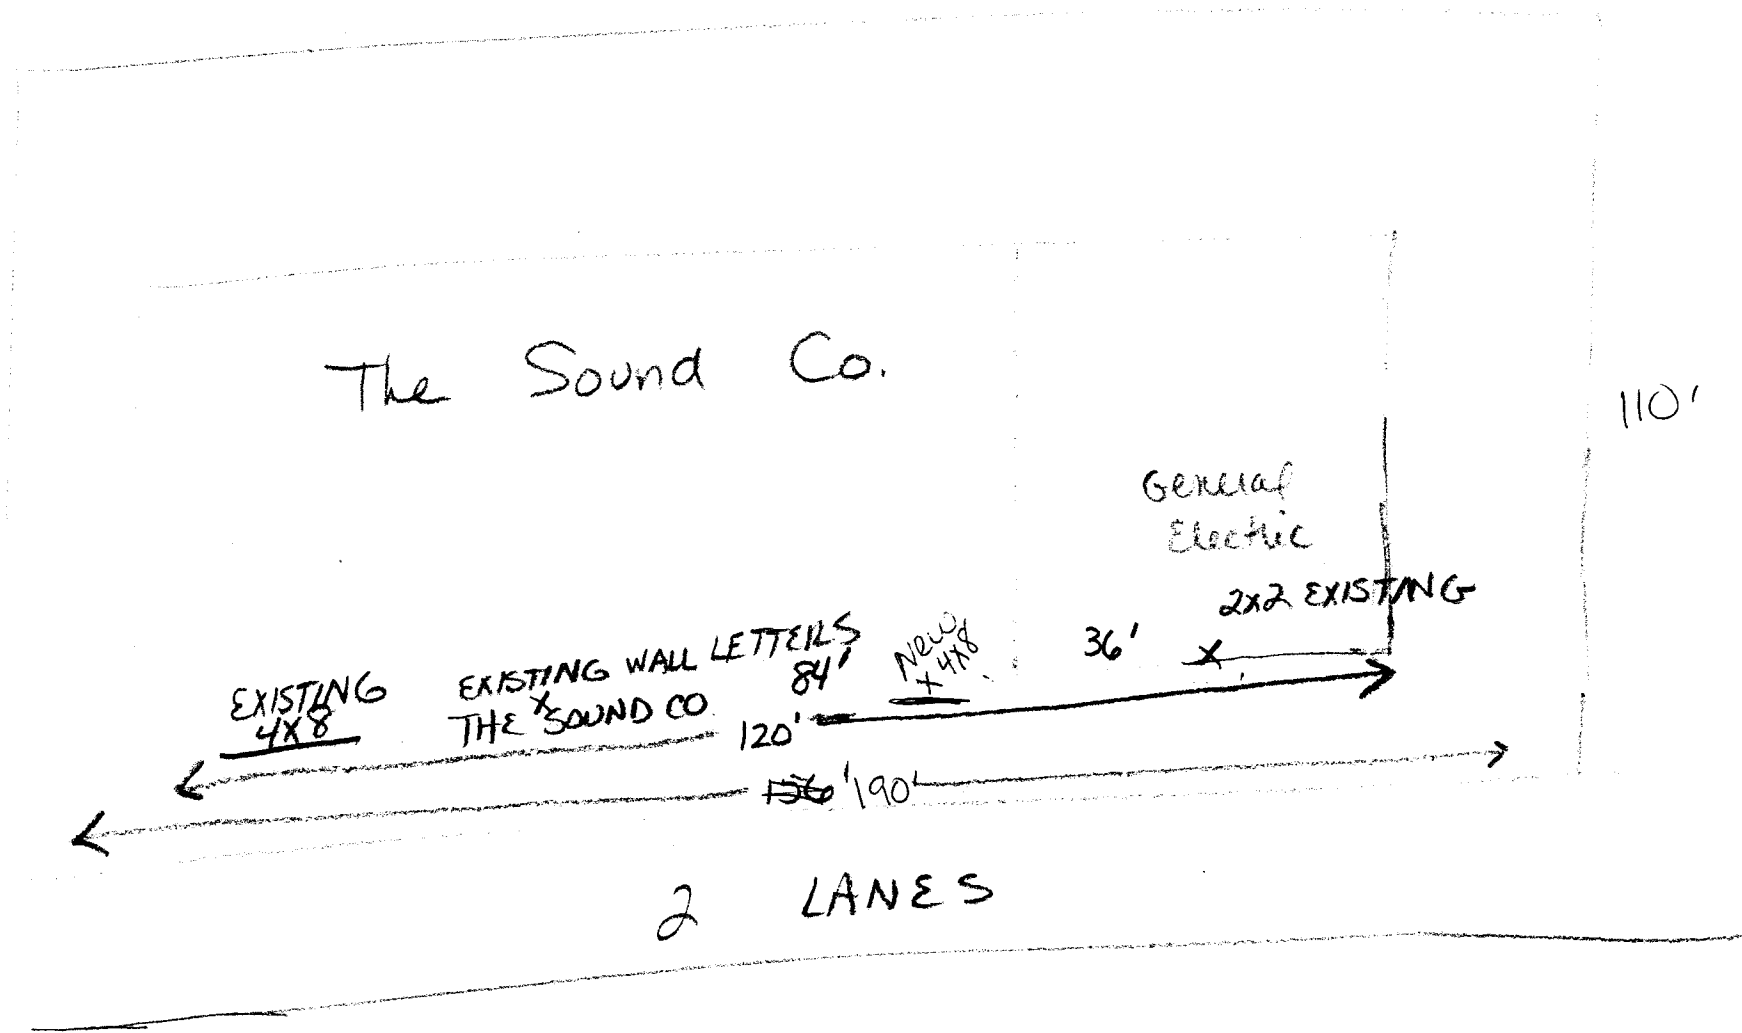

The Sound Co.

General Electric

110'

EXISTING 4x8

EXISTING WALL LETTERS THE SOUND CO. 84'

NEW 4x8 36'

36'

2x2 EXISTING

120'

190'

2 LANES

N

