



# SIGN CLEARANCE

3 of 5

Community Development Department  
250 North 5th Street  
Grand Junction, CO 81501  
(970) 244-1430

Clearance No. 68976  
Date Submitted 1-10-99  
FEES 5.00  
Tax Schedule 2945-024-00-970  
Zone PB

(9)

Family Practice Center  
BUSINESS NAME St. Mary's Hospital CONTRACTOR Scrimmard Sign Co.  
STREET ADDRESS 2001 N 12TH 1970 PATRICK LICENSE NO. 2960719  
PROPERTY OWNER St. Mary's Hospital ADDRESS 3207 S. Zuni Englewood, Co  
OWNER ADDRESS 2625 North St. TELEPHONE NO. 303-788-1829 8610

- 1. FLUSH WALL 2 Square Feet per Linear Foot of Building Facade
- 2. ROOF 2 Square Feet per Linear Foot of Building Facade
- 3. FREE-STANDING 2 Traffic Lanes - 0.75 Square Feet x Street Frontage  
4 or more Traffic Lanes - 1.5 Square Feet x Street Frontage
- 4. PROJECTING 0.5 Square Feet per each Linear Foot of Building Facade
- 5. OFF-PREMISE See #3 Spacing Requirements; Not > 300 Square Feet or < 15 Square Feet

Externally Illuminated  Internally Illuminated  Non-Illuminated

- (1 - 5) Area of Proposed Sign 20 Square Feet
- (1,2,4) Building Facade 320 Linear Feet
- (1 - 4) Street Frontage 477 Linear Feet
- (2,4,5) Height to Top of Sign 15 Feet Clearance to Grade 12 Feet
- (5) Distance from all Existing Off-Premise Signs within 600 Feet N/A Feet

Existing Signage/Type:	
<u>N/A</u> (1)	<u>22.75</u> Sq. Ft.
(2)	<u>20</u> Sq. Ft.
	Sq. Ft.
Total Existing:	<u>42.75</u> Sq. Ft.

● FOR OFFICE USE ONLY ●	
Signage Allowed on Parcel:	<u>PB zone</u>
Building	Sq. Ft.
Free-Standing	Sq. Ft.
Total Allowed:	Sq. Ft.

COMMENTS: \_\_\_\_\_

**NOTE:** No sign may exceed 300 square feet. A separate sign clearance is required for each sign. Attach a sketch of proposed and existing signage including types, dimensions, lettering, abutting streets, alleys, easements, property lines, and locations. **A SEPARATE PERMIT FROM THE BUILDING DEPARTMENT IS REQUIRED.**



Jenna Koehn 1-10-99 [Signature] 1-27-99  
Applicant's Signature Date Community Development Approval Date

(White: Community Development) (Canary: Applicant) (Pink: Building Dept) (Goldenrod: Code Enforcement)

P. 03/06

FHA NO. 1105640362

STANDARD LINE

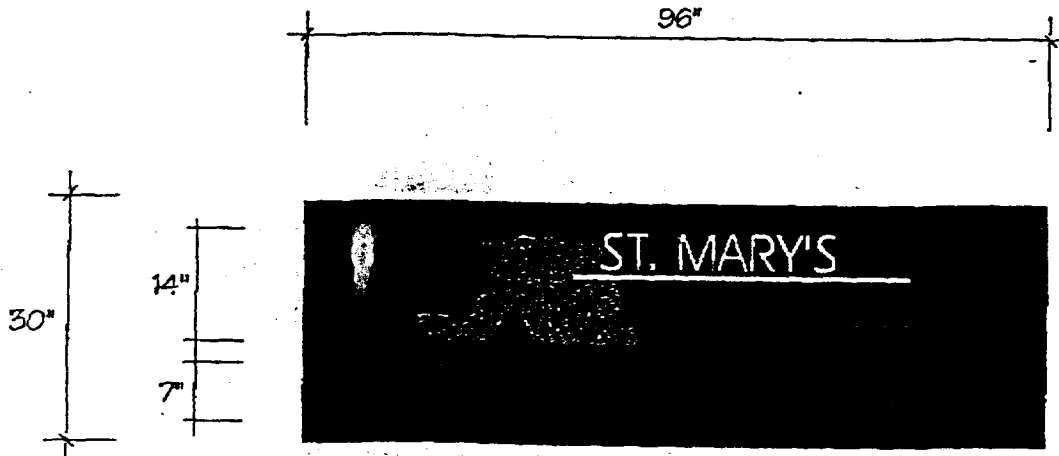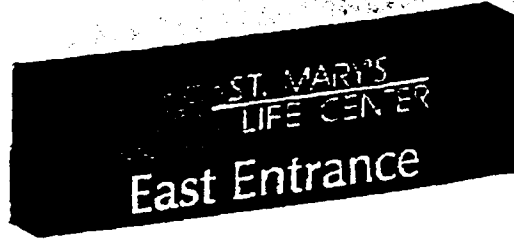

Project: #R981  
St. Mary's Life Center

Sign Type: Location: 03

Description:  
30" x 96" series 7, illuminated wall mount with concealed mounting. Routed aluminum face backed with standard color acrylic. Painted one (1) select color blue with copy to illuminate white.

Colors:  
Blue

Typeface:  
Logo Typestyle/Eras Medium

Qty: \_\_\_\_\_

Client Approval: \_\_\_\_\_

Date: \_\_\_\_\_

Scale: 1/2" = 1'-0" Drawn by: YMS

Date of origin: 07-10-98

Revision log:


This drawing and the ideas expressed remain the confidential property of INNERFACE. This drawing and its ideas are not to be reproduced, copied, or disclosed to any other person or entity, without the express written consent of a representative or an agent of INNERFACE Architectural Signage Inc.



120v  
 277v

**INNERFACE.**  
ARCHITECTURAL SIGNAGE

5320 Webb Parkway Lilburn, Ga 30047  
Phone 770-921-6566 Fax 770-278-1327

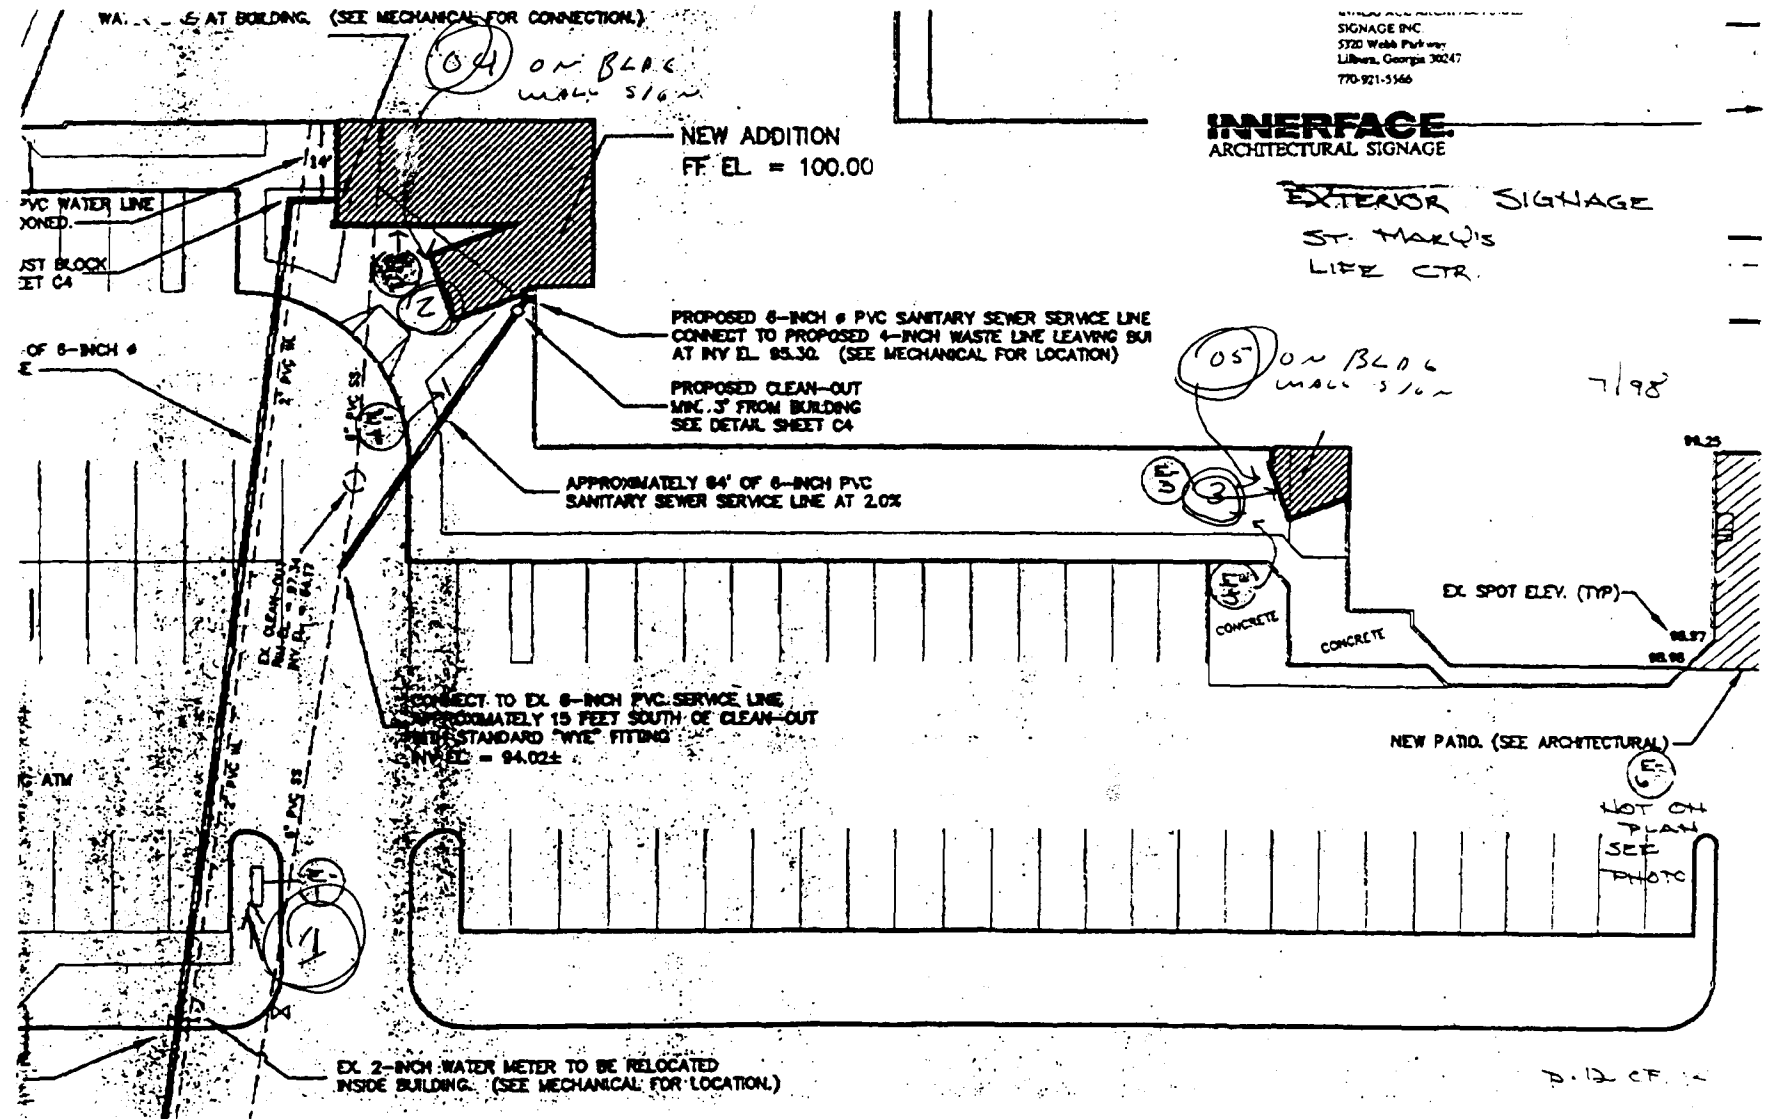

WATER METER AT BUILDING. (SEE MECHANICAL FOR CONNECTION.)

04 ON BLOCK WALL SIGN

NEW ADDITION  
FF EL. = 100.00

SIGNAGE INC  
5720 Webb Park way  
770-921-5566

**INTERFACE**  
ARCHITECTURAL SIGNAGE

EXTERIOR SIGNAGE  
ST. MARY'S  
LIFE CTR.

PVC WATER LINE  
EXPOSED.

1ST BLOCK  
SET CA

PROPOSED 6-INCH 6 PVC SANITARY SEWER SERVICE LINE  
CONNECT TO PROPOSED 4-INCH WASTE LINE LEAVING BUI  
AT INV EL. 95.30. (SEE MECHANICAL FOR LOCATION)

PROPOSED CLEAN-OUT  
MIN. 3' FROM BUILDING  
SEE DETAIL SHEET CA

05 ON BLOCK WALL SIGN

7/98

OF 6-INCH 6

APPROXIMATELY 84' OF 6-INCH PVC  
SANITARY SEWER SERVICE LINE AT 2.0%


EX SPOT ELEV. (TYP)

CONNECT TO EX. 6-INCH PVC SERVICE LINE  
APPROXIMATELY 15 FEET SOUTH OF CLEAN-OUT  
WITH STANDARD "WYE" FITTING  
FIN. EL. = 94.02±

NEW PAD. (SEE ARCHITECTURAL)

ATM

167 01  
SET  
7/98

EX. 2-INCH WATER METER TO BE RELOCATED  
INSIDE BUILDING. (SEE MECHANICAL FOR LOCATION.)

7.12 OF 12