



# SIGN CLEARANCE

Community Development Department  
250 North 5th Street  
Grand Junction, CO 81501  
(970) 244-1430

Clearance No. 69052  
Date Submitted MAR 8, 1999  
FEES 25  
Tax Schedule 2945-043-13-001  
Zone \_\_\_\_\_

(A) no permit?

WJ

BUSINESS NAME Alpine Bank  
STREET ADDRESS 2424 F Road  
PROPERTY OWNER Alpine Bank  
OWNER ADDRESS 225 No 5th suit B Grand Jct  
81501

CONTRACTOR Western Neon Sign Co  
LICENSE NO. 2990770  
ADDRESS 3183 Hall Ave Grand Jct  
TELEPHONE NO. 923 4045

- 1. FLUSH WALL 2 Square Feet per Linear Foot of Building Facade
- 2. ROOF 2 Square Feet per Linear Foot of Building Facade
- 3. FREE-STANDING 2 Traffic Lanes - 0.75 Square Feet x Street Frontage  
4 or more Traffic Lanes - 1.5 Square Feet x Street Frontage
- 4. PROJECTING 0.5 Square Feet per each Linear Foot of Building Facade
- 5. OFF-PREMISE See #3 Spacing Requirements; Not > 300 Square Feet or < 15 Square Feet

Externally Illuminated       Internally Illuminated       Non-Illuminated

- (1 - 5) Area of Proposed Sign 20,99 Square Feet
- (1,2,4) Building Facade 54 Linear Feet
- (1 - 4) Street Frontage 130 Linear Feet
- (2,4,5) Height to Top of Sign 14 Feet Clearance to Grade 12.5 Feet
- (5) Distance from all Existing Off-Premise Signs within 600 Feet \_\_\_\_\_ Feet

F ROAD

Existing Signage/Type:	Sq. Ft.
Total Existing:	


● FOR OFFICE USE ONLY ●		
Signage Allowed on Parcel:		
Building	<u>108</u>	Sq. Ft.
Free-Standing	<u>195</u>	Sq. Ft.
Total Allowed:	<u>195</u>	Sq. Ft.

### COMMENTS:

**NOTE:** No sign may exceed 300 square feet. A separate sign clearance is required for each sign. Attach a sketch of proposed and existing signage including types, dimensions, lettering, abutting streets, alleys, easements, property lines, and locations. **A SEPARATE PERMIT FROM THE BUILDING DEPARTMENT IS REQUIRED.**

Ray McNamee      3/9/99      [Signature]      3/9/99  
 Applicant's Signature      Date      Community Development Approval      Date

(White: Community Development)      (Canary: Applicant)      (Pink: Building Dept)      (Goldenrod: Code Enforcement)

 

# SIGN CLEARANCE

(B)

Community Development Department  
250 North 5th Street  
Grand Junction, CO 81501  
(970) 244-1430

Clearance No. 69052  
Date Submitted MAR 8, 1999  
FEE \$ 5  
Tax Schedule 2945 043-13-001  
Zone \_\_\_\_\_

BUSINESS NAME Alpine Bank  
STREET ADDRESS 2424 E Road  
PROPERTY OWNER Alpine Bank  
OWNER ADDRESS 225 No. 5th suit B Grand Junction  
81501

CONTRACTOR Western Sign Co  
LICENSE NO. 2990370  
ADDRESS 3153 Hall Ave  
TELEPHONE NO. 523 4047

- 1. FLUSH WALL 2 Square Feet per Linear Foot of Building Facade
- 2. ROOF 2 Square Feet per Linear Foot of Building Facade
- 3. FREE-STANDING 2 Traffic Lanes - 0.75 Square Feet x Street Frontage  
4 or more Traffic Lanes - 1.5 Square Feet x Street Frontage
- 4. PROJECTING 0.5 Square Feet per each Linear Foot of Building Facade
- 5. OFF-PREMISE See #3 Spacing Requirements; Not > 300 Square Feet or < 15 Square Feet

Externally Illuminated       Internally Illuminated       Non-Illuminated

- (1 - 5) Area of Proposed Sign 20.94 Square Feet
- (1,2,4) Building Facade 54 Linear Feet
- (1 - 4) Street Frontage 130 Linear Feet
- (2,4,5) Height to Top of Sign 14 Feet Clearance to Grade 12.5 Feet
- (5) Distance from all Existing Off-Premise Signs within 600 Feet \_\_\_\_\_ Feet

F ROAD

Existing Signage/Type:	
<del>F.W.</del> F.W.	21 <del>200</del> Sq. Ft.
	Sq. Ft.
	Sq. Ft.
Total Existing:	21 Sq. Ft.

● FOR OFFICE USE ONLY ●	
Signage Allowed on Parcel:	
Building	108 Sq. Ft.
Free-Standing	195 Sq. Ft.
Total Allowed:	195 Sq. Ft.

COMMENTS: \_\_\_\_\_

**NOTE:** No sign may exceed 300 square feet. A separate sign clearance is required for each sign. Attach a sketch of proposed and existing signage including types, dimensions, lettering, abutting streets, alleys, easements, property lines, and locations. **A SEPARATE PERMIT FROM THE BUILDING DEPARTMENT IS REQUIRED.**

Ray [Signature]      3/8/99      [Signature]      3/9/99  
 Applicant's Signature      Date      Community Development Approval      Date

(White: Community Development)      (Canary: Applicant)      (Pink: Building Dept)      (Goldenrod: Code Enforcement)



# SIGN CLEARANCE

Community Development Department  
250 North 5th Street  
Grand Junction, CO 81501  
(970) 244-1430

Clearance No.                       
Date Submitted MAR 8, 1999  
FEES NO FEE - Exempt  
Tax Schedule 2945-048-13-001  
Zone                     

BUSINESS NAME Alpine Bank  
STREET ADDRESS 2424 E Road  
PROPERTY OWNER Alpine Bank  
OWNER ADDRESS 225 NO 5th suite B Grand Jct  
81501

CONTRACTOR Western Sign Sign Co  
LICENSE NO. 2996370  
ADDRESS 3187 Hall Ave  
TELEPHONE NO. 523 4049

- 1. FLUSH WALL 2 Square Feet per Linear Foot of Building Facade
- 2. ROOF 2 Square Feet per Linear Foot of Building Facade
- 3. FREE-STANDING 2 Traffic Lanes - 0.75 Square Feet x Street Frontage  
4 or more Traffic Lanes - 1.5 Square Feet x Street Frontage
- 4. PROJECTING 0.5 Square Feet per each Linear Foot of Building Facade
- 5. OFF-PREMISE See #3 Spacing Requirements; Not > 300 Square Feet or < 15 Square Feet

Externally Illuminated       Internally Illuminated       Non-Illuminated

- (1 - 5) Area of Proposed Sign 3 Square Feet
- (1,2,4) Building Facade 54 Linear Feet
- (1 - 4) Street Frontage 130 Linear Feet
- (2,4,5) Height to Top of Sign 3 Feet Clearance to Grade 1 Feet
- (5) Distance from all Existing Off-Premise Signs within 600 Feet                      Feet

*Private Directional Signs  
Exempt from Sign Code*

Existing Signage/Type:	
	Sq. Ft.
	Sq. Ft.
	Sq. Ft.
	Sq. Ft.
Total Existing:	Sq. Ft.

● FOR OFFICE USE ONLY ●	
Signage Allowed on Parcel:	
Building	Sq. Ft.
Free-Standing	Sq. Ft.
Total Allowed:	Sq. Ft.

COMMENTS: Alpine Bank is proposing 3 private 3'x4' each directional signs for traffic circulation purposes.

**NOTE:** No sign may exceed 300 square feet. A separate sign clearance is required for each sign. Attach a sketch of proposed and existing signage including types, dimensions, lettering, abutting streets, alleys, easements, property lines, and locations. **A SEPARATE PERMIT FROM THE BUILDING DEPARTMENT IS REQUIRED.**

Ray M. Mans      3/8/99      Daryl [Signature]      3/9/99  
Applicant's Signature      Date      Community Development Approval      Date

(White: Community Development)      (Canary: Applicant)      (Pink: Building Dept)      (Goldenrod: Code Enforcement)

N 89°59'40" E 86.67'

ELEC. TRANS.

LIGHTPOLE

72.00' 6" BARRIER CURB

SPACE

R=3.00'  
L=4.71'

19.00' 2" CONC. (TYP.)  
LANDSCAPE  
1.50%  
9.00' 8 SPACES  
GRADEBREAK

TC 56.55  
FS 56.05  
R=3.00'  
L=4.71'  
TC 56.78  
FS 56.28  
R=3.00'  
L=4.71'  
TC 55.74  
FL 55.24  
R=3.00'  
L=4.71'

ENTRY SIGN

15' UTILITY & IRRIGATION EASEMENT  
LANDSCAPE  
41.26'  
1.50%  
CONC. PAD  
6" BARRIER CURB

TC 56.58  
FS 56.08  
1.20%  
TC 56.30  
FS 55.80  
R=15.00'  
L=11.78'

TC 55.12  
FL 54.62  
TC 55.01  
FL 54.51  
R=1.00'  
L=1.57' (TYP.)  
R=1.00'  
L=1.57' (TYP.)  
R=1.00'  
L=1.57' (TYP.)

TC 56.33  
FS 55.83  
R=15.00'  
L=11.78'  
R=15.00'  
L=5.41'

TC 55.28  
FS 54.78  
TC 55.40  
FS 54.90  
R=10.00'  
L=7.85'

TC 55.92  
FS 55.42  
R=10.00'  
L=7.85'

# ALPINE BANK

P.P. = 4556.3' 1 BIKE RACK SEE DETAIL

EXIT SIGN  
BLDG. UP-LIGHT (TYP. x5)  
LANDSCAPE  
FLAGPOLE  
R=22.00'  
L=51.84'

TC 55.09  
FS 54.59  
R=10.00'  
L=7.85'

2" CONC. (TYP.)  
16.73'  
L=5.79  
R=3.00'  
Delta=1  
Tan=4.

2.20%  
R=20.00'  
L=5.90'

TC 54.72  
FS 54.22  
R=20.00'  
L=5.90'

2.30%  
12.00'  
31.38'

TC 54.76  
FS 54.26  
R=20.00'  
L=5.90'

DRAINAGE AND UTILITY EASEMENT

11.30 LF 15" HOPE @ 0.97%

EXIT ONLY SIGN


ALPINE GV MALL  
SDA 2/15/99

4550 4553 4555  
5.00' (TYP.)

7/11/99

1903494810 P.03

70-101-1991-1000 FROM SUBMITTALS

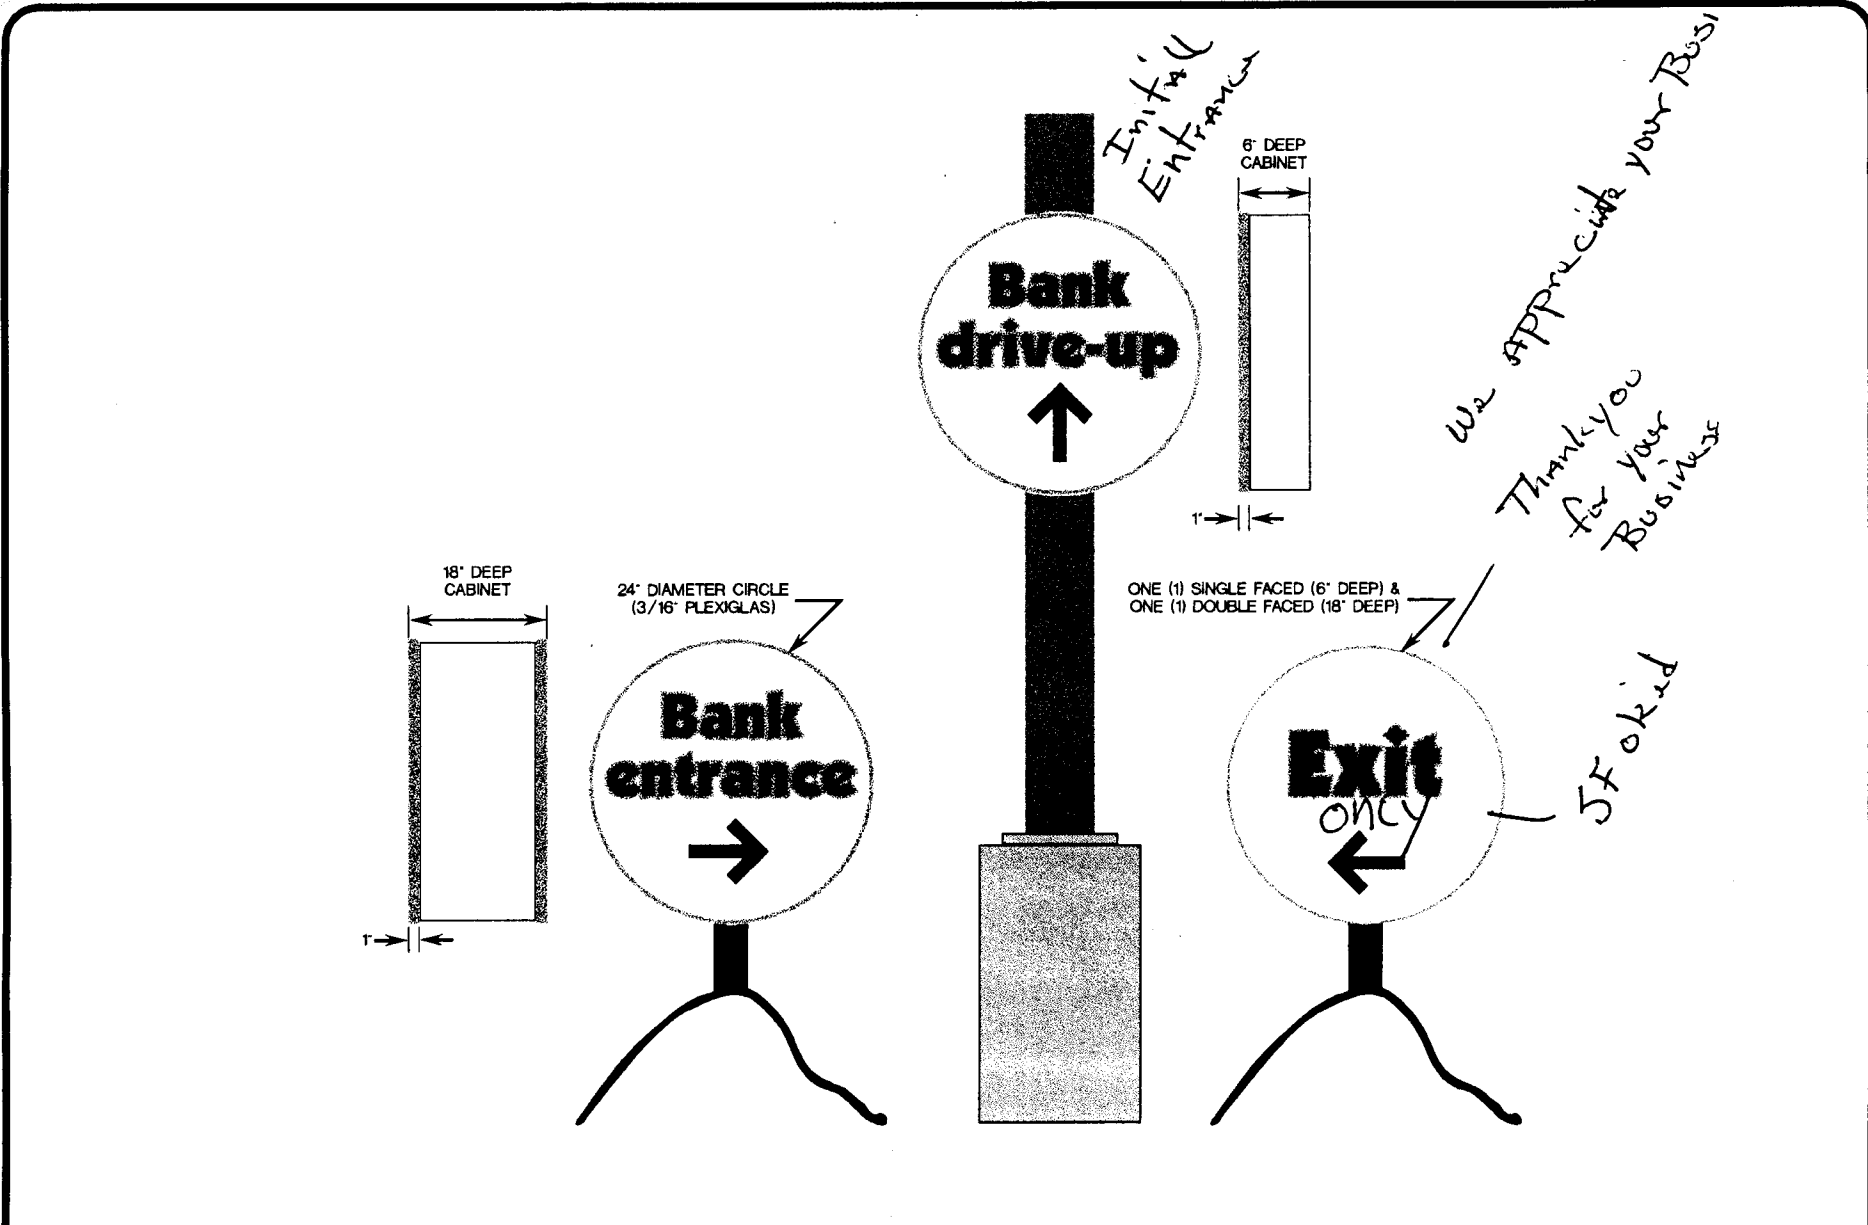

*Initial Entrance*

*We appreciate your Business*

*Thank you for your Business*

*JF ok'd*



**ELECTRIC SIGN Specialists**

Office: (970) 523-4045 Fax: (970) 523-4046  
 3183 Hall Ave., Grand Junction, CO 81504

ALL RIGHTS RESERVED  
 No part of this design and layout may be reproduced or utilized in any form or by any means without permission in writing from Western Neon Sign Co., Inc.


28" DIAMETER  
LOGO  
(3/16" PLEXIGLAS)

17 1/2" TALL

17 1/4" TALL



Alpine Bank

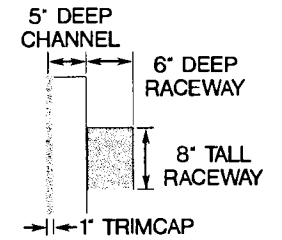

14' 4" Long

20.99 #



**ELECTRIC SIGN Specialists**

Office: (970) 523-4045 Fax: (970) 523-4046  
3183 Hall Ave., Grand Junction, CO 81504

ALL RIGHTS RESERVED  
No part of this design and layout may be reproduced or utilized in any form  
or by any means without permission in writing from Western Neon Sign Co., Inc.