



# SIGN PERMIT

(A)

Community Development Department  
250 North 5th Street  
Grand Junction, CO 81501  
(970) 244-1430

Permit No. \_\_\_\_\_  
Date Submitted 7-26-00  
FEE \$ 25.00  
Tax Schedule 9701-334-00-031  
Zone KMF-8

BUSINESS NAME Vineyard Church  
STREET ADDRESS 736 24 1/2 Rd  
PROPERTY OWNER Vineyard Church  
OWNER ADDRESS 736 24 1/2 Rd

CONTRACTOR The Sign Gallery  
LICENSE NO. 12200212  
ADDRESS 1048 Independence #109  
TELEPHONE NO. 241-6400

- 1. FLUSH WALL 2 Square Feet per Linear Foot of Building Facade
- Face Change Only (2,3 & 4):*
- 2. ROOF 2 Square Feet per Linear Foot of Building Facade
- 3. FREE-STANDING 2 Traffic Lanes - 0.75 Square Feet x Street Frontage  
4 or more Traffic Lanes - 1.5 Square Feet x Street Frontage
- 4. PROJECTING 0.5 Square Feet per each Linear Foot of Building Facade

Existing Externally or Internally Illuminated - No Change in Electrical Service       Non-Illuminated

(1 - 4) Area of Proposed Sign 6.6 Square Feet  
(1,2,4) Building Facade \_\_\_\_\_ Linear Feet  
(1 - 4) Street Frontage 1000 Linear Feet  
(2,3,4) Height to Top of Sign 3.5 Feet Clearance to Grade 1 Feet

*\* Sign allowance is 244 in Residential zone district.*

Existing Signage/Type:	
	Sq. Ft.
	Sq. Ft.
	Sq. Ft.
Total Existing:	<u>0</u> Sq. Ft.

● FOR OFFICE USE ONLY ●	
Signage Allowed on Parcel:	<u>24 1/2 Rd</u>
Building	Sq. Ft.
Free-Standing	<u>300</u> <u>750</u> Sq. Ft.
Total Allowed:	<u>750*</u> Sq. Ft.


COMMENTS: The sign is individual letters on a monument. Sign A only is permitted. Only one sign per street frontage is allowed.

NOTE: No sign may exceed 300 square feet. A separate sign permit is required for each sign. Attach a sketch of proposed and existing signage including types, dimensions, lettering, abutting streets, alleys, easements, property lines, and locations. Roof signs shall be manufactured such that no guy wires, braces or supports shall be visible.

Larry Z Bowle      7-18-00      R. Herstenberger      7/26/00  
Applicant's Signature      Date      Community Development Approval      Date


(White: Community Development)      (Canary: Applicant)      (Pink: Code Enforcement)

Canyon View  
Vineyard Church  
736 24 1/2 Rd

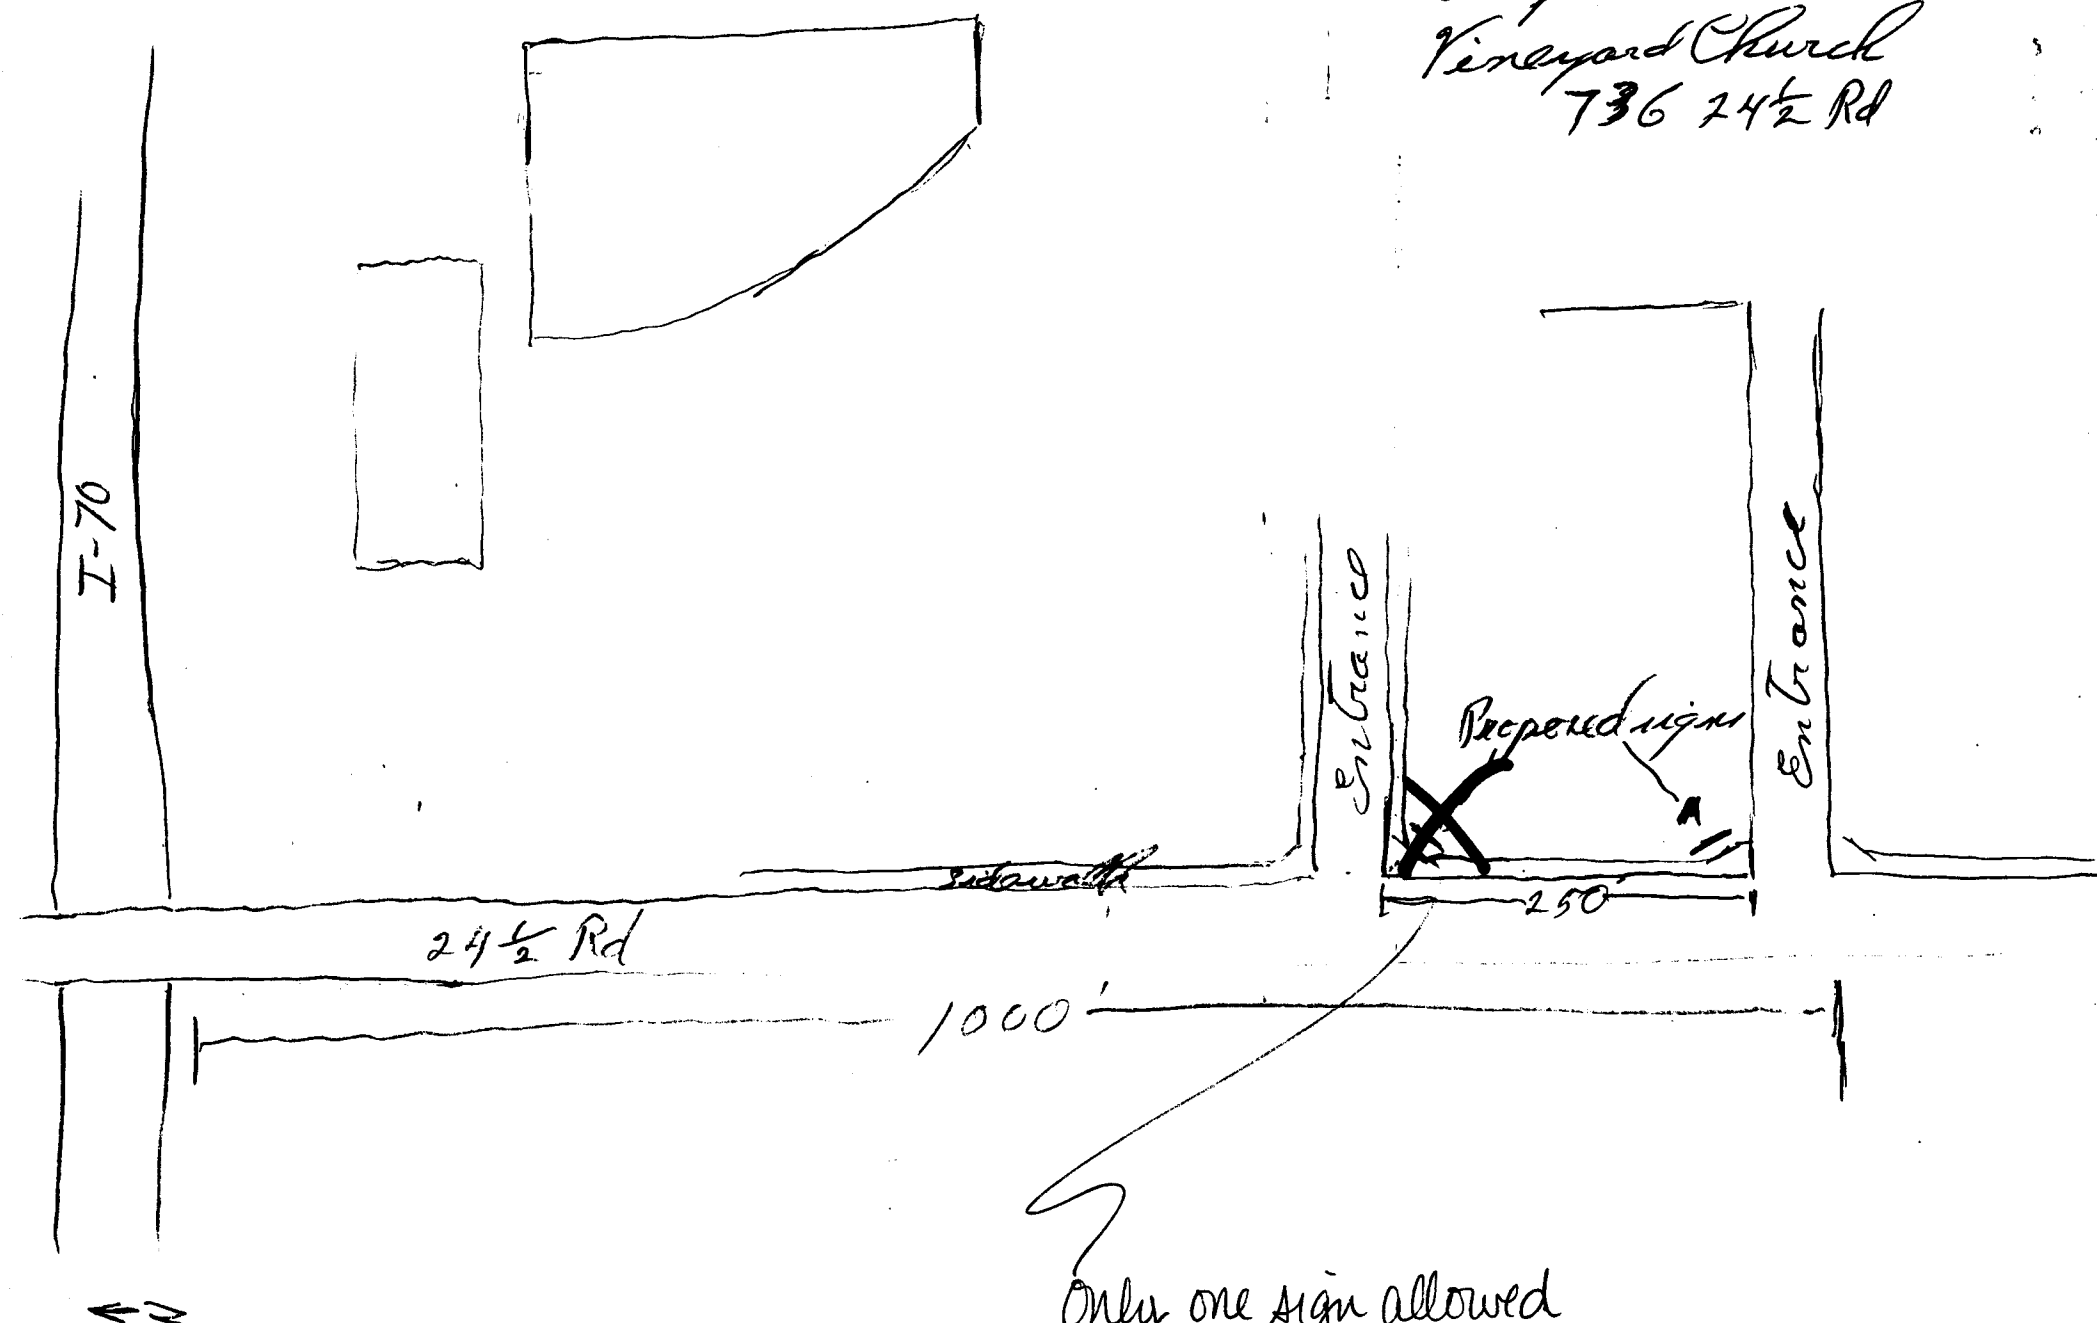

Only one sign allowed  
per street frontage. L.Y.

10'

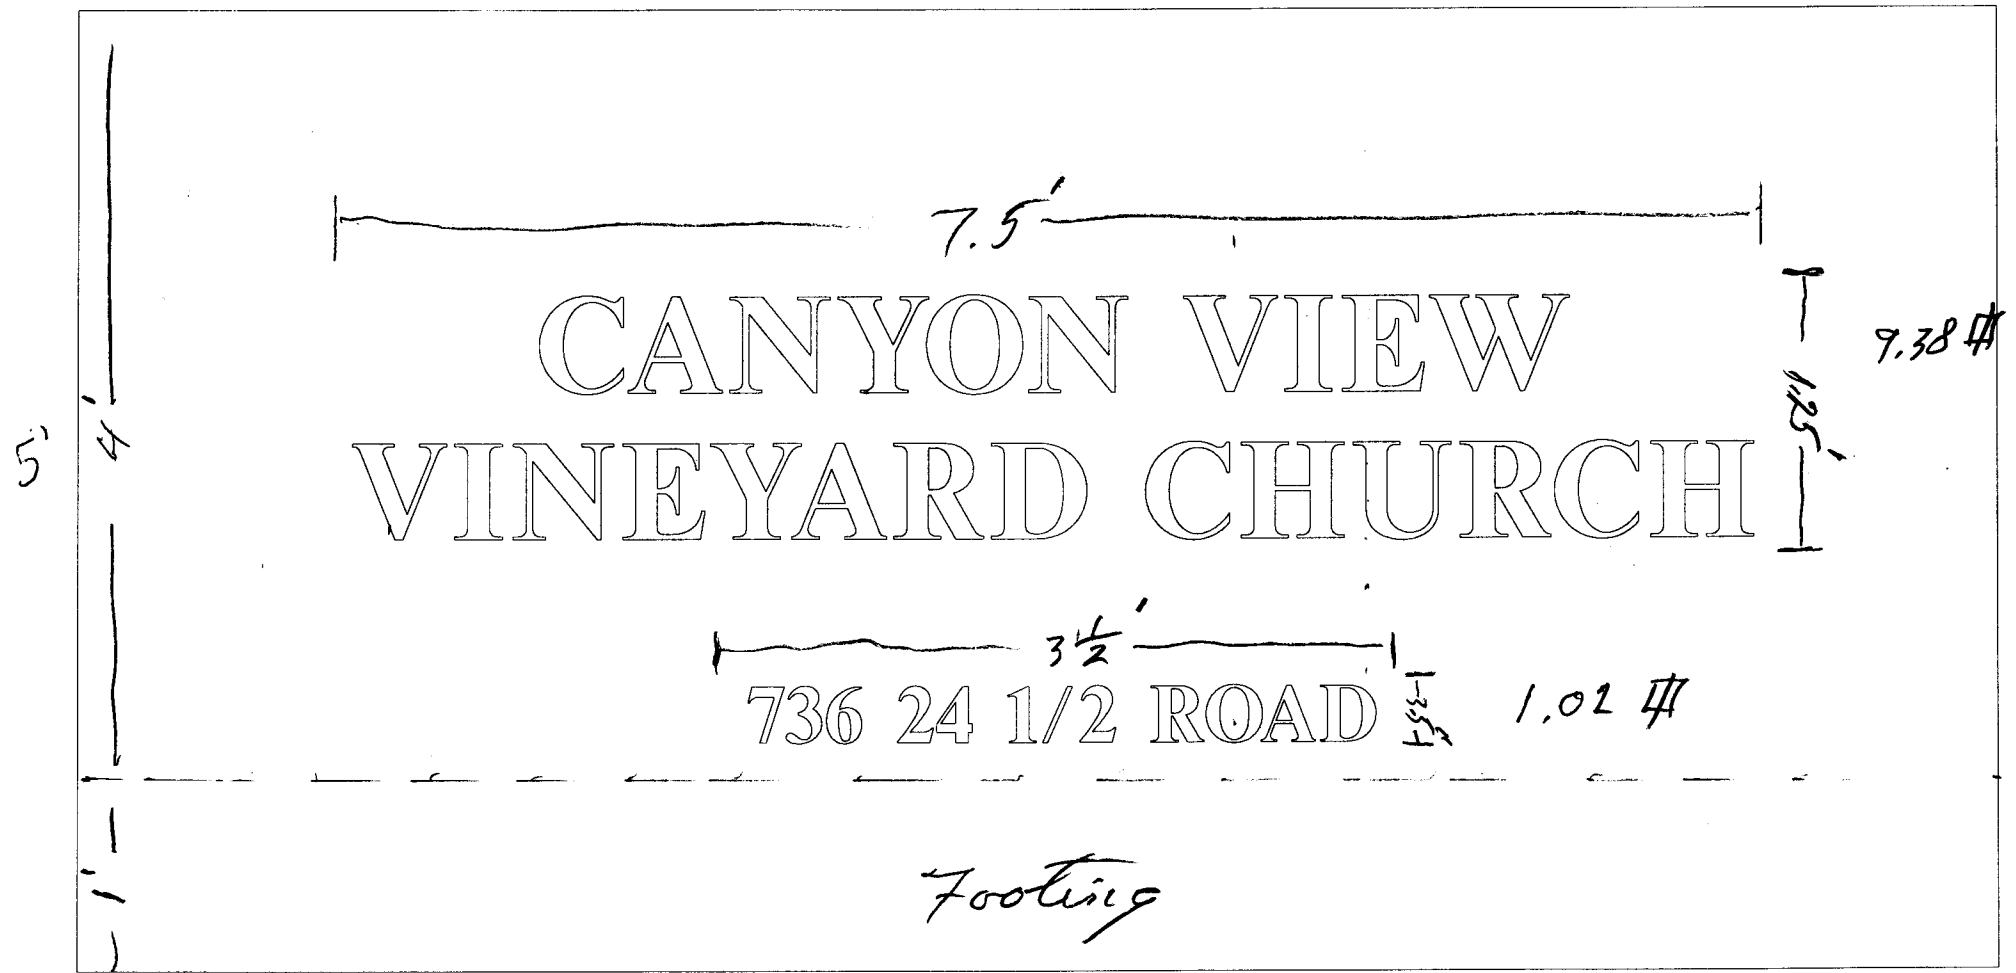

CANYON VIEW  
 VINEYARD CHURCH

736 24 1/2 ROAD

Footing

5'

4'

1'

7.5'

3 1/2'

1.25'

9.38

1.02

10.4