	Community Development Depar		Submitted 788	-01	
	250 North 5th Street		25.00		
	Grand Junction, CO 81501		Tax Schedule 2945-254-05-002		
	(970) 244-1430	· .	C-1		
BUSINESS NAN STREET ADDR PROPERTY OV OWNER ADDR	ESS 2771 B16 22 INER PIX: ELLC	LICE		m Sign Co DL 910 DO B TIOTT	
] 4. PRO.] 5. OFF-	E-STANDING 2 Traffic La 4 or more T UECTING 0.5 Square 1	Traffic Lanes - 1.5 S Feet per each Linea Fing Requirements;	Feet x Street Frontage Square Feet x Street Frontage r Foot of Building Facade Not > 300 Square Feet or <	15 Square Feet	
1-5) Δrea	1.1	/ Internally Illun	inated	[] Non-Illuminated	
1,2,4) Buildi 1 - 4) Street 2 - 5) Heigh	of Proposed Sign <u>44</u> Square Formage <u>58</u> Linear Feet Frontage <u>240</u> Linear Feet t to Top of Sign Feet Cle	eet 3 1/2 FJ arance to Grade	Feet	[] Non-Illuminated	



(White: Community Development)

чġ

(Canary: Applicant)

(Pink: Building Dept)

(Goldenrod: Code Enforcement)

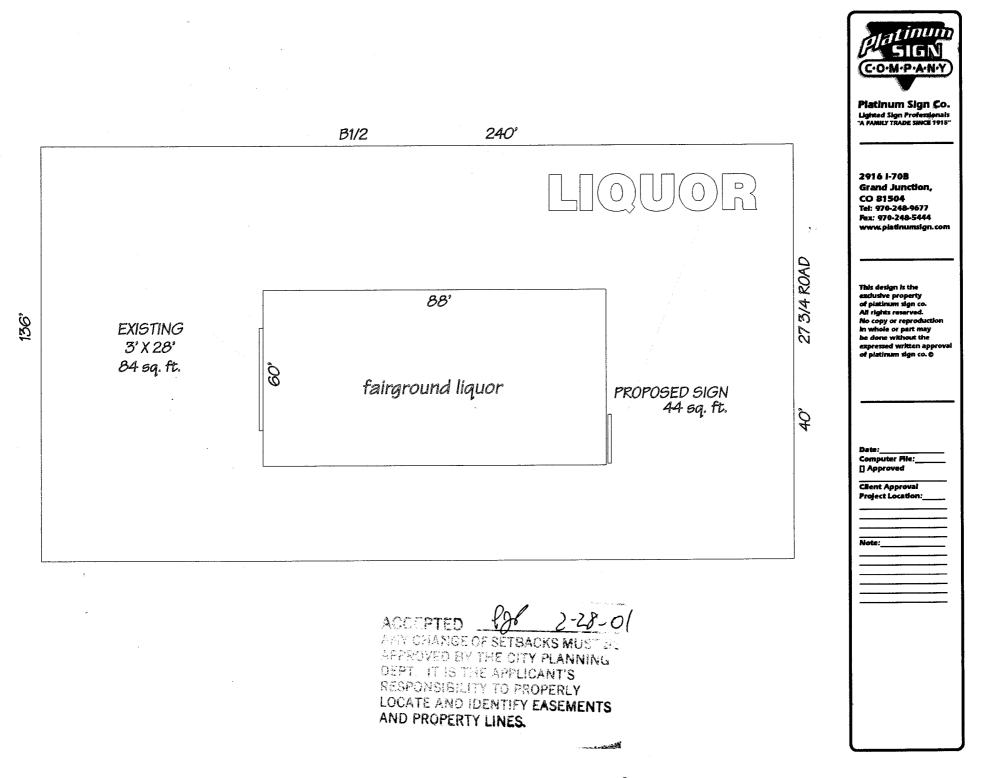

\$