

(White: Community Development)


SIGN CLEARANCE

Community Development Department 250 North 5th Street Grand Junction CO 81501 (970) 244-1430

	Clearance No. N. Date Submitted 4/26/02
(Fee \$ 25.00 Zone C-1

TAX SCHEDULE 2943-073-00-123 CONTRACTOR PLAFINUM Sign Co BUSINESS NAME Tennilas Mexican Restanticense No. 2020812 STREET ADDRESS 2011 North Ave 2500 ADDRESS 2916 I-70 B PROPERTY OWNER William Egyptinger TELEPHONE No. 248-9677 OWNER ADDRESS Same Dawla CONTACT PERSON Mike				
[] 1. FLUSH WALL 2 Square Feet per Linear Foot of Building Facade 2 Square Feet per Linear Foot of Building Facade 3 FREE-STANDING 2 Traffic Lanes - 0.75 Square Feet x Street Frontage 4 or more Traffic Lanes - 1.5 Square Feet x Street Frontage 5 OFF-PREMISE 5 OFF-PREMISE 5 Square Feet per each Linear Foot of Building Facade 5 Square Feet per each Linear Foot of Building Facade 6 See #3 Spacing Requirements; Not > 300 Square Feet or < 15 Square Feet				
[] Externally Illuminated [X] Internally Ill	uminated	[] Non-Illuminated		
(1 - 5) Area of Proposed Sign: 90 Square Feet (1,2,4) Building Façade: 45' Linear Feet (1 - 4) Street Frontage: 100' Linear Feet (2 - 5) Height to Top of Sign: 25 Feet Clearance to Grade: 15 Feet (5) Distance from all Existing Off-Premise Signs within 600 Feet: Feet				
EXISTING SIGNAGE/TYPE:		● FOR OFFICE USE ONLY ●		
N/2	Sq. Ft.	Signage Allowed on Parcel:		
		0.5		
	Sq. Ft. Sq. Ft.	Building $\frac{1}{50}$ Sq. Ft. Free-Standing $\frac{1}{50}$ Sq. Ft.		
Total Existing:	Sq. Ft.	Total Allowed: 150 Sq. Ft.		
comments: Putting up New Sign on existing Pole, Taking down existing sign				
NOTE: No sign may exceed 300 square feet. A separate sign clearance is required for each sign. Attach a sketch, to scale, of proposed and existing signage including types, dimensions and lettering. Attach a plot plan, to scale, showing: abutting streets, alleys, easements, driveways, encroachments, property lines, distances from existing buildings to proposed signs and required setbacks. A SEPARATE PERMIT FROM THE BUILDING DEPARTMENT IS ALSO REQUIRED.				
Applicant's Signature Date Community Development Approval Date				
(White: Community Development) (Canary: Applicant)	(Pink: Bı	uilding Dept) (Goldenrod: Code Enforcement)		

(Canary: Applicant)

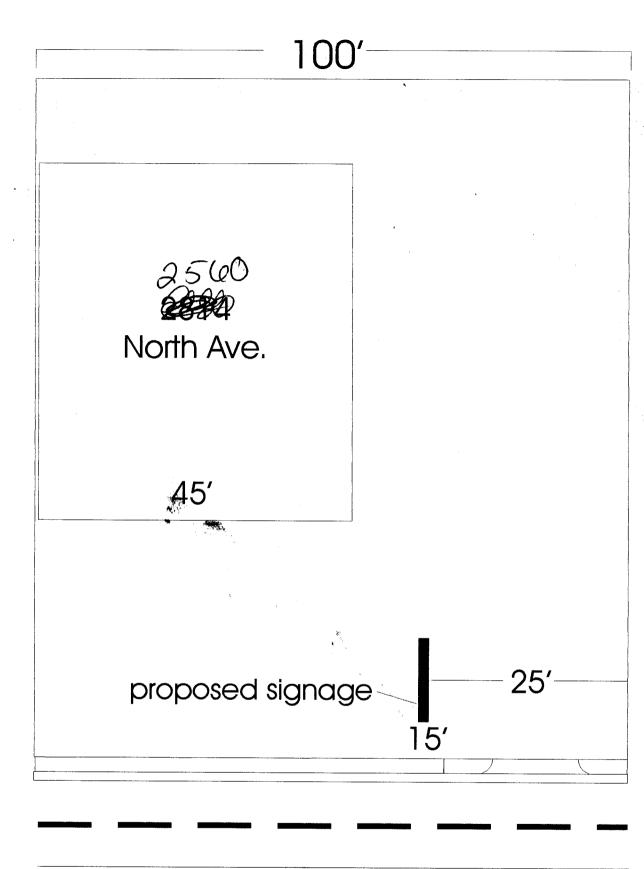

North Ave.



Family Mexican Restaurant

