

SIGN PERMIT




Community Development Department 250 North 5th Street Grand Junction, CO 81501 (970) 244-1430

Permit No.	
Date Submitted _	10/20/03
FEE \$ 25	00
Tax Schedule 29	45-141-03-001
Zone C-1	

PROPERTY OWNER OWNER ADDRESS TELEPHONE NO. 2/3-/383 [] 1. FLUSH WALL 2 Square Feet per Linear Foot of Building Facade Face Change Oxfy (2,3 & 4): [] 2. ROOF 2 Square Feet per Linear Foot of Building Facade [] 3. FREE-STANDING 2 Traffic Lanes - 0.75 Square Feet x Street Frontage 4 or more Traffic Lanes - 1.5 Square Feet x Street Frontage 0.5 Square Feet per each Linear Foot of Building Facade [] 4. PROJECTING 0.
DEFINITE ADDRESS Common	BUSINESS NAME Alpine Computer Solution	CONTRAC	TOR Soundon	gh Signs			
Proposed Sign Square Feet [] 8 Area of Proposed Sign Square Feet [] 9	STREET ADDRESS 809 N. Ave	LICENSE N	LICENSE NO. 2020719				

Face Change Orth (2.3 & 4): [192. ROOF [1] 3. FREE-STANDING [2] Traffic Lanes - 0.75 Square Feet x Street Frontage 4 or more Traffic Lanes - 1.5 Square Feet x Street Frontage [1] 4. PROJECTING [1] 0.5 Square Feet per each Linear Foot of Building Facade [1] Existing Externally or Internally Illuminated - No Change in Electrical Service [1] Non-Illuminated [1] A rea of Proposed Sign	OWNER ADDRESS	TELEPHO	TELEPHONE NO. 243-/383				

2 Square Feet per Linear Foot of Building Facade [] 3. FREE-STANDING 2 Traffic Lanes - 0.75 Square Feet x Street Frontage 4 or more Traffic Lanes - 1.5 Square Feet x Street Frontage 0.5 Square Feet per each Linear Foot of Building Facade [] Linear Feet per each Linear Foot of Building Facade [] Non-Illuminated [] Non-Il		Enlear 1 oot of Ban	iding i ucude				
4 or more Traffic Lanes - 1.5 Square Feet x Street Frontage 0.5 Square Feet per each Linear Foot of Building Facade [Dexisting Externally or Internally Illuminated - No Change in Electrical Service [] Non-Illuminated [1] 4. 
Non-Illuminated No Change in Electrical Service Non-Illuminated							
Square Feet (1,2,4) Building Facade							
Street Frontage	[1] Existing Externally or Internally Illuminated - No Cha	nge in Electrical Se	ervice []	Non-Illuminated			
Existing Signage/Type: Rf. mt Signage Allowed on Parcel: No. 1 Me Building Hush Mt. Total Existing: Total Existing: NOTE: No sign may exceed 300 square feet. A separate sign permit is required for each sign. 'Attach a sketch of proposed and existing signage including types, dimensions, lettering, abutting streets, alleys, easements, property lines, and locations. Roof signs shall be manufactured such that no guy wires, braces or supports shall be visible. 
Signage Allowed on Parcel: No. 1 Average Building 140 Sq. Ft. Free-Standing 1/2, 5 Sq. Ft. Total Existing: Total Allowed: 140 Sq. Ft. Total			● FOR OFFIC	E USE ONLY •			
Hush Mat. 10 18. Sq. Ft. Sq. Ft. Total Existing: NOTE: No sign may exceed 300 square feet. A separate sign permit is required for each sign. 'Attach a sketch of proposed and existing signage including types, dimensions, lettering, abutting streets, alleys, easements, property lines, and locations. Roof signs shall be manufactured such that no guy wires, braces or supports shall be visible. Sandrudday 10/2403 Augustum May May May May 10/2103	PC n 59			11 11 0			
NOTE: No sign may exceed 300 square feet. A separate sign permit is required for each sign. 'Attach a sketch of proposed and existing signage including types, dimensions, lettering, abutting streets, alleys, easements, property lines, and locations. Roof signs shall be manufactured such that no guy wires, braces or supports shall be visible. Saudubbbbbbbbbbbbbbbbbbbbbbbbbbbbbbbbbbb	La se tondina 52	Sq. Ft.	Free-Standing	112, Sq. Ft.			
proposed and existing signage including types, dimensions, lettering, abutting streets, alleys, easements, property lines, and locations. Roof signs shall be manufactured such that no guy wires, braces or supports shall be visible.	Friestanding 52 Total Existing: /21	Sq. Ft.		11/2			
(White: Community Dayslanment) (Canamy Applicant) (Pink: Code Enforcement)	Friestanding 52 Total Existing: /2 COMMENTS:	Sq. Ft.		11/2			


8

18.75 sqft

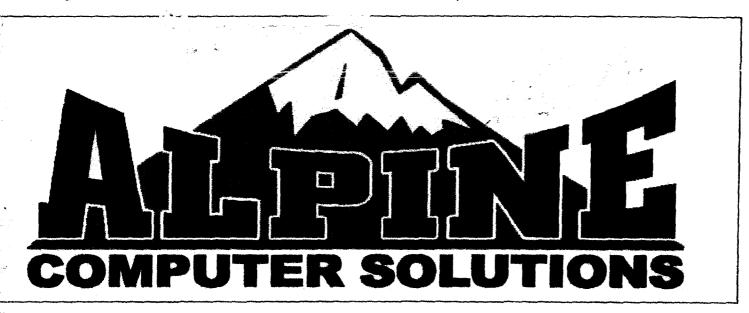

1 1/2" Frame. Above measurements include the 1 1/2 inch frame.

\$

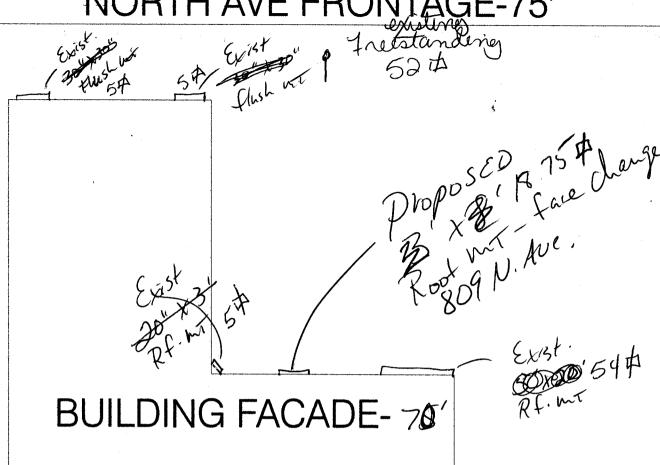

8TH STREET FRONTAGE-150'

BUILDING FACADE-130