



SIGN PERMIT

2

Community Development Department
250 North 5th Street
Grand Junction, CO 81501
(970) 244-1430

Permit No. _____
Date Submitted 6/10/03
FEE \$ 25.00
Tax Schedule 2945-113-25-005
Zone C-1

2A

BUSINESS NAME Boggsies Carwash
STREET ADDRESS 1110N6th St
PROPERTY OWNER Terrance Boggs
OWNER ADDRESS Same

CONTRACTOR Platinum Sign
LICENSE NO. 2030603
ADDRESS 2916 I-70B
TELEPHONE NO. 248-9677

- 1. FLUSH WALL 2 Square Feet per Linear Foot of Building Facade
- Face Change Only (2,3 & 4):
- 2. ROOF 2 Square Feet per Linear Foot of Building Facade
- 3. FREE-STANDING 2 Traffic Lanes - 0.75 Square Feet x Street Frontage
4 or more Traffic Lanes - 1.5 Square Feet x Street Frontage
- 4. PROJECTING 0.5 Square Feet per each Linear Foot of Building Facade

Existing Externally or Internally Illuminated - No Change in Electrical Service Non-Illuminated

(1 - 4) Area of Proposed Sign 53 Square Feet
(1,2,4) Building Facade 42' Linear Feet
(1 - 4) Street Frontage 238 Linear Feet
(2,3,4) Height to Top of Sign _____ Feet Clearance to Grade _____ Feet

Existing Signage/Type:	
	Sq. Ft.
	Sq. Ft.
	Sq. Ft.
Total Existing:	Sq. Ft.

● FOR OFFICE USE ONLY ●	
Signage Allowed on Parcel:	<u>Greenwood Ave</u> <u>N 6th St</u>
Building	<u>80</u> Sq. Ft.
Free-Standing	<u>178.5</u> Sq. Ft.
Total Allowed:	<u>178.5</u> Sq. Ft.

COMMENTS: Individual Plastic letters mounted to wall.


NOTE: No sign may exceed 300 square feet. A separate sign permit is required for each sign. Attach a sketch of proposed and existing signage including types, dimensions, lettering, abutting streets, alleys, easements, property lines, and locations. Roof signs shall be manufactured such that no guy wires, braces, or supports shall be visible.

[Signature] 6-10-03 Aisha Progon 6/10/03
Applicant's Signature Date Community Development Approval Date

(White: Community Development) (Canary: Applicant) (Pink: Code Enforcement)



SIGN PERMIT

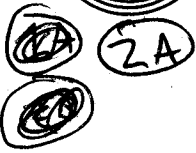

Community Development Department
 250 North 5th Street
 Grand Junction, CO 81501
 (970) 244-1430

Permit No. _____
 Date Submitted 6/10/03
 FEE \$ 5.00
 Tax Schedule 2945-113-25-005
 Zone C-1

BUSINESS NAME Boygies Carwash
 STREET ADDRESS 1170 N 6th St
 PROPERTY OWNER Terry Boggs
 OWNER ADDRESS Same

CONTRACTOR Platinum Sign
 LICENSE NO. 2030603
 ADDRESS 2916 E-70 B
 TELEPHONE NO. 248-9677

- 1. FLUSH WALL 2 Square Feet per Linear Foot of Building Facade
- Face Change Only (2,3 & 4):**
- 2. ROOF 2 Square Feet per Linear Foot of Building Facade
- 3. FREE-STANDING 2 Traffic Lanes - 0.75 Square Feet x Street Frontage
4 or more Traffic Lanes - 1.5 Square Feet x Street Frontage
- 4. PROJECTING 0.5 Square Feet per each Linear Foot of Building Facade

Existing Externally or Internally Illuminated - No Change in Electrical Service Non-Illuminated

(1 - 4) Area of Proposed Sign 53 Square Feet
 (1,2,4) Building Facade 110 Linear Feet
 (1 - 4) Street Frontage 156 Linear Feet
 (2,3,4) Height to Top of Sign _____ Feet Clearance to Grade _____ Feet

Existing Signage/Type:	
Flushwall Sign ZA	53 Sq. Ft.
	Sq. Ft.
	Sq. Ft.
Total Existing:	53 Sq. Ft.

● FOR OFFICE USE ONLY ●	
Signage Allowed on Parcel: <u>N 6th AVE</u>	
Building	220 Sq. Ft.
Free-Standing	117 Sq. Ft.
Total Allowed:	220 Sq. Ft.

COMMENTS: _____

NOTE: No sign may exceed 300 square feet. A separate sign permit is required for each sign. Attach a sketch of proposed and existing signage including types, dimensions, lettering, abutting streets, alleys, easements, property lines, and locations. Roof signs shall be manufactured such that no guy wires, braces or supports shall be visible.

[Signature] 6-10-03 [Signature] 6/10/03
 Applicant's Signature Date Community Development Approval Date

(White: Community Development) (Canary: Applicant) (Pink: Code Enforcement)



SIGN PERMIT

Community Development Department
250 North 5th Street
Grand Junction, CO 81501
(970) 244-1430

Permit No. _____
Date Submitted 6/10/03
FEE \$ 5.00
Tax Schedule 2945-113-25-005
Zone C-1

1B

BUSINESS NAME Bodgies Carwash
STREET ADDRESS 1170 6th St
PROPERTY OWNER Terry Boggs
OWNER ADDRESS same

CONTRACTOR Platinum Sign Co
LICENSE NO. 2030603
ADDRESS 2916 I-70B
TELEPHONE NO. 248-9677

- 1. FLUSH WALL 2 Square Feet per Linear Foot of Building Facade
- Face Change Only (2,3 & 4):**
- 2. ROOF 2 Square Feet per Linear Foot of Building Facade
- 3. FREE-STANDING 2 Traffic Lanes - 0.75 Square Feet x Street Frontage
4 or more Traffic Lanes - 1.5 Square Feet x Street Frontage
- 4. PROJECTING 0.5 Square Feet per each Linear Foot of Building Facade

Existing Externally or Internally Illuminated - No Change in Electrical Service Non-Illuminated

(1 - 4) Area of Proposed Sign 18.2 Square Feet
(1,2,4) Building Facade 43 Linear Feet
(1 - 4) Street Frontage 156 Linear Feet
(2,3,4) Height to Top of Sign _____ Feet Clearance to Grade _____ Feet

Existing Signage/Type:	
Flushwall Sign 2A	53 Sq. Ft.
Flushwall Sign 1A	53 Sq. Ft.
	Sq. Ft.
Total Existing:	106 Sq. Ft.

● FOR OFFICE USE ONLY ●	
Signage Allowed on Parcel: <u>Glenwood Ave</u>	
Building	86 Sq. Ft.
Free-Standing	178.5 Sq. Ft.
Total Allowed:	178.5 Sq. Ft.

COMMENTS:

NOTE: No sign may exceed 300 square feet. A separate sign permit is required for each sign. Attach a sketch of proposed and existing signage including types, dimensions, lettering, abutting streets, alleys, easements, property lines, and locations. Roof signs shall be manufactured such that no guy wires, braces or supports shall be visible.

Applicant's Signature [Signature] Date 6/17/03 Community Development Approval [Signature] Date 6/10/03


(White: Community Development)

(Canary: Applicant)

(Pink: Code Enforcement)

Glenwood Ave.

6th Ave

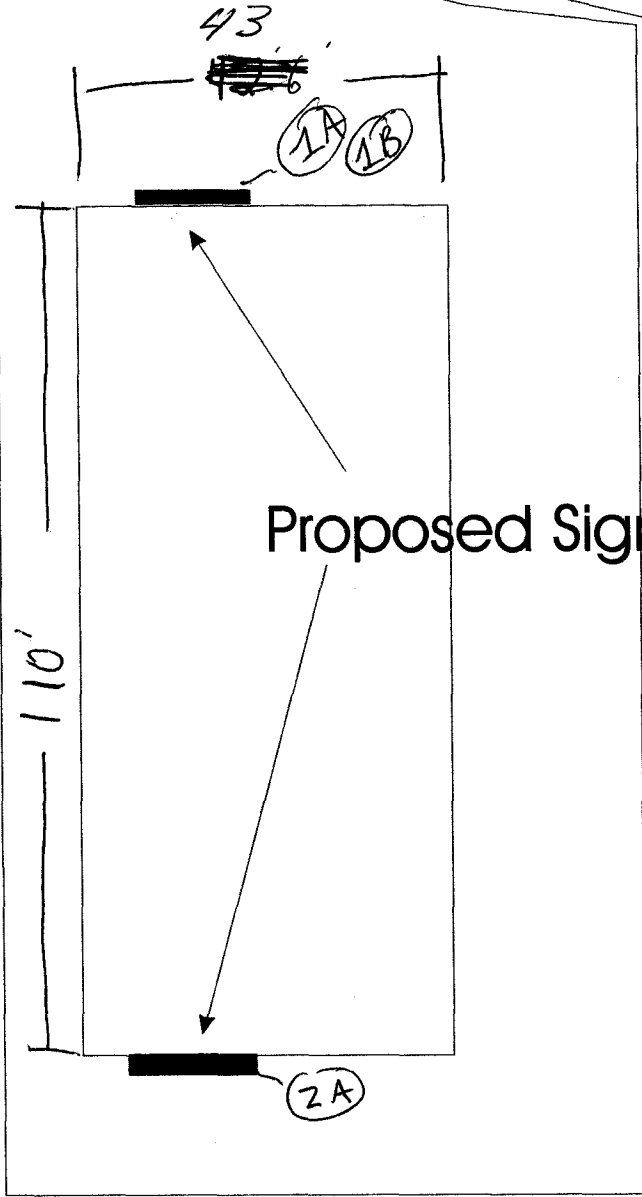

Proposed Signs



1110 6th ave

10
3A

2 SIGNS
36"

212"
Car Wash
TIMES BOLD

1B

1

24"

109"
ENTER
FUTURA


1

1

12"

40"
EXIT
FUTURA

261-4762 call
Tony Basso

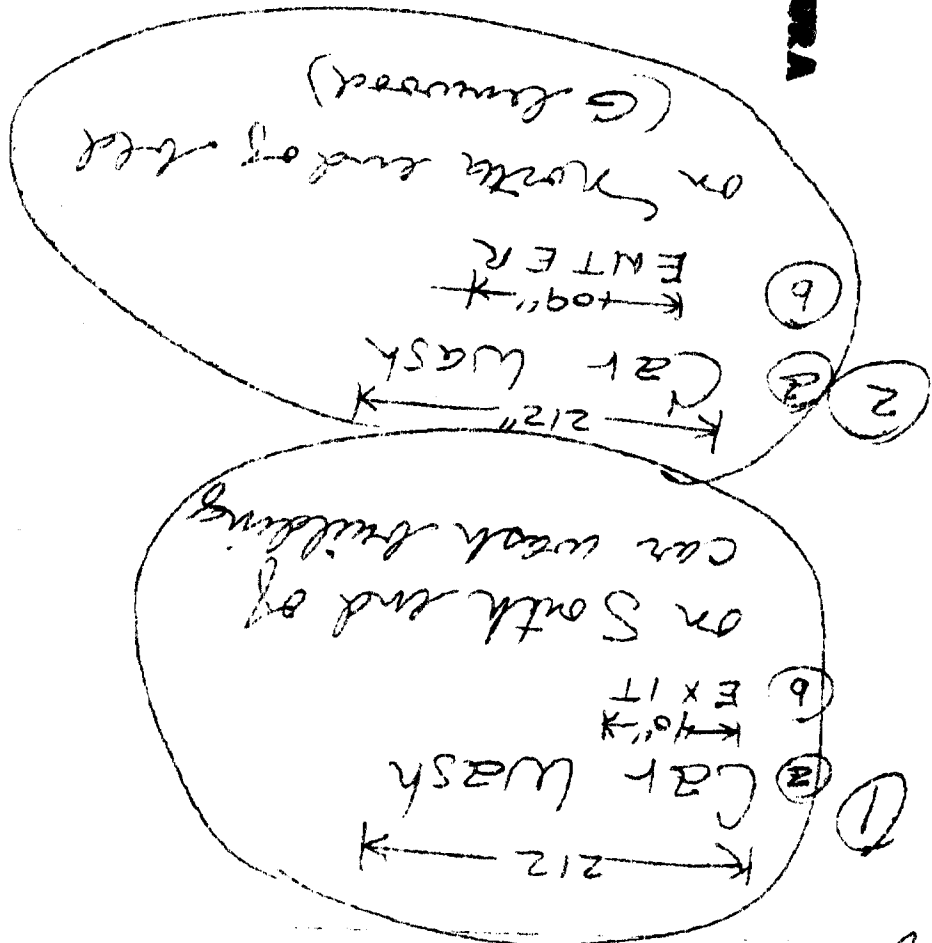

Platinum Signs
ATTN: MIKE

FAX 248 5444



SIGN PERMIT

2

Community Development Department
250 North 5th Street
Grand Junction, CO 81501
(970) 244-1430

Permit No. _____
Date Submitted 6/10/03
FEE \$ 25.00
Tax Schedule 2945-113-25-005
Zone C-1

2A

BUSINESS NAME Boggsies Carwash
STREET ADDRESS 1110 N 6th St
PROPERTY OWNER Terrance Boggs
OWNER ADDRESS Same

CONTRACTOR Platinum Sign
LICENSE NO. 2030603
ADDRESS 2916 I-70B
TELEPHONE NO. 248-9677

- 1. FLUSH WALL 2 Square Feet per Linear Foot of Building Facade
- Face Change Only (2,3 & 4):**
- 2. ROOF 2 Square Feet per Linear Foot of Building Facade
- 3. FREE-STANDING 2 Traffic Lanes - 0.75 Square Feet x Street Frontage
4 or more Traffic Lanes - 1.5 Square Feet x Street Frontage
- 4. PROJECTING 0.5 Square Feet per each Linear Foot of Building Facade

Existing Externally or Internally Illuminated - No Change in Electrical Service Non-Illuminated

(1 - 4) Area of Proposed Sign 53 Square Feet
(1,2,4) Building Facade 42 Linear Feet
(1 - 4) Street Frontage 238 Linear Feet
(2,3,4) Height to Top of Sign _____ Feet Clearance to Grade _____ Feet

Existing Signage/Type:	
	Sq. Ft.
	Sq. Ft.
	Sq. Ft.
Total Existing:	Sq. Ft.

● FOR OFFICE USE ONLY ●	
Signage Allowed on Parcel:	<u>Elmwood Ave</u> <u>116th St</u>
Building	<u>86</u> Sq. Ft.
Free-Standing	<u>178.5</u> Sq. Ft.
Total Allowed:	<u>178.5</u> Sq. Ft.

COMMENTS: Individual Plastic letters mounted to wall.

NOTE: No sign may exceed 300 square feet. A separate sign permit is required for each sign. Attach a sketch of proposed and existing signage including types, dimensions, lettering, abutting streets, alleys, easements, property lines, and locations. Roof signs shall be manufactured such that no guy wires, braces or supports shall be visible.

[Signature] 6-10-03 [Signature] 6/10/03
Applicant's Signature Date Community Development Approval Date

(White: Community Development) (Canary: Applicant) (Pink: Code Enforcement)



SIGN PERMIT

2A
2A

Community Development Department
250 North 5th Street
Grand Junction, CO 81501
(970) 244-1430

Permit No. _____
Date Submitted 6/10/03
FEE \$ 5.00
Tax Schedule 2945-113-25-005
Zone C-1

BUSINESS NAME Boygies Carwash
STREET ADDRESS 1170 N 6th St
PROPERTY OWNER Terry Boggs
OWNER ADDRESS Same

CONTRACTOR Platinum Sign
LICENSE NO. 2030603
ADDRESS 2916 E-70 B
TELEPHONE NO. 248-9677

- 1. FLUSH WALL 2 Square Feet per Linear Foot of Building Facade
- Face Change Only (2,3 & 4):
- 2. ROOF 2 Square Feet per Linear Foot of Building Facade
- 3. FREE-STANDING 2 Traffic Lanes - 0.75 Square Feet x Street Frontage
4 or more Traffic Lanes - 1.5 Square Feet x Street Frontage
- 4. PROJECTING 0.5 Square Feet per each Linear Foot of Building Facade

Existing Externally or Internally Illuminated - No Change in Electrical Service Non-Illuminated

(1 - 4) Area of Proposed Sign 53 Square Feet
(1,2,4) Building Facade 110 Linear Feet
(1 - 4) Street Frontage 156 Linear Feet
(2,3,4) Height to Top of Sign _____ Feet Clearance to Grade _____ Feet

Existing Signage/Type:	
Flushwall Sign 2A	53 Sq. Ft.
	Sq. Ft.
	Sq. Ft.
Total Existing:	53 Sq. Ft.

● FOR OFFICE USE ONLY ●	
Signage Allowed on Parcel: <u>N 6th AVE</u>	
Building	220 Sq. Ft.
Free-Standing	117 Sq. Ft.
Total Allowed:	220 Sq. Ft.

COMMENTS: _____

NOTE: No sign may exceed 300 square feet. A separate sign permit is required for each sign. Attach a sketch of proposed and existing signage including types, dimensions, lettering, abutting streets, alleys, easements, property lines, and locations. Roof signs shall be manufactured such that no guy wires, braces or supports shall be visible.

[Signature] 6-10-03 [Signature] 6/10/03
Applicant's Signature Date Community Development Approval Date

(White: Community Development) (Canary: Applicant) (Pink: Code Enforcement)



SIGN PERMIT

Community Development Department
250 North 5th Street
Grand Junction, CO 81501
(970) 244-1430

Permit No. _____
Date Submitted 6/10/03
FEE \$ 5.00
Tax Schedule 2945-113-25-005
Zone C-1

1B

BUSINESS NAME Boogsies Carwash
STREET ADDRESS 1178 6th St
PROPERTY OWNER Terry Boogs
OWNER ADDRESS Same

CONTRACTOR Platinum Sign Co
LICENSE NO. 2030603
ADDRESS 2916 I-70B
TELEPHONE NO. 248-9677

- 1. FLUSH WALL 2 Square Feet per Linear Foot of Building Facade
- Face Change Only (2,3 & 4):**
- 2. ROOF 2 Square Feet per Linear Foot of Building Facade
- 3. FREE-STANDING 2 Traffic Lanes - 0.75 Square Feet x Street Frontage
4 or more Traffic Lanes - 1.5 Square Feet x Street Frontage
- 4. PROJECTING 0.5 Square Feet per each Linear Foot of Building Facade

Existing Externally or Internally Illuminated - No Change in Electrical Service Non-Illuminated

- (1 - 4) Area of Proposed Sign 18.2 Square Feet
- (1,2,4) Building Facade 43 Linear Feet
- (1 - 4) Street Frontage 156 Linear Feet
- (2,3,4) Height to Top of Sign _____ Feet Clearance to Grade _____ Feet

Existing Signage/Type:		
Flushwall Sign 2A	53	Sq. Ft.
Flushwall Sign 1A	53	Sq. Ft.
		Sq. Ft.
Total Existing:	106	Sq. Ft.

● FOR OFFICE USE ONLY ●		
Signage Allowed on Parcel: <u>Glenwood Ave</u>		
Building	86	Sq. Ft.
Free-Standing	178.5	Sq. Ft.
Total Allowed:	178.5	Sq. Ft.

COMMENTS: _____

NOTE: No sign may exceed 300 square feet. A separate sign permit is required for each sign. Attach a sketch of proposed and existing signage including types, dimensions, lettering, abutting streets, alleys, easements, property lines, and locations. Roof signs shall be manufactured such that no guy wires, braces or supports shall be visible.

Applicant's Signature _____

Date 6/17/03

Community Development Approval Mishi Dragon

Date 6/10/03

(White: Community Development)

(Canary: Applicant)

(Pink: Code Enforcement)