



SIGN PERMIT

Community Development Department
 250 North 5th Street
 Grand Junction, CO 81501
 (970) 244-1430

Permit No. _____
 Date Submitted 9/1/04
 FEE \$ 25.00
 Tax Schedule 2045-103-37012
 Zone C-2

BUSINESS NAME Adoba Mexican Grill CONTRACTOR Bud's Signs
 STREET ADDRESS 2536 Rimrock Ave LICENSE NO. 2040162
 PROPERTY OWNER IME Development ADDRESS 1055 vte
 OWNER ADDRESS _____ TELEPHONE NO. 245-7700

1. FLUSH WALL 2 Square Feet per Linear Foot of Building Facade
Face Change Only (2,3 & 4):
 2. ROOF 2 Square Feet per Linear Foot of Building Facade
 3. FREE-STANDING 2 Traffic Lanes - 0.75 Square Feet x Street Frontage
 4 or more Traffic Lanes - 1.5 Square Feet x Street Frontage
 4. PROJECTING 0.5 Square Feet per each Linear Foot of Building Facade

Existing Externally or Internally Illuminated - No Change in Electrical Service Non-Illuminated

(1 - 4) Area of Proposed Sign 34.25 Square Feet
 (1,2,4) Building Facade 180 Linear Feet
 (1 - 4) Street Frontage _____ Linear Feet
 (2,3,4) Height to Top of Sign 15 Feet Clearance to Grade _____ Feet

Existing Signage/Type:	
<u>Game Stop fw</u>	<u>32.56</u> Sq. Ft.
	Sq. Ft.
	Sq. Ft.
Total Existing:	<u>32.56</u> Sq. Ft.

● FOR OFFICE USE ONLY ●	
Signage Allowed on Parcel: <u>Rimrock</u>	
Building	<u>315</u> Sq. Ft.
Free-Standing	Sq. Ft.
Total Allowed:	<u>315</u> Sq. Ft.

COMMENTS: Front of store
1.75 ft of signage of linear foot of bldg facade

NOTE: No sign may exceed 300 square feet. A separate sign permit is required for each sign. Attach a sketch of proposed and existing signage including types, dimensions, lettering, abutting streets, alleys, easements, property lines, and locations. Roof signs shall be manufactured such that no guy wires, braces or supports shall be visible.

Em Bennett 9-9-04 C. Faye Hall 9/7/04
 Applicant's Signature Date Community Development Approval Date

(White: Community Development) (Canary: Applicant) (Pink: Code Enforcement)

(B)



SIGN PERMIT

Community Development Department
250 North 5th Street
Grand Junction, CO 81501
(970) 244-1430

Permit No. _____
Date Submitted 9/1/04
FEE \$ 5.00
Tax Schedule 2145-103-37-012
Zone C-2

BUSINESS NAME Adoba Mexican Grill CONTRACTOR Bud's Signs
STREET ADDRESS 2536 Remrock Ave LICENSE NO. 2040162
PROPERTY OWNER TMF Development ADDRESS 1055 vte
OWNER ADDRESS _____ TELEPHONE NO. 245-7700

- 1. FLUSH WALL 2 Square Feet per Linear Foot of Building Facade
- Face Change Only (2,3 & 4):
- 2. ROOF 2 Square Feet per Linear Foot of Building Facade
- 3. FREE-STANDING 2 Traffic Lanes - 0.75 Square Feet x Street Frontage
4 or more Traffic Lanes - 1.5 Square Feet x Street Frontage
- 4. PROJECTING 0.5 Square Feet per each Linear Foot of Building Facade

Existing Externally or Internally Illuminated - No Change in Electrical Service Non-Illuminated

(1 - 4) Area of Proposed Sign 14.4 Square Feet
(1,2,4) Building Facade 180 Linear Feet
(1 - 4) Street Frontage _____ Linear Feet
(2,3,4) Height to Top of Sign _____ Feet Clearance to Grade _____ Feet

Existing Signage/Type:	
<u>FW</u>	<u>34.25</u> Sq. Ft.
<u>Same step fw</u>	<u>32.56</u> Sq. Ft.
	Sq. Ft.
Total Existing:	<u>66.81</u> Sq. Ft.

● FOR OFFICE USE ONLY ●	
Signage Allowed on Parcel: <u>Remrock</u>	
Building	<u>315</u> Sq. Ft.
Free-Standing	Sq. Ft.
Total Allowed:	<u>315</u> Sq. Ft.

COMMENTS: 1.75 LF of signage of linear foot of bldg facade

NOTE: No sign may exceed 300 square feet. A separate sign permit is required for each sign. Attach a sketch of proposed and existing signage including types, dimensions, lettering, abutting streets, alleys, easements, property lines, and locations. Roof signs shall be manufactured such that no guy wires, braces or supports shall be visible.

Eric Bennett 9-9-04 City of Grand Junction 9/7/04
Applicant's Signature Date Community Development Approval Date





(White: Community Development) (Canary: Applicant) (Pink: Code Enforcement)

Qdoba
MEXICAN

22.5
7.25

GRILL

4.5
34.25 JA

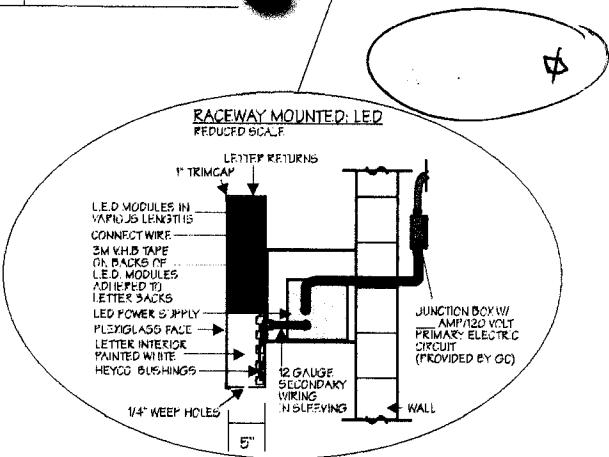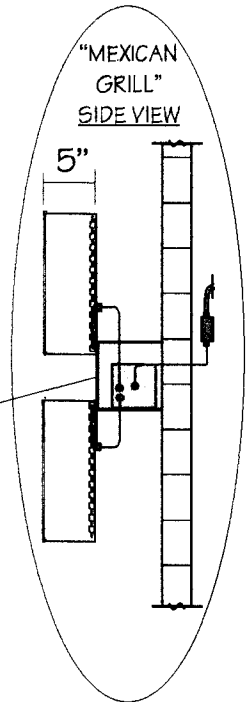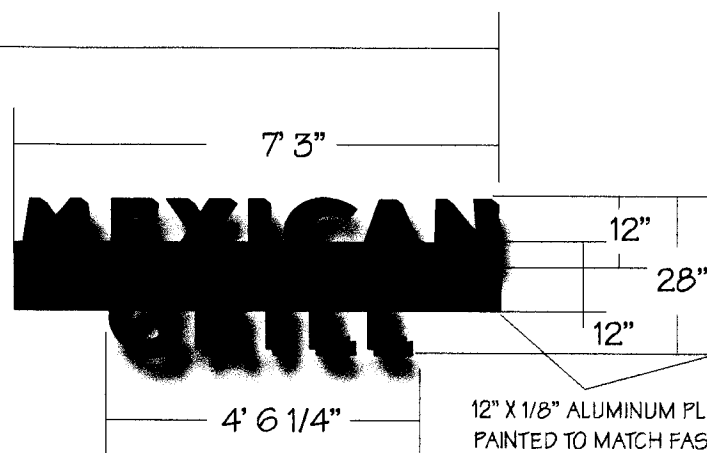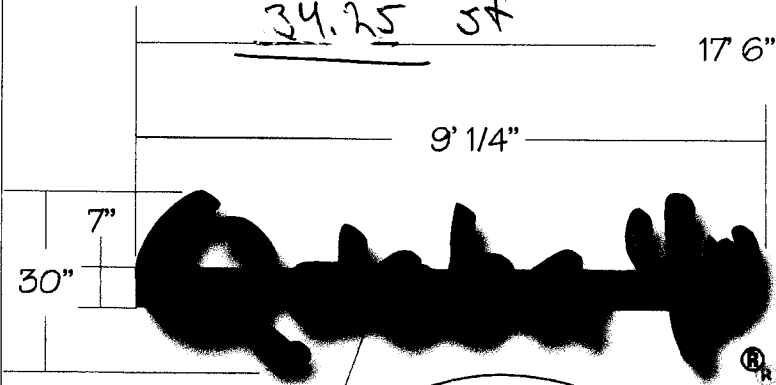

PMS COLORS
3630-143 POPPY RED PMS# 1788C
3630-83 REGAL RED PMS# 187C
3630-136 LIME GREEN PMS# 368C

LED INNER ILLUMINATED PAN CHANNEL LETTERS RACEWAY MOUNTED 30" LINEAR STACKED LAYOUT 35 SQ. FT. A

- .063 ALUMINUM BACKS .040 PRE-FINISHED BLACK RETURNS
- 1/8" MILKY WHITE #2447 ACRYLIC FACES W/ 1" BLACK JEWELITE TRIMCAP
- ("QDOBA MEXICAN GRILL": APPLY 3M VINYL #3630-143 POPPY RED)
- ("CACTUS": APPLY 3M VINYL #230-136 GREEN)
- ("FLOWER": APPLY 3M VINYL #3630-83 REGAL RED)
- INNER ILLUMINATE LED'S GELCORE TETRA RED/ORANGE, SKU # GERCLLS1 (QDOBA, MEXICAN GRILL, FLOWER)
- INNER ILLUMINATE LED'S GELCORE TETRA GREEN, SKU # GEGCLLS1 (CACTUS)
- REGISTRATION MARK: 1/4" WHITE ACRYLIC W/ APPLIED 3M VINYL #3630-143
- UL APPROVED AND LABELED

AD LIGHT WILL ENDEAVOR TO CLOSELY MATCH COLORS, INCLUDING PMS, WHERE SPECIFIED WE CANNOT GUARANTEE MATCHES DUE TO VARYING COMPATIBILITY OF SURFACE MATERIALS AND PAINTS USED. ALL ILLUMINATED DISPLAYS RUN AT 120 VOLT UNLESS OTHERWISE SPECIFIED. 120 VAC, PRIMARY POWER TO AND FINAL HOOKUP BY OTHERS SIGN CIRCUITS REQUIRE DEDICATED HOT, NEUTRAL, AND GROUND TERMINATING AT PANEL.




THIS DESIGN IS THE PROPERTY OF AD LIGHT + SIGN AND IS SUBMITTED FOR YOUR USE IN CONJUNCTION WITH A PROJECT BEING PLANNED FOR YOU BY AD-LIGHT. IT CANNOT BE REPRODUCED EITHER IN WHOLE OR IN PART WITHOUT THEIR WRITTEN CONSENT.

CLIENT:	Qdoba MEXICAN GRILL
SIGN TYPE:	RIM ROCK
DATE:	8/2/04
SALESPERSON:	CATHERINE ALLEN

SCALE:	3/8" = 1'
CLIENT APPROVAL	
DATE:	

DO NOT MANUFACTURE WITHOUT APPROVALS THE BOXES BELOW MUST BE INITIALED AND DATED PRIOR TO MANUFACTURING		
PRODUCTION APPROVAL TO MFR.		
INITIALS:	DATE:	PG. 1 OF 2

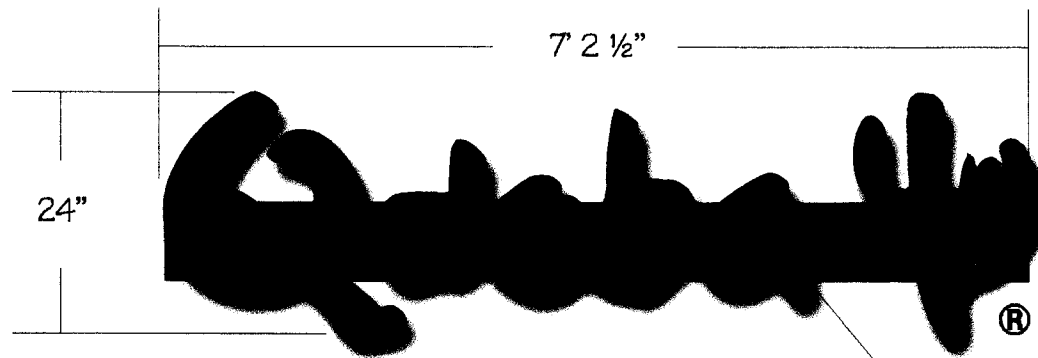


14.4 ⚡

LED INNER ILLUMINATED PAN CHANNEL LETTERS RACEWAY MOUNTED
24 LINEAR LAYOUT 155Q. FT. **B**

.063 ALUMINUM BACKS .040 PRE-FINISHED BLACK RETURNS
 1/8" MILKY WHITE #2447 ACRYLIC FACES W/ 1" BLACK JEWELITE TRIMCAP
 ("QDOBA MEXICAN GRILL": APPLY 3M VINYL #3630-143 POPPY RED)
 ("CACTUS": APPLY 3M VINYL #230-136 GREEN),
 ("FLOWER": APPLY 3M VINYL #3630-83 REGAL RED)
 INNER ILLUMINATE LED'S GELCORE TETRA RED/ORANGE, SKU # GERCL51
 (QDOBA, MEXICAN GRILL, FLOWER)
 INNER ILLUMINATE LED'S GELCORE TETRA GREEN, SKU # GEGCL51 (CACTUS)
 REGISTRATION MARK: 1/4" WHITE ACRYLIC W/ APPLIED 3M VINYL #3630-143
 UL APPROVED AND LABELED

<u>PMS COLORS</u>	
3630-143	POPPY RED PMS# 1788C
3630-83	REGAL RED PMS# 187C
3630-136	LIME GREEN PMS# 368C

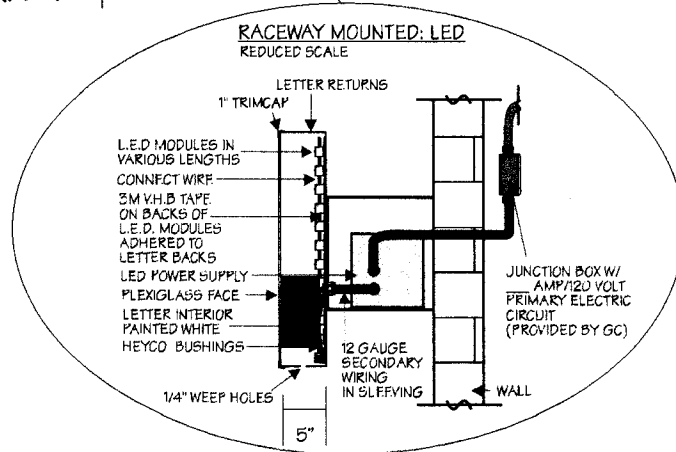

AD LIGHT WILL ENDEAVOR TO CLOSELY MATCH COLORS, INCLUDING PMS, WHERE SPECIFIED WE CANNOT GUARANTEE MATCHES DUE TO VARYING COMPATIBILITY OF SURFACE MATERIALS AND PAINTS USED. ALL ILLUMINATED DISPLAYS BUILT 120 VOLT UNLESS OTHERWISE SPECIFIED. 120 VAC, PRIMARY POWER TO AND FINAL HOOKUP BY OTHERS SIGN CIRCUIT(S) REQUIRE DEDICATED HOT, NEUTRAL AND GROUND TERMINATING AT PANEL



THIS DESIGN IS THE PROPERTY OF AD LIGHT + SIGN AND IS SUBMITTED FOR YOUR USE IN CONJUNCTION WITH A PROJECT BEING PLANNED FOR YOU BY AD-LIGHT. IT CANNOT BE REPRODUCED EITHER IN WHOLE OR IN PART WITHOUT THEIR WRITTEN CONSENT.

CLIENT:	QDOBA MEXICAN GRILL
SIGN TYPE:	RIMROCK
DATE:	8/2/04
SALESPERSON:	CATHERINE ALLEN

SCALE:	3/4" = 1'
CLIENT APPROVAL	
DATE:	

DO NOT MANUFACTURE WITHOUT APPROVALS	
THE BOXES BELOW MUST BE INITIALED AND DATED PRIOR TO MANUFACTURING	
PRODUCTION APPROVAL TO MFR.	
INITIALS:	DATE:

