



# SIGN CLEARANCE

Community Development Department  
250 North 5<sup>th</sup> Street  
Grand Junction CO 81501  
(970) 244-1430

B-3

Clearance No. \_\_\_\_\_  
Date Submitted 4/18/05  
Fee \$ 500  
Zone PD

TAX SCHEDULE 2945-111-02-971 CONTRACTOR Bad's Signs  
BUSINESS NAME St. Mary's LICENSE NO. 2050128  
STREET ADDRESS 425 Patterson ADDRESS 1055 Ute Ave.  
PROPERTY OWNER SAME TELEPHONE NO. 245-7700  
OWNER ADDRESS \_\_\_\_\_ CONTACT PERSON TODD

- 1. FLUSH WALL 2 Square Feet per Linear Foot of Building Facade
- 2. ROOF 2 Square Feet per Linear Foot of Building Facade
- 3. FREE-STANDING 2 Traffic Lanes - 0.75 Square Feet x Street Frontage  
4 or more Traffic Lanes - 1.5 Square Feet x Street Frontage
- 4. PROJECTING 0.5 Square Feet per each Linear Foot of Building Facade
- 5. OFF-PREMISE See #3 Spacing Requirements; Not > 300 Square Feet or < 15 Square Feet

Externally Illuminated       Internally Illuminated       Non-Illuminated

(1 - 5) Area of Proposed Sign: 68.10 Square Feet  
(1,2,4) Building Façade: \_\_\_\_\_ Linear Feet      Building Façade Direction:    North    South    East    West  
(1 - 4) Street Frontage: \_\_\_\_\_ Linear Feet      Name of Street: \_\_\_\_\_  
(2 - 5) Height to Top of Sign: \_\_\_\_\_ Feet      Clearance to Grade: \_\_\_\_\_ Feet  
(5) Distance from all Existing Off-Premise Signs within 600 Feet: \_\_\_\_\_ Feet

**EXISTING SIGNAGE/TYPE & SQUARE FOOTAGE:**

_____	_____	Sq. Ft.
_____	_____	Sq. Ft.
_____	_____	Sq. Ft.
_____	_____	Sq. Ft.
Total Existing:		_____ Sq. Ft.

**FOR OFFICE USE ONLY**

Signage Allowed on Parcel for ROW:

Building file \_\_\_\_\_ Sq. Ft.  
Free-Standing \_\_\_\_\_ Sq. Ft.  
Total Allowed: \_\_\_\_\_ Sq. Ft.

COMMENTS: See Master Plans

**NOTE:** No sign may exceed 300 square feet. A separate sign clearance is required for each sign. Attach a sketch, to scale, of proposed and existing signage including types, dimensions and lettering. Attach a plot plan, to scale, showing: abutting streets, alleys, easements, driveways, encroachments, property lines, distances from existing buildings to proposed signs and required setbacks. **A SEPARATE PERMIT FROM THE BUILDING DEPARTMENT IS ALSO REQUIRED.**

I hereby attest that the information on this form and the attached sketches are true and accurate.

Jozel Socher      4/18/05      Lisa Cox      4/26/2005  
Applicant's Signature      Date      Community Development Approval      Date

(White: Community Development)      (Canary: Applicant)      (Pink: Building Dept)      (Goldenrod: Code Enforcement)



# SIGN CLEARANCE

Community Development Department  
250 North 5<sup>th</sup> Street  
Grand Junction CO 81501  
(970) 244-1430

C-1

Clearance No.	_____
Date Submitted	<u>4/18/05</u>
Fee \$	<u>5.00</u>
Zone	<u>PD</u>

TAX SCHEDULE	<u>2945-111-02-971</u>	CONTRACTOR	<u>Bud's Signs</u>
BUSINESS NAME	<u>St. Mary's</u>	LICENSE NO.	<u>2050128</u>
STREET ADDRESS	<u>425 Patterson</u>	ADDRESS	<u>1055 Ute Ave.</u>
PROPERTY OWNER	<u>SAME</u>	TELEPHONE NO.	<u>245-7700</u>
OWNER ADDRESS	_____	CONTACT PERSON	<u>TODD</u>

- |                                     |                  |   |
|-------------------------------------|------------------|---|
| <input type="checkbox"/>            | 1. FLUSH WALL    | 2 Square Feet per Linear Foot of Building Facade  |
| <input type="checkbox"/>            | 2. ROOF          | 2 Square Feet per Linear Foot of Building Facade  |
| <input checked="" type="checkbox"/> | 3. FREE-STANDING | 2 Traffic Lanes - 0.75 Square Feet x Street Frontage<br>4 or more Traffic Lanes - 1.5 Square Feet x Street Frontage |
| <input type="checkbox"/>            | 4. PROJECTING    | 0.5 Square Feet per each Linear Foot of Building Facade   |
| <input type="checkbox"/>            | 5. OFF-PREMISE   | See #3 Spacing Requirements; Not > 300 Square Feet or < 15 Square Feet  |

Externally Illuminated       Internally Illuminated       Non-Illuminated

(1 - 5) Area of Proposed Sign: 49.00 Square Feet

(1,2,4) Building Façade: \_\_\_\_\_ Linear Feet      Building Façade Direction:    North    South    East    West

(1 - 4) Street Frontage: \_\_\_\_\_ Linear Feet      Name of Street: \_\_\_\_\_

(2 - 5) Height to Top of Sign: \_\_\_\_\_ Feet      Clearance to Grade: \_\_\_\_\_ Feet

(5) Distance from all Existing Off-Premise Signs within 600 Feet: \_\_\_\_\_ Feet

**EXISTING SIGNAGE/TYPE & SQUARE FOOTAGE:**

_____	_____	Sq. Ft.
_____	_____	Sq. Ft.
_____	_____	Sq. Ft.
Total Existing:		_____ Sq. Ft.

**FOR OFFICE USE ONLY**

Signage Allowed on Parcel for ROW:

Building	<u>file</u>	Sq. Ft.
Free-Standing	_____	Sq. Ft.
Total Allowed:	_____	Sq. Ft.

COMMENTS: See Master Plan

**NOTE:** No sign may exceed 300 square feet. A separate sign clearance is required for each sign. Attach a sketch, to scale, of proposed and existing signage including types, dimensions and lettering. Attach a plot plan, to scale, showing: abutting streets, alleys, easements, driveways, encroachments, property lines, distances from existing buildings to proposed signs and required setbacks. A SEPARATE PERMIT FROM THE BUILDING DEPARTMENT IS ALSO REQUIRED.

I hereby attest that the information on this form and the attached sketches are true and accurate.

<u>Jodel Kochera</u>	<u>4/18/05</u>	<u>Fish E Cox</u>	<u>4/26/2005</u>
Applicant's Signature	Date	Community Development Approval	Date

(White: Community Development)      (Canary: Applicant)      (Pink: Building Dept)      (Goldenrod: Code Enforcement)



# SIGN CLEARANCE

Community Development Department  
250 North 5<sup>th</sup> Street  
Grand Junction CO 81501  
(970) 244-1430

ⓐ

D-7

Clearance No.	_____
Date Submitted	4/18/05
Fee \$	25.00
Zone	PD

TAX SCHEDULE	2945-111-02-971	CONTRACTOR	Bud's Signs
BUSINESS NAME	St. Mary's	LICENSE NO.	2050128
STREET ADDRESS	425 Patterson	ADDRESS	1055 Ute Ave.
PROPERTY OWNER	SAME	TELEPHONE NO.	245-7700
OWNER ADDRESS	_____	CONTACT PERSON	TODD

- |                                     |                  |   |
|-------------------------------------|------------------|---|
| <input type="checkbox"/>            | 1. FLUSH WALL    | 2 Square Feet per Linear Foot of Building Facade  |
| <input type="checkbox"/>            | 2. ROOF          | 2 Square Feet per Linear Foot of Building Facade  |
| <input checked="" type="checkbox"/> | 3. FREE-STANDING | 2 Traffic Lanes - 0.75 Square Feet x Street Frontage<br>4 or more Traffic Lanes - 1.5 Square Feet x Street Frontage |
| <input type="checkbox"/>            | 4. PROJECTING    | 0.5 Square Feet per each Linear Foot of Building Facade   |
| <input type="checkbox"/>            | 5. OFF-PREMISE   | See #3 Spacing Requirements; Not > 300 Square Feet or < 15 Square Feet  |

Externally Illuminated       Internally Illuminated       Non-Illuminated

(1 - 5) Area of Proposed Sign: 19.00 Square Feet

(1,2,4) Building Façade: \_\_\_\_\_ Linear Feet      Building Façade Direction:    North    South    East    West

(1 - 4) Street Frontage: \_\_\_\_\_ Linear Feet      Name of Street: \_\_\_\_\_

(2 - 5) Height to Top of Sign: \_\_\_\_\_ Feet      Clearance to Grade: \_\_\_\_\_ Feet

(5) Distance from all Existing Off-Premise Signs within 600 Feet: \_\_\_\_\_ Feet

**EXISTING SIGNAGE/TYPE & SQUARE FOOTAGE:**

_____	_____	Sq. Ft.
_____	_____	Sq. Ft.
_____	_____	Sq. Ft.
_____	_____	Sq. Ft.
Total Existing:		_____ Sq. Ft.

**FOR OFFICE USE ONLY**

Signage Allowed on Parcel for ROW:

Building See file Sq. Ft.

Free-Standing \_\_\_\_\_ Sq. Ft.

Total Allowed: \_\_\_\_\_ Sq. Ft.

COMMENTS: See Master Plan

**NOTE:** No sign may exceed 300 square feet. A separate sign clearance is required for each sign. Attach a sketch, to scale, of proposed and existing signage including types, dimensions and lettering. Attach a plot plan, to scale, showing: abutting streets, alleys, easements, driveways, encroachments, property lines, distances from existing buildings to proposed signs and required setbacks. **A SEPARATE PERMIT FROM THE BUILDING DEPARTMENT IS ALSO REQUIRED.**

I hereby attest that the information on this form and the attached sketches are true and accurate.

Todd Kochava      4/18/05      Jana C. Cox      4/26/2005

Applicant's Signature      Date      Community Development Approval      Date

(White: Community Development)      (Canary: Applicant)      (Pink: Building Dept)      (Goldenrod: Code Enforcement)



# SIGN CLEARANCE

Community Development Department  
250 North 5<sup>th</sup> Street  
Grand Junction CO 81501  
(970) 244-1430

D-9

Clearance No. \_\_\_\_\_  
Date Submitted 4/18/05  
Fee \$ 500  
Zone PD

TAX SCHEDULE 2945-111-02-971  
BUSINESS NAME St. Mary's  
STREET ADDRESS 425 Patterson  
PROPERTY OWNER SAME  
OWNER ADDRESS \_\_\_\_\_

CONTRACTOR Bud's Signs  
LICENSE NO. 2050128  
ADDRESS 1055 Ute Ave.  
TELEPHONE NO. 245-7700  
CONTACT PERSON TODD

- 1. FLUSH WALL 2 Square Feet per Linear Foot of Building Facade
- 2. ROOF 2 Square Feet per Linear Foot of Building Facade
- 3. FREE-STANDING 2 Traffic Lanes - 0.75 Square Feet x Street Frontage  
4 or more Traffic Lanes - 1.5 Square Feet x Street Frontage
- 4. PROJECTING 0.5 Square Feet per each Linear Foot of Building Facade
- 5. OFF-PREMISE See #3 Spacing Requirements; Not > 300 Square Feet or < 15 Square Feet

Externally Illuminated       Internally Illuminated       Non-Illuminated

(1 - 5) Area of Proposed Sign: 19.00 Square Feet  
(1,2,4) Building Façade: \_\_\_\_\_ Linear Feet      Building Façade Direction:    North    South    East    West  
(1 - 4) Street Frontage: \_\_\_\_\_ Linear Feet      Name of Street: \_\_\_\_\_  
(2 - 5) Height to Top of Sign: \_\_\_\_\_ Feet      Clearance to Grade: \_\_\_\_\_ Feet  
(5) Distance from all Existing Off-Premise Signs within 600 Feet: \_\_\_\_\_ Feet

### EXISTING SIGNAGE/TYPE & SQUARE FOOTAGE:

_____	_____	Sq. Ft.
_____	_____	Sq. Ft.
_____	_____	Sq. Ft.
Total Existing:		_____ Sq. Ft.

### FOR OFFICE USE ONLY

Signage Allowed on Parcel for ROW:

Building	<u>file</u>	_____	Sq. Ft.
Free-Standing	<u>file</u>	_____	Sq. Ft.
Total Allowed:		_____	Sq. Ft.

COMMENTS: SEE Master Plan

**NOTE:** No sign may exceed 300 square feet. A separate sign clearance is required for each sign. Attach a sketch, to scale, of proposed and existing signage including types, dimensions and lettering. Attach a plot plan, to scale, showing: abutting streets, alleys, easements, driveways, encroachments, property lines, distances from existing buildings to proposed signs and required setbacks. A SEPARATE PERMIT FROM THE BUILDING DEPARTMENT IS ALSO REQUIRED.

I hereby attest that the information on this form and the attached sketches are true and accurate.

<u>Jack Kochera</u>	<u>4/18/05</u>	<u>Lisa C. Cox</u>	<u>4/26/2005</u>
Applicant's Signature	Date	Community Development Approval	Date

(White: Community Development)      (Canary: Applicant)      (Pink: Building Dept)      (Goldenrod: Code Enforcement)



# SIGN CLEARANCE

Community Development Department  
250 North 5<sup>th</sup> Street  
Grand Junction CO 81501  
(970) 244-1430

0-14

Clearance No.	_____
Date Submitted	4/18/05
Fee \$	5.00
Zone	PD

TAX SCHEDULE	2945-111-02-971	CONTRACTOR	Bud's Signs
BUSINESS NAME	St. Mary's	LICENSE NO.	2050128
STREET ADDRESS	425 Patterson	ADDRESS	1055 Ute Ave.
PROPERTY OWNER	SAME	TELEPHONE NO.	245-7700
OWNER ADDRESS	_____	CONTACT PERSON	TODD

- |                                     |                  |   |
|-------------------------------------|------------------|---|
| <input type="checkbox"/>            | 1. FLUSH WALL    | 2 Square Feet per Linear Foot of Building Facade  |
| <input type="checkbox"/>            | 2. ROOF          | 2 Square Feet per Linear Foot of Building Facade  |
| <input checked="" type="checkbox"/> | 3. FREE-STANDING | 2 Traffic Lanes - 0.75 Square Feet x Street Frontage<br>4 or more Traffic Lanes - 1.5 Square Feet x Street Frontage |
| <input type="checkbox"/>            | 4. PROJECTING    | 0.5 Square Feet per each Linear Foot of Building Facade   |
| <input type="checkbox"/>            | 5. OFF-PREMISE   | See #3 Spacing Requirements; Not > 300 Square Feet or < 15 Square Feet  |

Externally Illuminated       Internally Illuminated       Non-Illuminated

(1 - 5) Area of Proposed Sign: 19.00 Square Feet

(1,2,4) Building Façade: \_\_\_\_\_ Linear Feet      Building Façade Direction:    North    South    East    West

(1 - 4) Street Frontage: \_\_\_\_\_ Linear Feet      Name of Street: \_\_\_\_\_

(2 - 5) Height to Top of Sign: \_\_\_\_\_ Feet      Clearance to Grade: \_\_\_\_\_ Feet

(5) Distance from all Existing Off-Premise Signs within 600 Feet: \_\_\_\_\_ Feet

EXISTING SIGNAGE/TYPE & SQUARE FOOTAGE:	
_____	_____ Sq. Ft.
_____	_____ Sq. Ft.
_____	_____ Sq. Ft.
Total Existing:	_____ Sq. Ft.

FOR OFFICE USE ONLY	
Signage Allowed on Parcel for ROW:	
Building	_____ Sq. Ft.
Free-Standing	_____ Sq. Ft.
Total Allowed:	_____ Sq. Ft.

COMMENTS: See Master

**NOTE:** No sign may exceed 300 square feet. A separate sign clearance is required for each sign. Attach a sketch, to scale, of proposed and existing signage including types, dimensions and lettering. Attach a plot plan, to scale, showing: abutting streets, alleys, easements, driveways, encroachments, property lines, distances from existing buildings to proposed signs and required setbacks. **A SEPARATE PERMIT FROM THE BUILDING DEPARTMENT IS ALSO REQUIRED.**

I hereby attest that the information on this form and the attached sketches are true and accurate.

Todd Korchewer      4/18/05      Juan E. Cox      4/26/2005

Applicant's Signature      Date      Community Development Approval      Date

(White: Community Development)      (Canary: Applicant)      (Pink: Building Dept)      (Goldenrod: Code Enforcement)



# SIGN CLEARANCE

Community Development Department  
250 North 5<sup>th</sup> Street  
Grand Junction CO 81501  
(970) 244-1430

D-15

Clearance No.	_____
Date Submitted	4/18/05
Fee \$	25.00
Zone	PD

TAX SCHEDULE	2945-111-02-971	CONTRACTOR	Bud's Signs
BUSINESS NAME	St. Mary's	LICENSE NO.	2050128
STREET ADDRESS	425 Patterson	ADDRESS	1055 Ute Ave.
PROPERTY OWNER	SAME	TELEPHONE NO.	248-7700
OWNER ADDRESS	_____	CONTACT PERSON	TODD

- 1. FLUSH WALL                      2 Square Feet per Linear Foot of Building Facade
- 2. ROOF                                2 Square Feet per Linear Foot of Building Facade
- 3. FREE-STANDING                2 Traffic Lanes - 0.75 Square Feet x Street Frontage  
4 or more Traffic Lanes - 1.5 Square Feet x Street Frontage
- 4. PROJECTING                      0.5 Square Feet per each Linear Foot of Building Facade
- 5. OFF-PREMISE                    See #3 Spacing Requirements; Not > 300 Square Feet or < 15 Square Feet

Externally Illuminated                       Internally Illuminated                       Non-Illuminated

(1 - 5) Area of Proposed Sign: 17.00 Square Feet

(1,2,4) Building Façade: \_\_\_\_\_ Linear Feet

(1 - 4) Street Frontage: \_\_\_\_\_ Linear Feet

(2 - 5) Height to Top of Sign: \_\_\_\_\_ Feet                      Clearance to Grade: \_\_\_\_\_ Feet

(5) Distance from all Existing Off-Premise Signs within 600 Feet: \_\_\_\_\_ Feet

**EXISTING SIGNAGE/TYPE:**

_____	_____ Sq. Ft.
_____	_____ Sq. Ft.
_____	_____ Sq. Ft.
Total Existing:	_____ Sq. Ft.

● FOR OFFICE USE ONLY ●

Signage Allowed on Parcel:

Building	<u>file</u>	_____ Sq. Ft.
Free-Standing	_____	_____ Sq. Ft.
Total Allowed:	_____	_____ Sq. Ft.

COMMENTS: See Master Plan

**NOTE:** No sign may exceed 300 square feet. A separate sign clearance is required for each sign. Attach a sketch, to scale, of proposed and existing signage including types, dimensions and lettering. Attach a plot plan, to scale, showing: abutting streets, alleys, easements, driveways, encroachments, property lines, distances from existing buildings to proposed signs and required setbacks. **A SEPARATE PERMIT FROM THE BUILDING DEPARTMENT IS ALSO REQUIRED.**

I hereby attest that the information on this form and the attached sketches are true and accurate.

Jodd Kodera                      4/18/05                      Lisa C. Cox                      4/26/2005

Applicant's Signature                      Date                      Community Development Approval                      Date

(White: Community Development)                      (Canary: Applicant)                      (Pink: Building Dept)                      (Goldenrod: Code Enforcement)



# SIGN CLEARANCE

Community Development Department  
250 North 5<sup>th</sup> Street  
Grand Junction CO 81501  
(970) 244-1430

0-19

Clearance No. \_\_\_\_\_  
Date Submitted 4/18/05  
Fee \$ 5.00  
Zone PD

TAX SCHEDULE 2945-111-02-971  
BUSINESS NAME St. Mary's  
STREET ADDRESS 425 Patterson  
PROPERTY OWNER SAME  
OWNER ADDRESS SAME

CONTRACTOR Bud's Signs  
LICENSE NO. 2050128  
ADDRESS 1055 Ute Ave.  
TELEPHONE NO. 245-7700  
CONTACT PERSON TODD

- 1. FLUSH WALL 2 Square Feet per Linear Foot of Building Facade
- 2. ROOF 2 Square Feet per Linear Foot of Building Facade
- 3. FREE-STANDING 2 Traffic Lanes - 0.75 Square Feet x Street Frontage  
4 or more Traffic Lanes - 1.5 Square Feet x Street Frontage
- 4. PROJECTING 0.5 Square Feet per each Linear Foot of Building Facade
- 5. OFF-PREMISE See #3 Spacing Requirements; Not > 300 Square Feet or < 15 Square Feet

Externally Illuminated       Internally Illuminated       Non-Illuminated

(1 - 5) Area of Proposed Sign: 19.00 Square Feet  
(1,2,4) Building Façade: \_\_\_\_\_ Linear Feet  
(1 - 4) Street Frontage: \_\_\_\_\_ Linear Feet  
(2 - 5) Height to Top of Sign: \_\_\_\_\_ Feet      Clearance to Grade: \_\_\_\_\_ Feet  
(5) Distance from all Existing Off-Premise Signs within 600 Feet: \_\_\_\_\_ Feet

### EXISTING SIGNAGE/TYPE:

_____	_____	Sq. Ft.
_____	_____	Sq. Ft.
_____	_____	Sq. Ft.
Total Existing:		_____ Sq. Ft.

### ● FOR OFFICE USE ONLY ●

Signage Allowed on Parcel:

See file Building \_\_\_\_\_ Sq. Ft.

Free-Standing \_\_\_\_\_ Sq. Ft.

Total Allowed: \_\_\_\_\_ Sq. Ft.

COMMENTS: See Master Plan

**NOTE:** No sign may exceed 300 square feet. A separate sign clearance is required for each sign. Attach a sketch, to scale, of proposed and existing signage including types, dimensions and lettering. Attach a plot plan, to scale, showing: abutting streets, alleys, easements, driveways, encroachments, property lines, distances from existing buildings to proposed signs and required setbacks. **A SEPARATE PERMIT FROM THE BUILDING DEPARTMENT IS ALSO REQUIRED.**

I hereby attest that the information on this form and the attached sketches are true and accurate.

Todd Koderer      4/18/05      Jan E Cox      4/26/2005  
Applicant's Signature      Date      Community Development Approval      Date

(White: Community Development)      (Canary: Applicant)      (Pink: Building Dept)      (Goldenrod: Code Enforcement)



# SIGN CLEARANCE

Community Development Department  
250 North 5<sup>th</sup> Street  
Grand Junction CO 81501  
(970) 244-1430

E-1

Clearance No.	_____
Date Submitted	<u>4/18/05</u>
Fee \$	<u>5.00</u>
Zone	<u>PD</u>

TAX SCHEDULE <u>2945-111-02-971</u>	CONTRACTOR <u>Bud's Signs</u>
BUSINESS NAME <u>St. Marys</u>	LICENSE NO. <u>2050128</u>
STREET ADDRESS <u>425 Postasson</u>	ADDRESS <u>1055 Ute Ave.</u>
PROPERTY OWNER <u>SAME</u>	TELEPHONE NO. <u>245-7700</u>
OWNER ADDRESS _____	CONTACT PERSON <u>TODD</u>

- |  |   |
|--|---|
| <input type="checkbox"/> 1. FLUSH WALL               | 2 Square Feet per Linear Foot of Building Facade  |
| <input type="checkbox"/> 2. ROOF                     | 2 Square Feet per Linear Foot of Building Facade  |
| <input checked="" type="checkbox"/> 3. FREE-STANDING | 2 Traffic Lanes - 0.75 Square Feet x Street Frontage<br>4 or more Traffic Lanes - 1.5 Square Feet x Street Frontage |
| <input type="checkbox"/> 4. PROJECTING               | 0.5 Square Feet per each Linear Foot of Building Facade   |
| <input type="checkbox"/> 5. OFF-PREMISE              | See #3 Spacing Requirements; Not > 300 Square Feet or < 15 Square Feet  |

Externally Illuminated       Internally Illuminated       Non-Illuminated

(1 - 5) Area of Proposed Sign: 94.30 Square Feet

(1,2,4) Building Façade: \_\_\_\_\_ Linear Feet      Building Façade Direction:    North    South    East    West

(1 - 4) Street Frontage: \_\_\_\_\_ Linear Feet      Name of Street: \_\_\_\_\_

(2 - 5) Height to Top of Sign: \_\_\_\_\_ Feet      Clearance to Grade: \_\_\_\_\_ Feet

(5) Distance from all Existing Off-Premise Signs within 600 Feet: \_\_\_\_\_ Feet

**EXISTING SIGNAGE/TYPE & SQUARE FOOTAGE:**

_____	_____	Sq. Ft.
_____	_____	Sq. Ft.
_____	_____	Sq. Ft.
_____	_____	Sq. Ft.
Total Existing:		_____ Sq. Ft.

**FOR OFFICE USE ONLY**

Signage Allowed on Parcel for ROW:

see Building \_\_\_\_\_ Sq. Ft.

Free-Standing \_\_\_\_\_ Sq. Ft.

Total Allowed: \_\_\_\_\_ Sq. Ft.

COMMENTS: See Master Plan

**NOTE:** No sign may exceed 300 square feet. A separate sign clearance is required for each sign. Attach a sketch, to scale, of proposed and existing signage including types, dimensions and lettering. Attach a plot plan, to scale, showing: abutting streets, alleys, easements, driveways, encroachments, property lines, distances from existing buildings to proposed signs and required setbacks. **A SEPARATE PERMIT FROM THE BUILDING DEPARTMENT IS ALSO REQUIRED.**



I hereby attest that the information on this form and the attached sketches are true and accurate.

Todd Hoehner      4/18/05      Fish E. Cox      4/26/2005


Applicant's Signature      Date      Community Development Approval      Date

(White: Community Development)      (Canary: Applicant)      (Pink: Building Dept)      (Goldenrod: Code Enforcement)




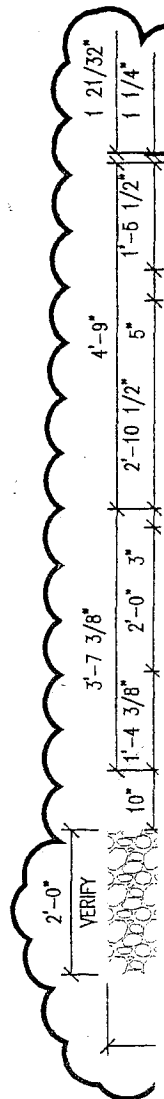 


1 SIGN TYPE D ELEVATION  
 13r 3/8" = 1'-0"

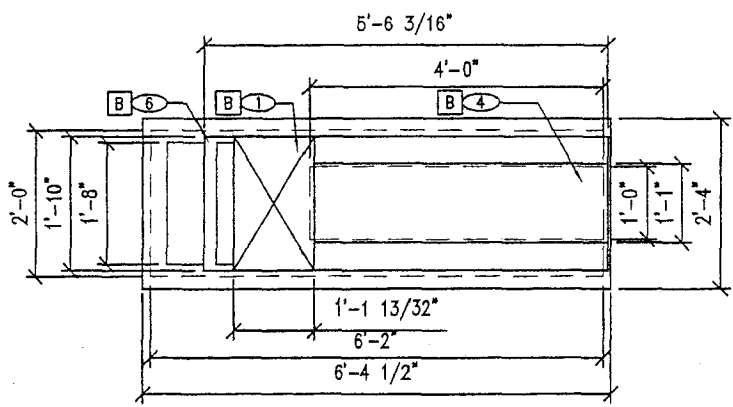


4 SIGN TYPE D PLAN  
 13r 3/8" = 1'-0"

 


1 SIGN TYPE B ELEVATION  
 10r  $3/8" = 1'-0"$

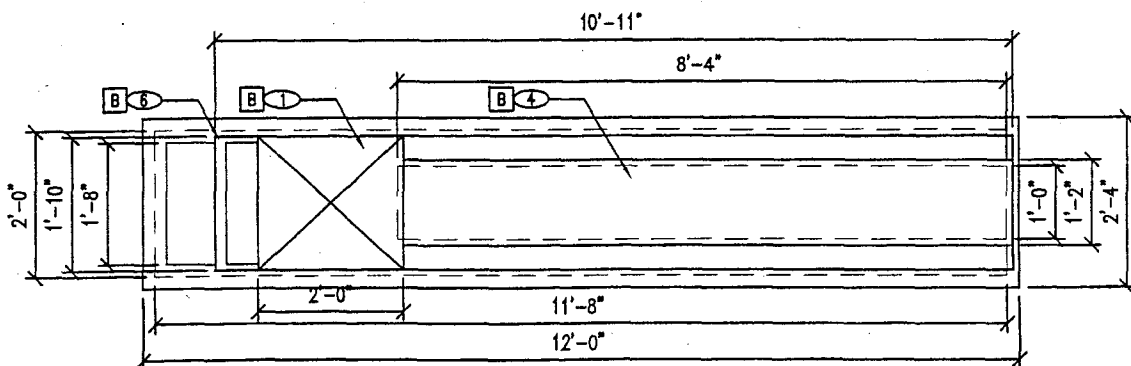

4 SIGN TYPE B PLAN  
 10r  $3/8" = 1'-0"$

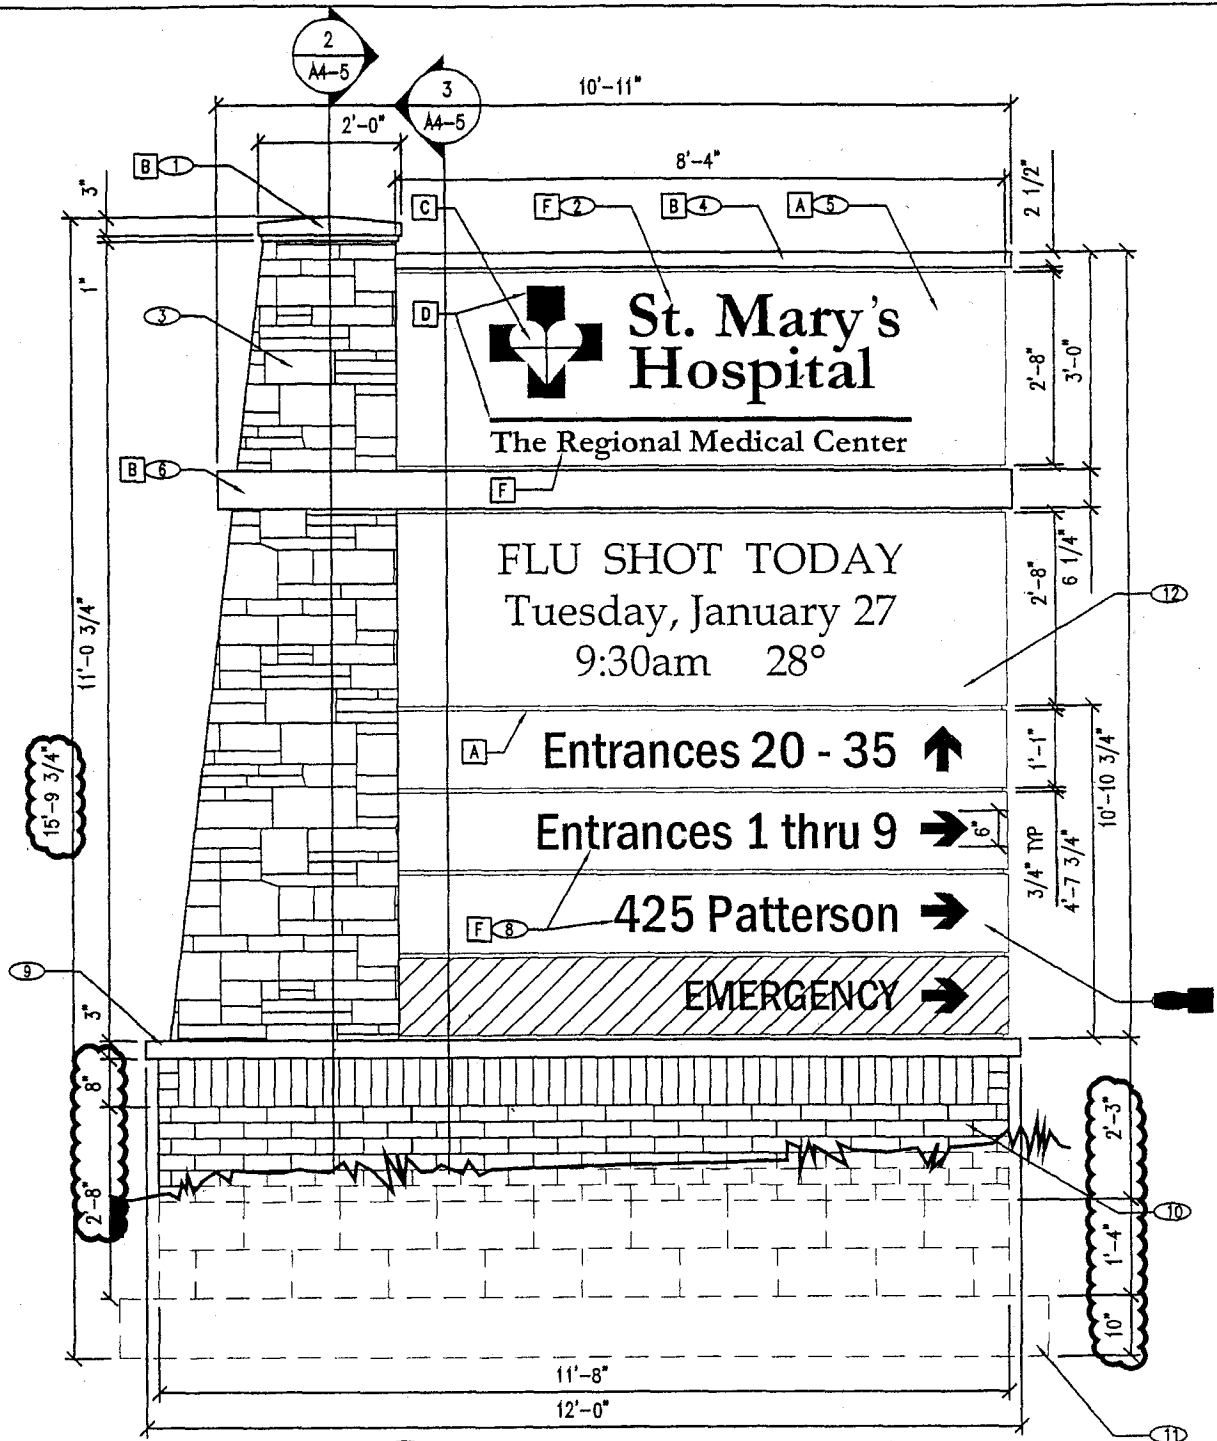

1 SIGN TYPE E ELEVATION  
 14r 3/8" = 1'-0"  
 10'-11"

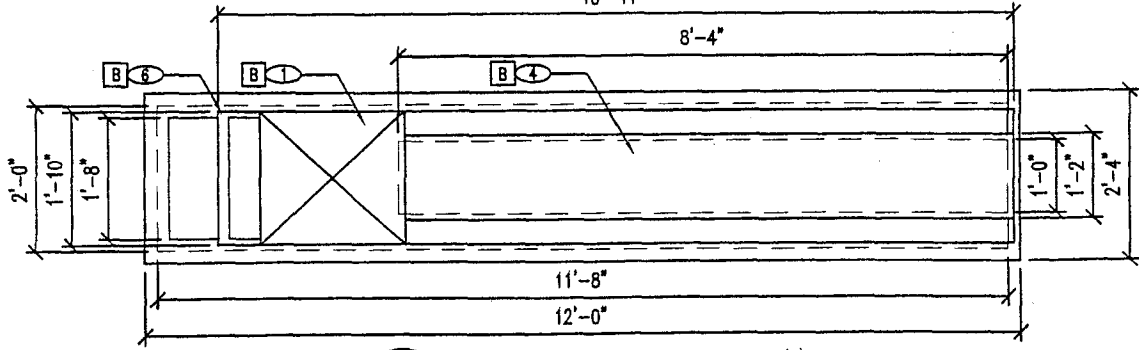

4 SIGN TYPE E PLAN  
 14r 3/8" = 1'-0"









3




SWAP LOCATIONS OF SIGNS E1 & B2

4

REVERSE LOCATIONS OF STONE COLUMNS, TYP.

F ROAD / PATTERSON RD

-  a. main campus sign
-  b. large directional sign
-  c. medium directional sign
-  d. small directional sign
-  e. specialty sign
-  f. parking banner
-  g. building canopy sign
-  h. building logo sign

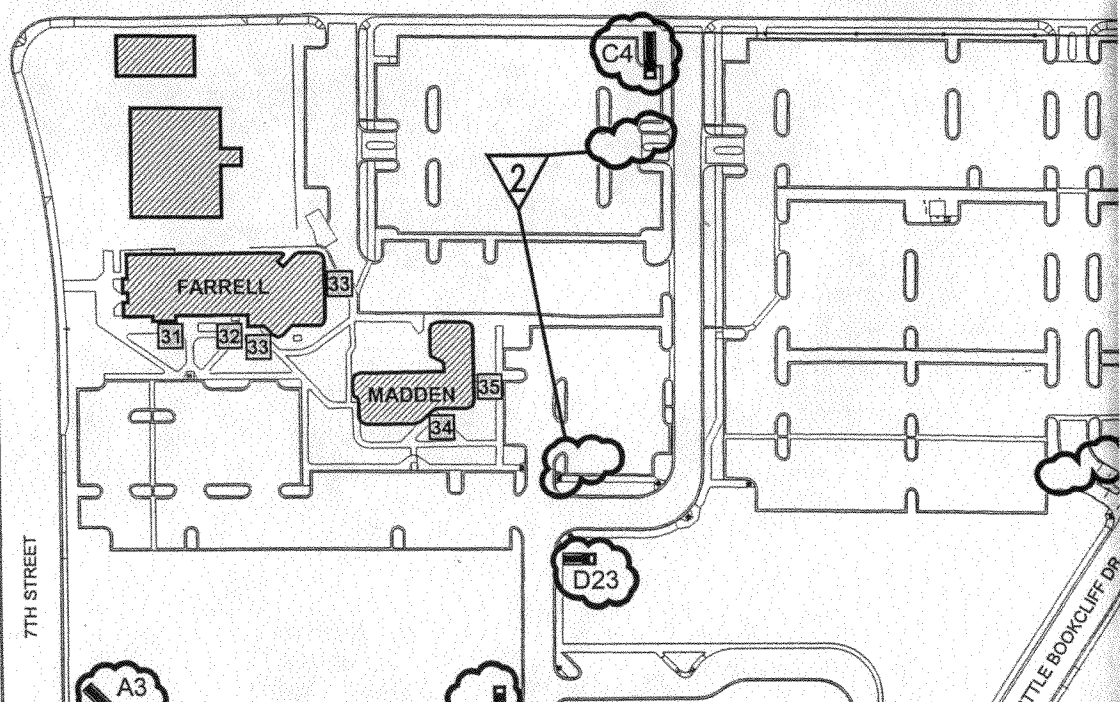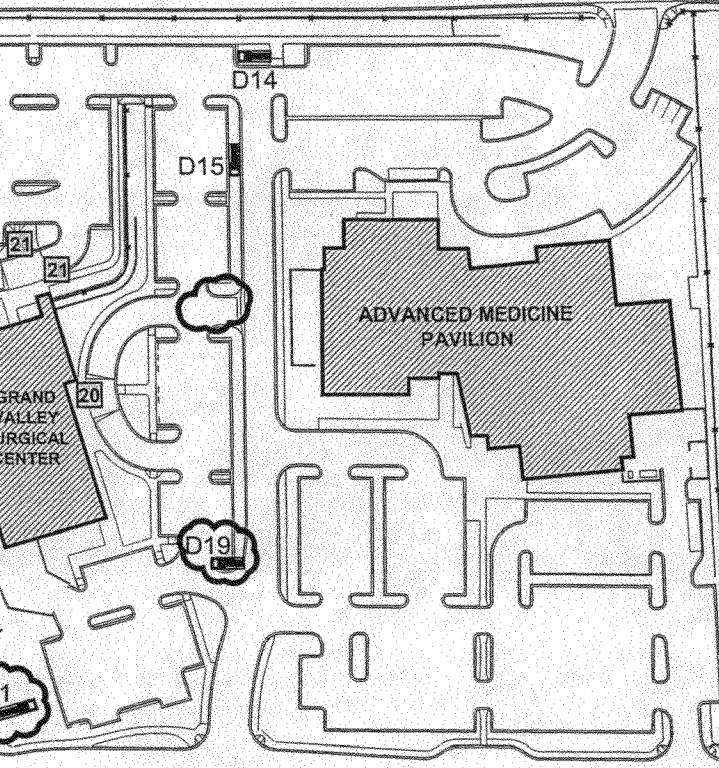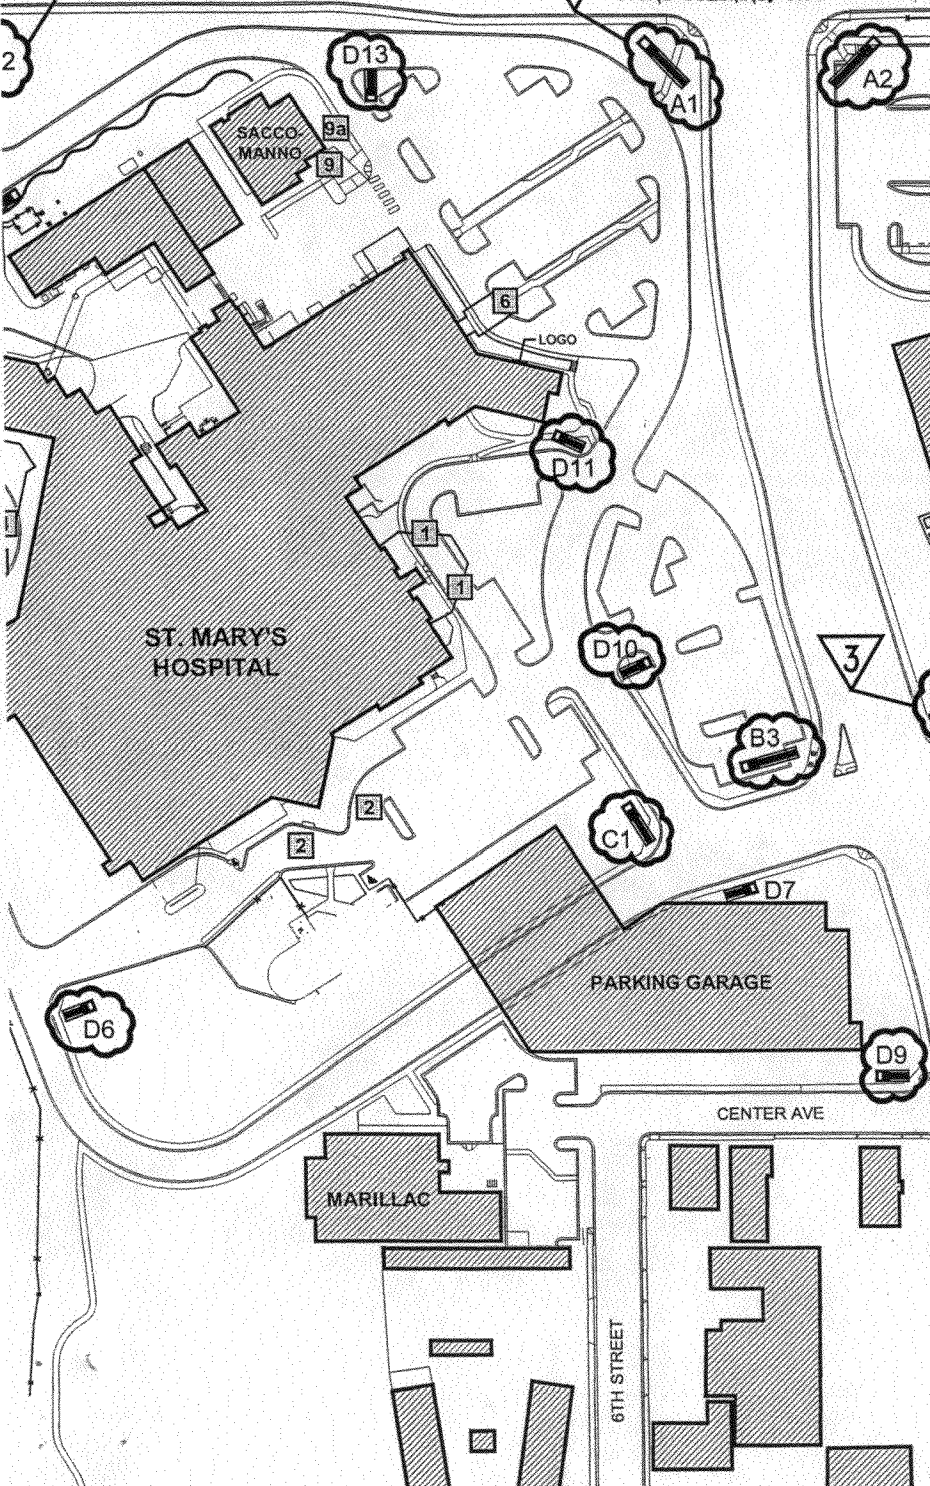

LITTLE BOOKCLIFF DR