



# SIGN CLEARANCE

Community Development Department  
250 North 5<sup>th</sup> Street  
Grand Junction CO 81501  
(970) 244-1430

Clearance No.	_____
Date Submitted	<u>1-19-05</u>
Fee	<u>\$25.00</u>
Zone	<u>C-2</u>

TAX SCHEDULE	<u>2945-102-14-050</u>	CONTRACTOR	<u>Bud's Signs</u>
BUSINESS NAME	<u>Canyon Electronics &amp; Cable</u>	LICENSE NO.	<u>2040162</u>
STREET ADDRESS	<u>592 N. Commercial</u>	ADDRESS	<u>1055 ute</u>
PROPERTY OWNER	_____	TELEPHONE NO.	<u>245-7700</u>
OWNER ADDRESS	_____	CONTACT PERSON	<u>Eric</u>

- |                                     |                  |   |
|-------------------------------------|------------------|---|
| <input type="checkbox"/>            | 1. FLUSH WALL    | 2 Square Feet per Linear Foot of Building Facade                                                                    |
| <input type="checkbox"/>            | 2. ROOF          | 2 Square Feet per Linear Foot of Building Facade                                                                    |
| <input checked="" type="checkbox"/> | 3. FREE-STANDING | 2 Traffic Lanes - 0.75 Square Feet x Street Frontage<br>4 or more Traffic Lanes - 1.5 Square Feet x Street Frontage |
| <input type="checkbox"/>            | 4. PROJECTING    | 0.5 Square Feet per each Linear Foot of Building Facade                                                             |
| <input type="checkbox"/>            | 5. OFF-PREMISE   | See #3 Spacing Requirements; Not > 300 Square Feet or < 15 Square Feet                                              |

Externally Illuminated       Internally Illuminated       Non-Illuminated

(1 - 5) Area of Proposed Sign: 18 Square Feet  
 (1,2,4) Building Façade: 100 Linear Feet  
 (1 - 4) Street Frontage: 180 Linear Feet  
 (2 - 5) Height to Top of Sign: 6 Feet      Clearance to Grade: 3 Feet  
 (5) Distance from all Existing Off-Premise Signs within 600 Feet: \_\_\_\_\_ Feet

**EXISTING SIGNAGE/TYPE:**

_____	<u>4</u>	Sq. Ft.
_____	_____	Sq. Ft.
_____	_____	Sq. Ft.
Total Existing:	_____	Sq. Ft.

● FOR OFFICE USE ONLY ●

Signage Allowed on Parcel:

Building	<u>200</u>	Sq. Ft.
Free-Standing	<u>135</u>	Sq. Ft.
Total Allowed:	<u>200</u>	Sq. Ft.


COMMENTS: \_\_\_\_\_

**NOTE:** No sign may exceed 300 square feet. A separate sign clearance is required for each sign. Attach a sketch, to scale, of proposed and existing signage including types, dimensions and lettering. Attach a plot plan, to scale, showing: abutting streets, alleys, easements, driveways, encroachments, property lines, distances from existing buildings to proposed signs and required setbacks. A SEPARATE PERMIT FROM THE BUILDING DEPARTMENT IS ALSO REQUIRED.


I hereby attest that the information on this form and the attached sketches are true and accurate.

<u>Eric Bennett</u>	<u>1-19-05</u>	<u>Dayleen Henderson</u>	<u>1-21-05</u>
Applicant's Signature	Date	Community Development Approval	Date

(White: Community Development)      (Canary: Applicant)      (Pink: Building Dept)      (Goldenrod: Code Enforcement)

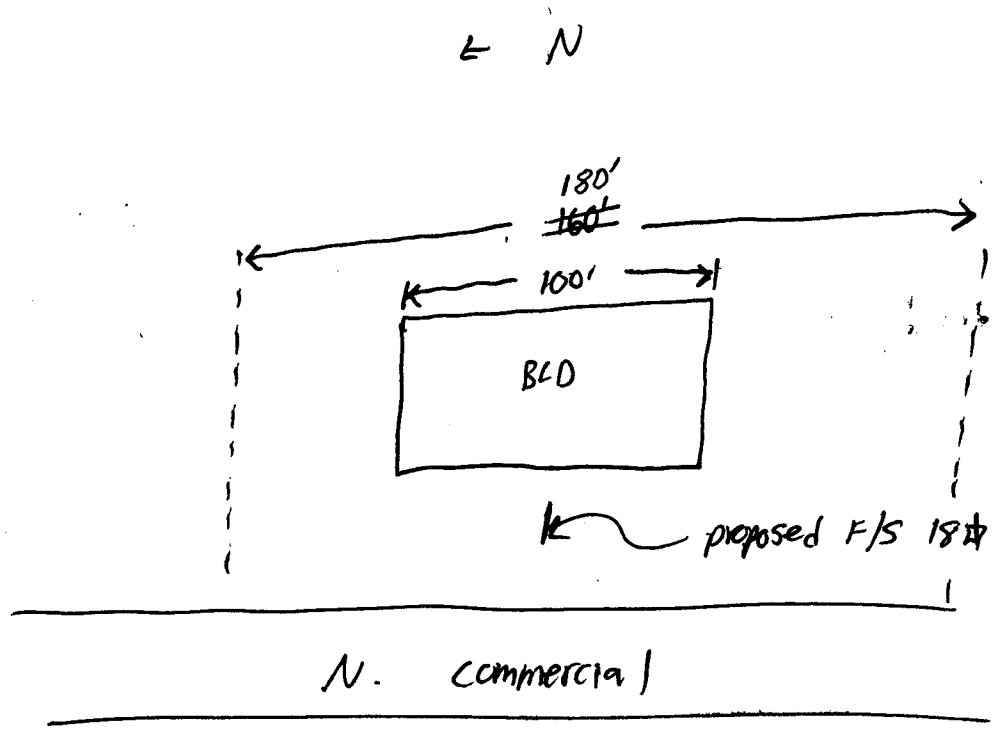

Black cabinet & base

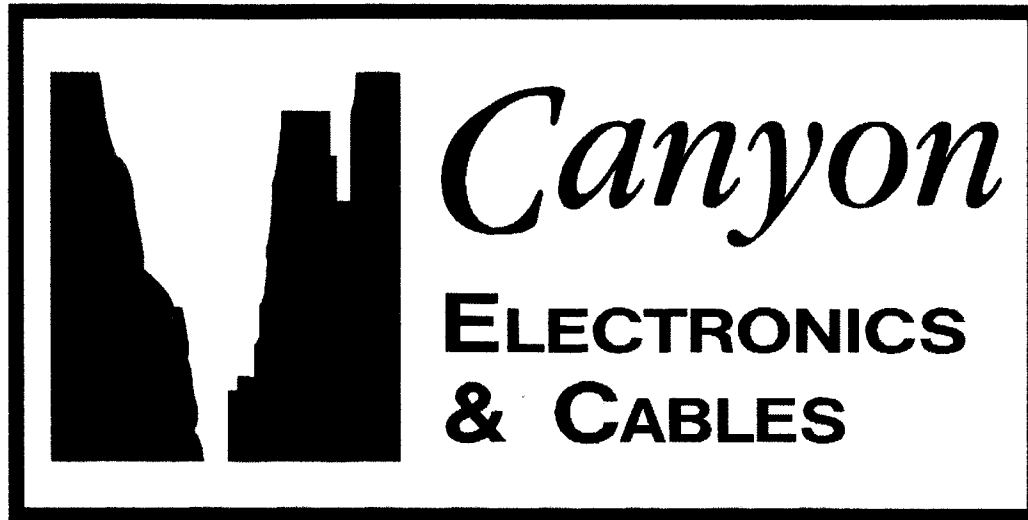

592 N. Commercial Drive

