	SIGN PERM Community Developm 250 North 5th Street Grand Junction, CO & (970) 244-1430	ent Department	Permit No. Date Submitted 7-20-05 FEE \$ 25.00 Tax Schedule 2945-091-05-010 Zone C-1	
BUSINESS NAME STREET ADDRESS PROPERTY OWNER _ OWNER ADDRESS	71NQUE 2454 HW1 6450 #	103 LICEN	CONTRACTOR THESIGN SMITH LICENSE NO. 205/054 ADDRESS 570 - E. CRETE CIR#2 TELEPHONE NO. 970-244-9191	
Face Change Only (2,3 [] 2. ROOH [] 3. FREE [] 4. PROJ	<u>& 4)</u> : 2 Square -STANDING 2 Traffic 4 or more	e Feet per each Linear F	Building Facade et x Street Frontage hare Feet x Street Frontage Foot of Building Facade	
 (1 - 4) Area of Propo (1,2,4) Building Faca (1 - 4) Street Frontag (2,3,4) Height to Top Existing Signage/Type 	osed SignSquare de Linear Feet ge Linear Feet o of Sign Feet C	7.5 Feet		
Total Existing	2:	Sq. Ft.	Total Allowed:Sq. Ft.	

COMMENTS:

ı.


NOTE: No sign may exceed 300 square feet. A separate sign permit is required for each sign. Attach a sketch of proposed and existing signage including types, dimensions, lettering, abutting streets, alleys, easements, property lines, and locations. Roof/signs shall be manufactured such that no guy wires, braces or supports shall be visible.

07/20/05 Bayleen Henderson Date Community Development Approval 7-20.05 Man Applicant's Signature Date

ERNEST W SMITH (White: Community Development)

(Canary: Applicant)

(Pink: Code Enforcement)

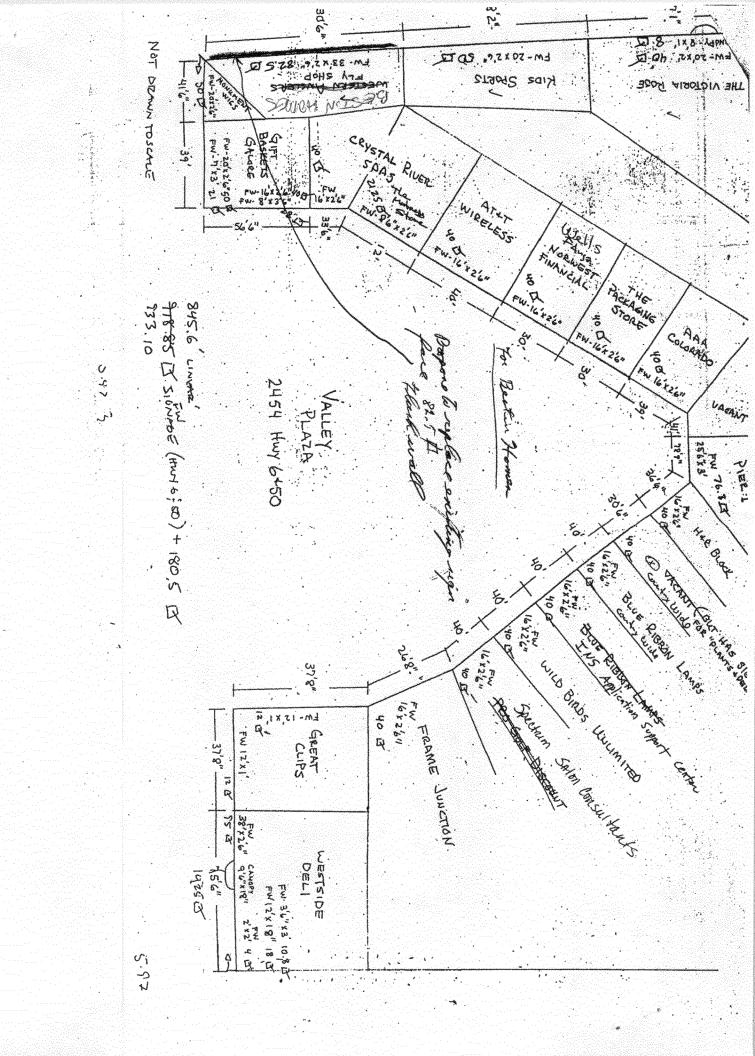



-