



SIGN PERMIT

Ⓟ

Community Development Department
250 North 5th Street
Grand Junction, CO 81501
(970) 244-1430

Permit No. _____
Date Submitted 2/9/05
FEE \$ \$2500
Tax Schedule 2945-151-00-104
Zone C-1

BUSINESS NAME Funshares
STREET ADDRESS 2583 Hwy 6 & 50
PROPERTY OWNER Bob Hunt
OWNER ADDRESS _____

CONTRACTOR Bud's Signs
LICENSE NO. 2040162
ADDRESS 1055 vte
TELEPHONE NO. 245-7700

- 1. FLUSH WALL 2 Square Feet per Linear Foot of Building Facade
- Face Change Only (2,3 & 4):*
- 2. ROOF 2 Square Feet per Linear Foot of Building Facade
- 3. FREE-STANDING 2 Traffic Lanes - 0.75 Square Feet x Street Frontage
4 or more Traffic Lanes - 1.5 Square Feet x Street Frontage
- 4. PROJECTING 0.5 Square Feet per each Linear Foot of Building Facade

Existing Externally or Internally Illuminated - No Change in Electrical Service Non-Illuminated

- (1 - 4) Area of Proposed Sign 72 Square Feet
- (1,2,4) Building Facade 50 Linear Feet North Ave
- (1 - 4) Street Frontage 100 Linear Feet North Ave
- (2,3,4) Height to Top of Sign 13 Feet Clearance to Grade 10 Feet

Existing Signage/Type:		Sq. Ft.
<u>2 @ 24# FW (Billings)</u>		
<u>1 @ 60 FW "</u>		
<u>F-S 96 "</u>		
Total Existing:		

● FOR OFFICE USE ONLY ●	
Signage Allowed on Parcel:	<u>North Ave</u>
Building	<u>100</u> Sq. Ft.
Free-Standing	<u>150</u> Sq. Ft.
Total Allowed:	<u>150</u> Sq. Ft.

COMMENTS:


NOTE: No sign may exceed 300 square feet. A separate sign permit is required for each sign. Attach a sketch of proposed and existing signage including types, dimensions, lettering, abutting streets, alleys, easements, property lines, and locations. Roof signs shall be manufactured such that no guy wires, braces or supports shall be visible.

Eric Bennett 2-9-05 B Paulson 2/10/05
 Applicant's Signature Date Community Development Approval Date


(White: Community Development)

(Canary: Applicant)

(Pink: Code Enforcement)

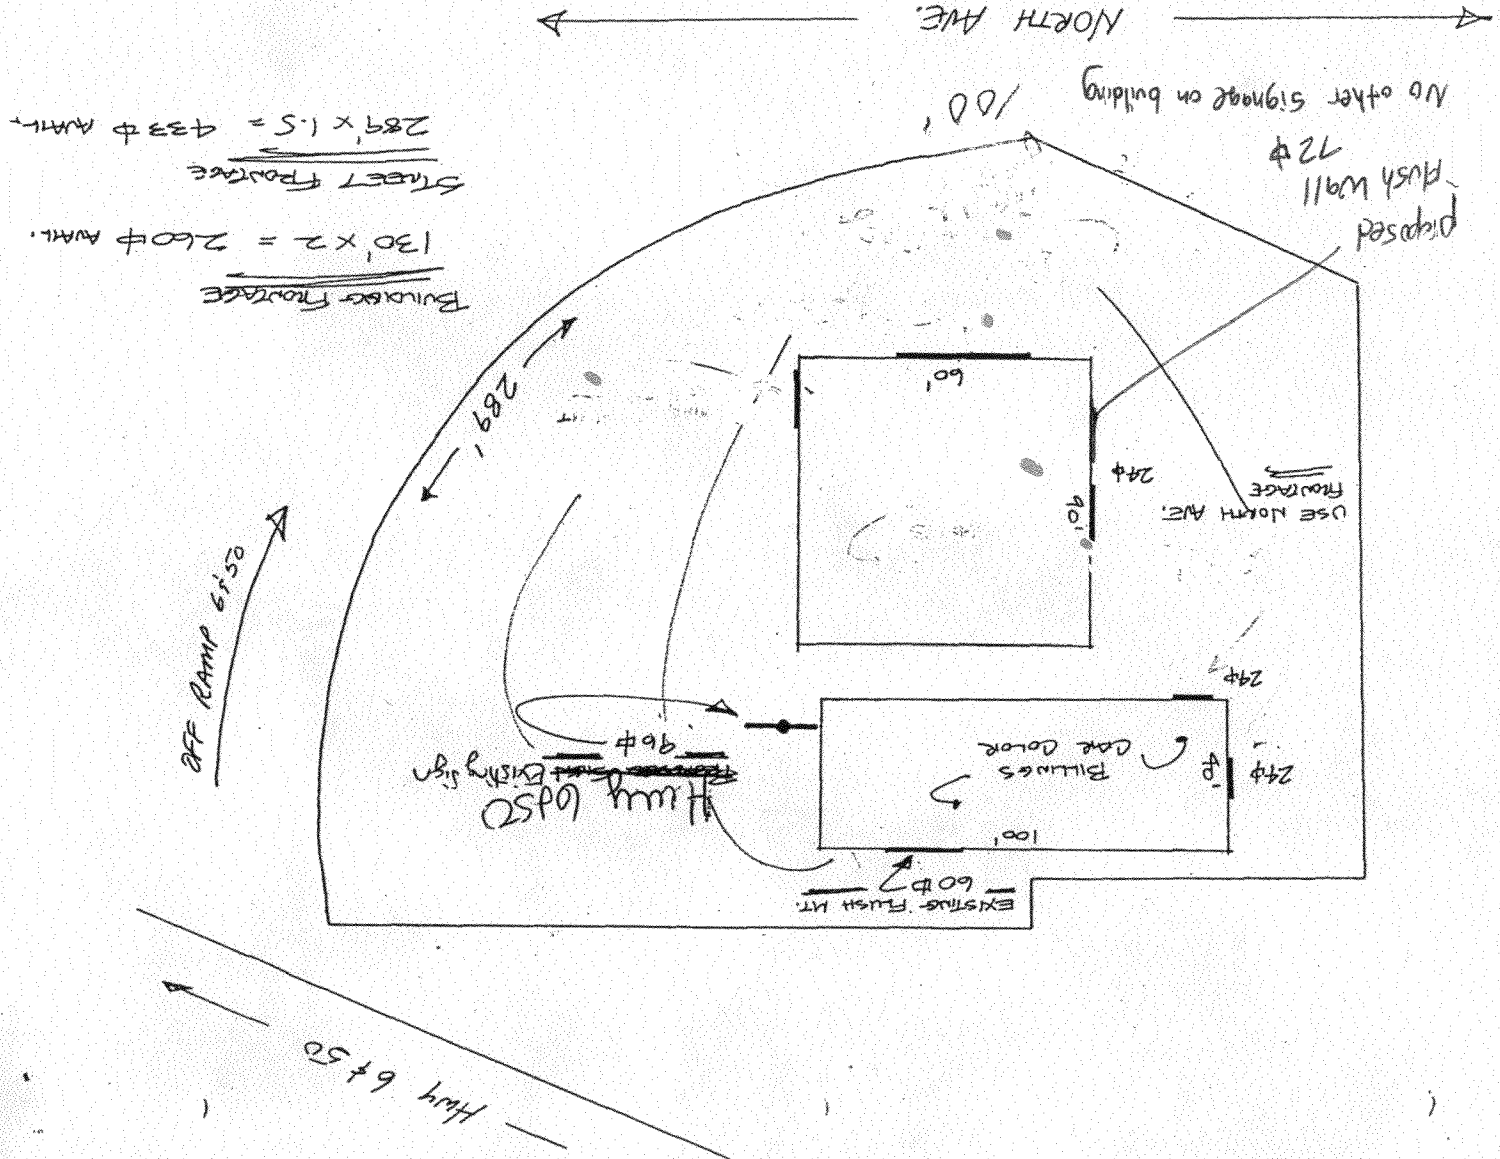

SPORT RENTALS

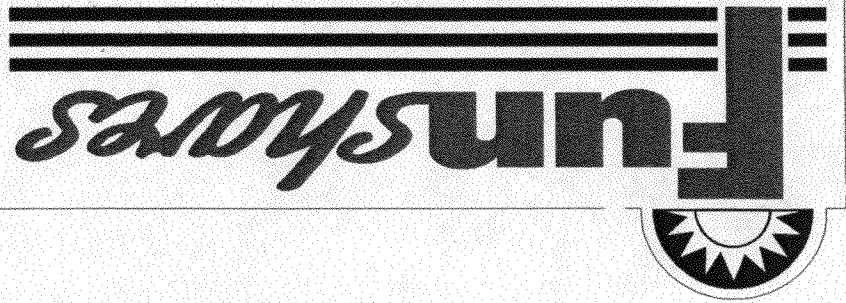

FW 72#



SCALE 1 : 724

