

Sign Permit

Community Development Department 250 North 5th Street Grand Junction CO 81501 Phone: (970) 244-1430 FAX (970) 256-4031

Permit No.
Date Submitted 11900 Fee \$ 25.
Fee \$ 25.00
Zone B-


11000. (>>0) 241 1100 11112 (>>0) 200			
TAX SCHEDULE 2945 - 143 -15 -00 4 BUSINESS NAME GRAND JCT. THERAPIES. STREET ADDRESS 3 Z1 ROOD AVE PROPERTY OWNER ROBERT S JOAN WELDS OWNER ADDRESS	LICENS ADDRE TELEPH	ACTOR PLATINUM SIGN (0. SENO. 20605-59 ESS 2916 I-70 B HONENO. 248-9677 CTPERSON BRIM TAP	
1. FLUSH WALL 2 Square Feet per Linear Foot of Building Façade Face change only on items 2, 3 & 4 2. ROOF 2 Square Feet per Linear Foot of Building Facade 0.5 Square Feet per each Linear Foot of Building Facade 2 Traffic Lanes - 0.75 Square Feet x Street Frontage 4 or more Traffic Lanes - 1.5 Square Feet x Street Frontage 4 or more Traffic Lanes - 1.5 Square Feet x Street Frontage 5 Square			
[X] Existing Externally or Internally Illuminated – No Change in Electrical Service [] Non-Illuminated			
(1-4) Area of Proposed Sign: Square Feet (1-3) Building Façade: 15 Linear Feet Building Facade Direction North South East West (4) Street Frontage: 100 Linear Feet Name of Street: 200 Feet (2-4) Height to Top of Sign: 15 Feet Clearance to Grade: 12 Feet			
EXISTING SIGNAGE/TYPE:	Ì	FOR OFFICE USE ONLY	
NONE.	Sq. Ft.	Signage Allowed on Parcel:	
	Sq. Ft.	Building 150 Sq. Ft.	
	Sq. Ft.	Free-Standing Sq. Ft.	
Total Existing:	Sq. Ft.	Total Allowed: Sq. Ft.	
COMMENTS:			
NOTE: No sign may exceed 300 square feet. A separate sign permit is required for each sign. Attach a sketch, to scale, of proposed and existing signage including types, dimensions and lettering. Attach a plot plan, to scale, showing: abutting streets, alleys, easements, driveways, encroachments, property lines, distances from existing buildings to proposed signs and required setbacks. Roof signs shall be manufactured such that no guy wires, braces or supports shall be visible. I hereby attest that the information on this form and the attached sketches are true and accurate.			
Applicant's Signature Date Community Development Approval Date			

(White: Community Development)

(Yellow: Applicant)

(Pink: Code Enforcement)

City of Grand Junction GIS City Map ©

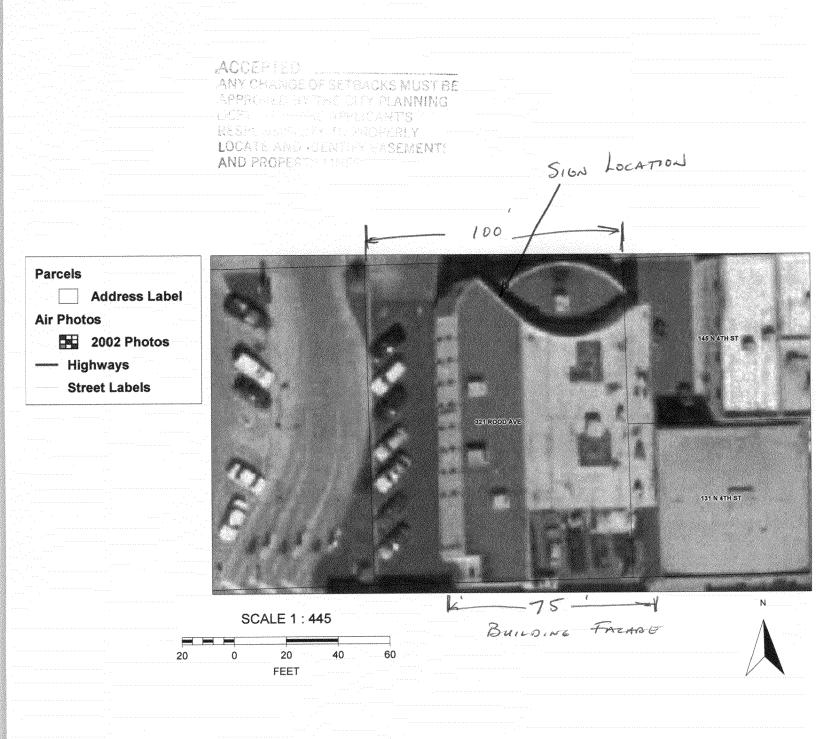



GRAND JUNCTION

THERAPIES

• Physical Therapy

Massage Therapy

· Occupational Therapy

ACCEPTED 9 19 00

ANY CHAR BY STANNING

APPROVE TO THE AND THE NITTY EASEMENTS

AND PROPERTY LINES.