
Grand Junction	Sign Permit Community Development Department 250 North 5 th Street Grand Junction CO 81501 Phone: (970) 244-1430 FAX (970) 256-4	Fee $\$ _ 25.00$ Zone \mathcal{I} -2
TAX SCHEDULE BUSINESS NAME STREET ADDRESS PROPERTY OWNER OWNER ADDRESS	701-314-01-007 Neatherford Wire 719 Arrowest Ct. SAME SAME	$\frac{\text{CONTRACTOR} Bud's Signs}{\frac{1}{2060}05}$ $\frac{1}{2060}05$ $\frac{1055}{40}$ $\frac{1055}{40}$ $\frac{1055}{295}$ $\frac{105}{295}$ $\frac{1000}{100}$
I. FLUSH WALL 2 Square Feet per Linear Foot of Building Façade Face change only on items 2, 3 & 4 2 Square Feet per Linear Foot of Building Façade [] 2. ROOF 2 Square Feet per Linear Foot of Building Facade [] 3. PROJECTING 0.5 Square Feet per each Linear Foot of Building Facade [] 4. FREE-STANDING 2 Traffic Lanes - 0.75 Square Feet x Street Frontage 4 or more Traffic Lanes - 1.5 Square Feet x Street Frontage		
[] Existing Externally or Internally Illuminated – No Change in Electrical Service		
(1-4) Area of Proposed Sign:		
EXISTING SIGNAGE/	ГУРЕ:	FOR OFFICE USE ONLY
		_ Sq. Ft. Signage Allowed on Parcel:
······		Sq. Ft Building Sq. Ft.
•••••••••••••••••••••••••••••••••••••••		_ Sq. Ft. Free-Standing <u>90</u> Sq. Ft.
	Total Existing:	_ Sq. Ft Total Allowed: Sq. Ft.
COMMENTS		

NOTE: No sign may exceed 300 square feet. A separate sign permit is required for each sign. Attach a sketch, to scale, of proposed and existing signage including types, dimensions and lettering. Attach a plot plan, to scale, showing: abutting streets, alleys, easements, driveways, encroachments, property lines, distances from existing buildings to proposed signs and required setbacks. Roof signs shall be manufactured such that no guy wires, braces or supports shall be visible.

I hereby attest that the information on this form and the attached sketches are true and accurate.

7/06 120/0Le U **Applicant's Signature** Date

Community Development Approval

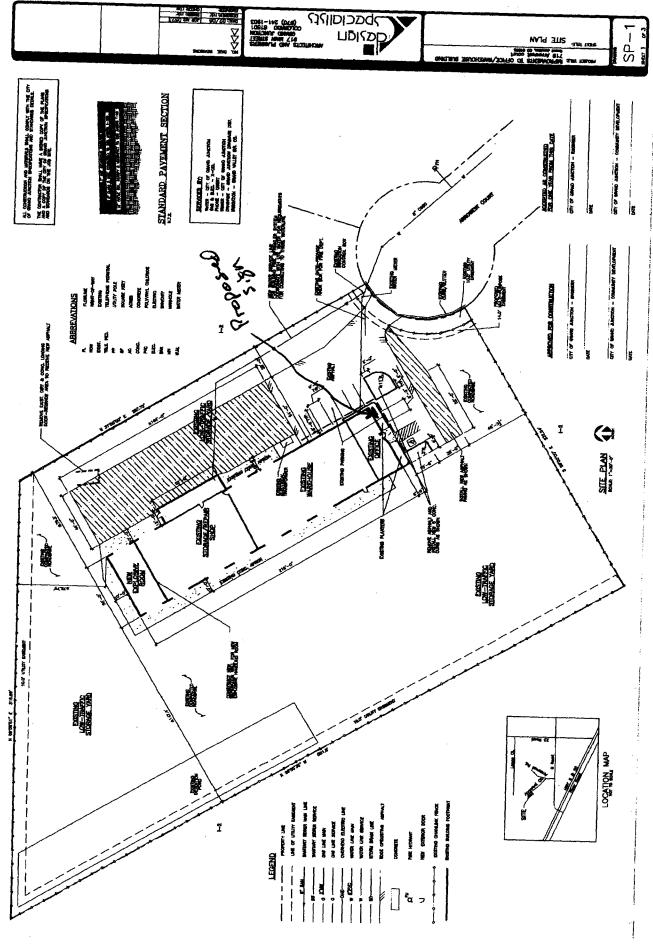

. •

.....

