


PLASTIC LETTERS



(NOT TO SCALE)

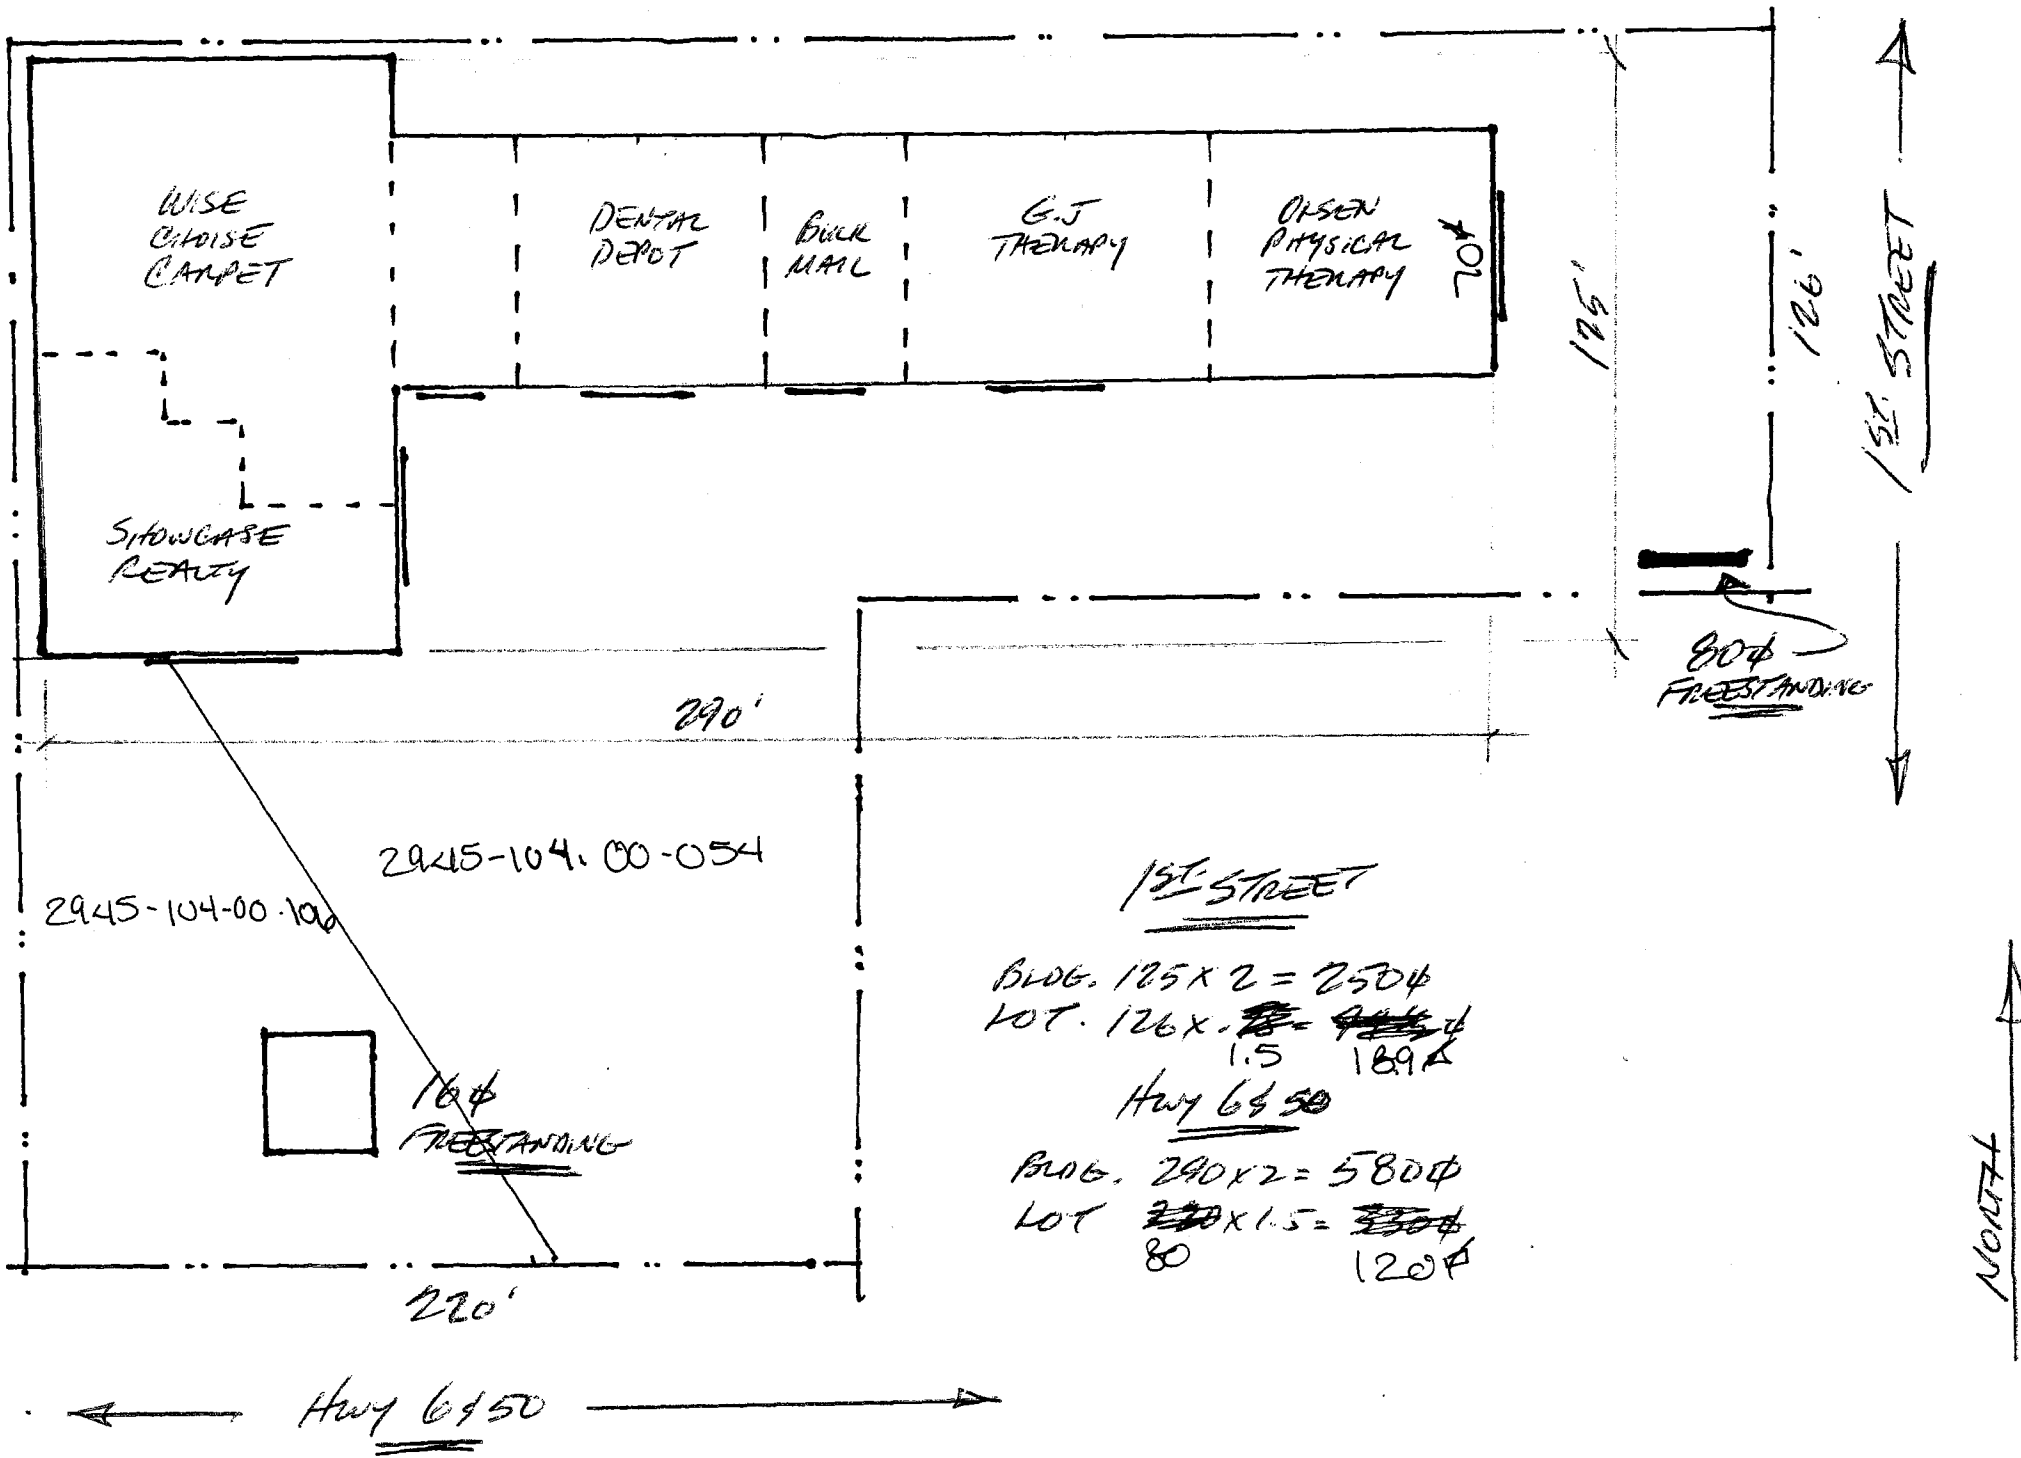