



# Sign Permit

Community Development Department  
250 North 5<sup>th</sup> Street  
Grand Junction CO 81501  
Phone: (970) 244-1430 FAX (970) 256-4031

Permit No. _____
Date Submitted <u>1-5-06</u>
Fee \$ <u>25.00</u>
Zone <u>C-1</u>

TAX SCHEDULE <u>2945-091-05-010</u>	CONTRACTOR <u>Platinum Sign Co</u>
BUSINESS NAME <u>ANENU Salon</u>	LICENSE NO. <u>2650681</u>
STREET ADDRESS <u>2454 Hwy 6+24</u>	ADDRESS <u>2916 E-70B</u>
PROPERTY OWNER <u>K+N Investors</u>	TELEPHONE NO. <u>248-9677</u>
OWNER ADDRESS _____	CONTACT PERSON <u>Mike</u>

<input checked="" type="checkbox"/> 1. FLUSH WALL	2 Square Feet per Linear Foot of Building Façade
<b>Face change only on items 2, 3 &amp; 4</b>	
<input type="checkbox"/> 2. ROOF	2 Square Feet per Linear Foot of Building Façade
<input type="checkbox"/> 3. PROJECTING	0.5 Square Feet per each Linear Foot of Building Façade
<input type="checkbox"/> 4. FREE-STANDING	2 Traffic Lanes - 0.75 Square Feet x Street Frontage 4 or more Traffic Lanes - 1.5 Square Feet x Street Frontage

Existing Externally or Internally Illuminated – No Change in Electrical Service       Non-Illuminated

(1-4) Area of Proposed Sign: <u>46.43</u> Square Feet	Building Façade Direction: North South East <u>West</u>
(1-3) Building Façade: <u>37'1"</u> Linear Feet	Name of Street: <u>24 1/2 Rd</u>
(4) Street Frontage: _____ Linear Feet	Clearance to Grade: _____ Feet
(2-4) Height to Top of Sign: _____ Feet	

**EXISTING SIGNAGE/TYPE:**

_____	_____ Sq. Ft.
_____	_____ Sq. Ft.
_____	_____ Sq. Ft.
_____	_____ Sq. Ft.
<b>Total Existing:</b>	_____ Sq. Ft.

*See Valley Plaza file*

**FOR OFFICE USE ONLY**

Signage Allowed on Parcel: <u>24 1/2 Rd</u>
Building <u>8456</u> Sq. Ft.
Free-Standing _____ Sq. Ft.
<b>Total Allowed:</b> <u>8456</u> Sq. Ft.

COMMENTS: \_\_\_\_\_

**NOTE:** No sign may exceed 300 square feet. A separate sign permit is required for each sign. Attach a sketch, to scale, of proposed and existing signage including types, dimensions and lettering. Attach a plot plan, to scale, showing: abutting streets, alleys, easements, driveways, encroachments, property lines, distances from existing buildings to proposed signs and required setbacks. Roof signs shall be manufactured such that no guy wires, braces or supports shall be visible.

I hereby attest that the information on this form and the attached sketches are true and accurate.

<u>[Signature]</u>	_____	<u>[Signature]</u>	_____
Applicant's Signature	Date	Community Development Approval	Date

(White: Community Development)      (Yellow: Applicant)      (Pink: Code Enforcement)



46.43 sq ft




██████ H ██████████ d ██████████ CO8 ██████████ ██████████  
 fabrication installation maintenance neon vinyl truck lettering awnings

THIS ARTWORK WAS PREPARED BY AND IS THE PROPERTY OF PLATINUM SIGN CO. ANY UNAUTHORIZED USE OF SAME, IN WHOLE OR PART IS PROHIBITED. ©



# ANEWU

SALON & SO MUCH MORE






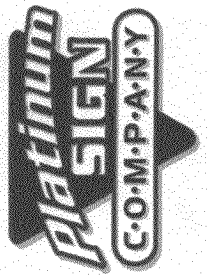


2916 HWY. 6&24 Grand Junction, CO 81504 (970)248-9677  
fabrication installation maintenance neon vinyl truck lettering awnings

THIS ARTWORK WAS PREPARED BY AND IS THE PROPERTY OF PLATINUM SIGN CO. ANY UNAUTHORIZED USE OF SAME, IN WHOLE OR PART IS PROHIBITED. ©



845.6' LIMITE  
FW SIGNAGE (HWY 6+50) + 180.5'

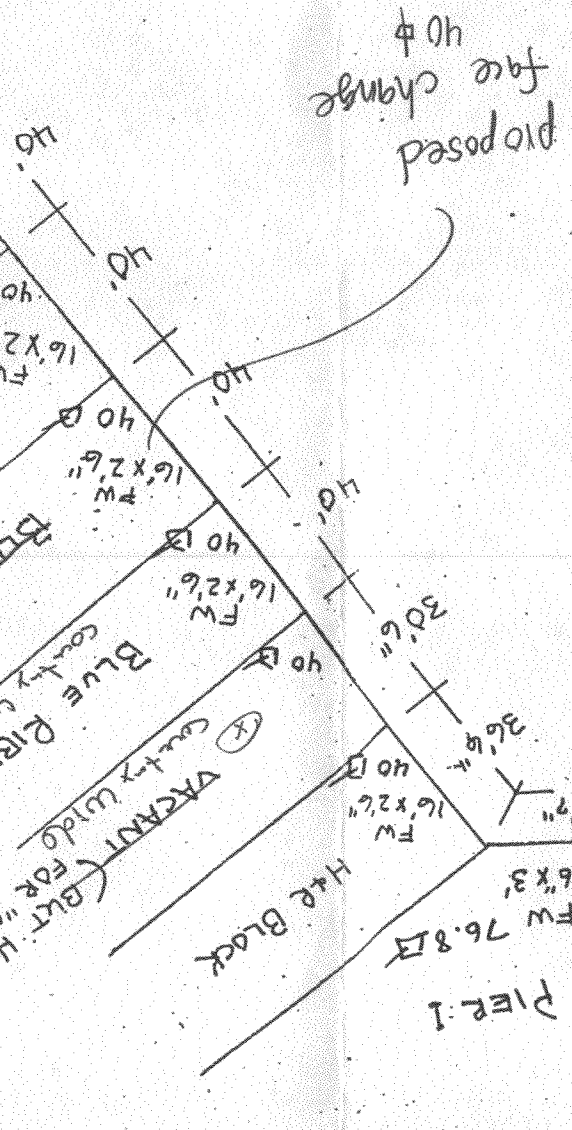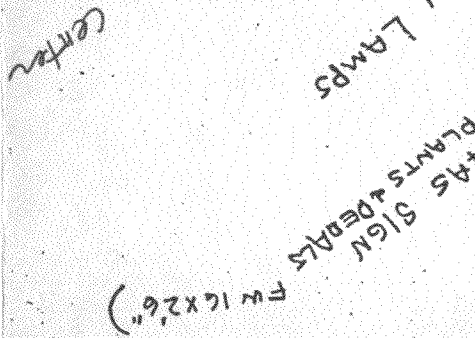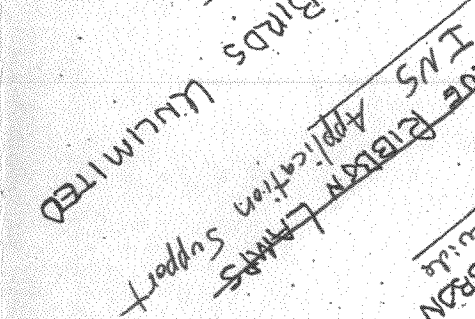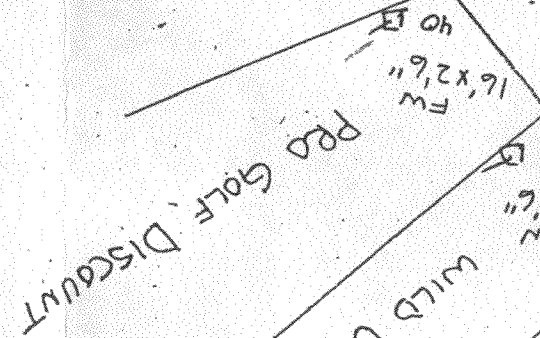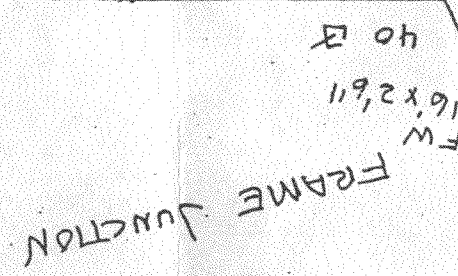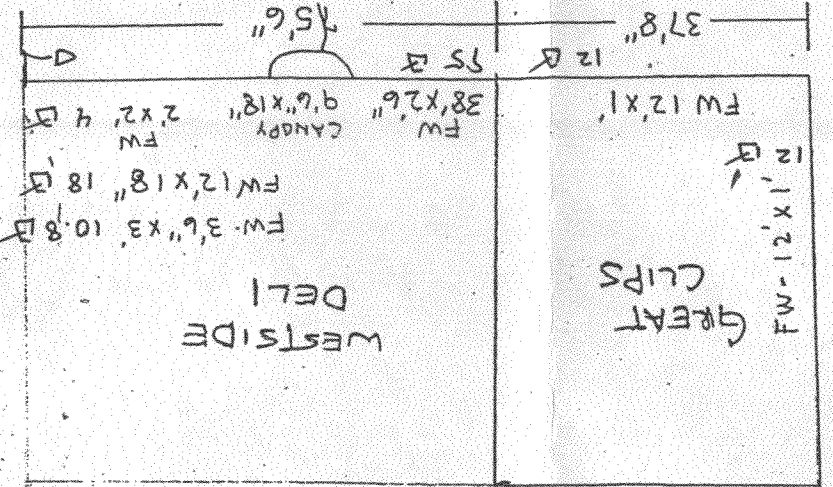

VALLEY PLAZA  
2454 Hwy 6+50

