

## Sign Permit

Community Development Department 250 North 5<sup>th</sup> Street Grand Junction CO 81501 Phone: (970) 244-1430 FAX (970) 256-4031

| Sish B                 | A |
|------------------------|---|
| Permit No              |   |
| Zone <u><u>R</u>-/</u> |   |


| Face change only on items 2, 3 & 4  7 2 Square Feet   | ADD TELE CON  per Linear Foot of Building | RESS 1040 P.+K.L. EPHONE NO. 248 - 276 TACT PERSON TODD  Ing Façade  Ing Facade | Aue.    |  |
|---|---|---|---------|--|
| [ ] 3. PROJECTING 0.5 Square Feet per each Linear Foot of Building Facade [ ] 4. FREE-STANDING 2 Traffic Lanes - 0.75 Square Feet x Street Frontage   |   |   |         |  |
| 4 or more Traffic Lanes - 1.5 Square Feet x Street Frontage  [ ] Existing Externally or Internally Illuminated – No Change in Electrical Service [ ] Non-Illuminated  |   |   |         |  |
| (1-4) Area of Proposed Sign: 2  |   |   |         |  |
| EXISTING SIGNAGE/TYPE:  |   | FOR OFFICE US   | E ONLY  |  |
|   | Sq. Ft.                                   | Signage Allowed on Parcel:  |         |  |
|   | Sq. Ft.                                   | Building  | Sq. Ft. |  |
|   | Sq. Ft.                                   | Free-Standing   | Sq. Ft. |  |
| Total Existing:   | Sq. Ft.                                   | Total Allowed:  | Sq. Ft. |  |
| COMMENTS: Church signa - per code - maximum 24 sq ft. regardless  |   |   |         |  |
| of billing facale or street frontage.   |   |   |         |  |
| NOTE: No sign may exceed 300 square feet. A separate sign permit is required for each sign. Attach a sketch, to scale, of proposed and existing signage including types, dimensions and lettering. Attach a plot plan, to scale, showing: abutting streets, alleys, easements, driveways, encroachments, property lines, distances from existing buildings to proposed signs and required setbacks. Roof signs shall be manufactured such that no guy wires, braces or supports shall be visible. |   |   |         |  |
| I hereby attest that the information on this form and the attached sketches are true and accurate.  |   |   |         |  |
| Loll Koche 10/9/07 Sayleer Herler 10-11-07 Applicant's Signature Date Community Development Approval Date   |   |   |         |  |
| Applicant's Signature   | Date Commu                                | nity Development Approval   | Date    |  |

(White: Community Development)

(Yellow: Applicant)

(Pink: Code Enforcement)



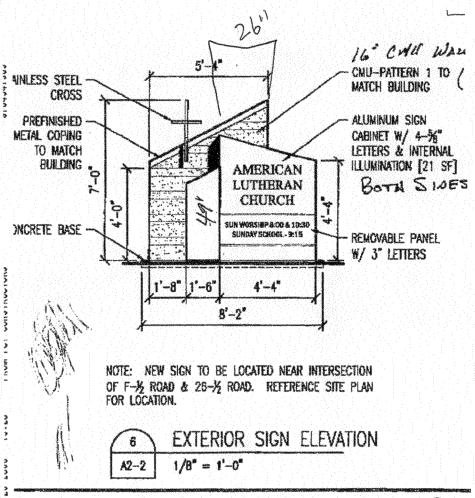

PRICE PER