



Sign Permit

Community Development Department
250 North 5th Street
Grand Junction CO 81501
Phone: (970) 244-1430 FAX (970) 256-4031

Sign A

Permit No.	_____
Date Submitted	6/25/07
Fee \$	250.00
Zone	F-1

TAX SCHEDULE	2701-313-06-008	CONTRACTOR	Bud's Signs
BUSINESS NAME	Cummins Rocky Mountain	LICENSE NO.	2070171
STREET ADDRESS	731 Scarlet St.	ADDRESS	1055 Ute Ave
PROPERTY OWNER	SAME	TELEPHONE NO.	245-7700
OWNER ADDRESS	SAME	CONTACT PERSON	TODD

<input checked="" type="checkbox"/> 1. FLUSH WALL	2 Square Feet per Linear Foot of Building Façade
Face change only on items 2, 3 & 4	
<input type="checkbox"/> 2. ROOF	2 Square Feet per Linear Foot of Building Façade
<input type="checkbox"/> 3. PROJECTING	0.5 Square Feet per each Linear Foot of Building Façade
<input type="checkbox"/> 4. FREE-STANDING	2 Traffic Lanes - 0.75 Square Feet x Street Frontage 4 or more Traffic Lanes - 1.5 Square Feet x Street Frontage

Existing Externally or Internally Illuminated - No Change in Electrical Service Non-Illuminated

(1-4) Area of Proposed Sign:	12	Square Feet	Building Façade Direction:	North	South	East	West
(1-3) Building Façade:	100	Linear Feet	Name of Street:	Scarlet			
(4) Street Frontage:	312	Linear Feet	Clearance to Grade:	3	Feet		
(2-4) Height to Top of Sign:	6	Feet					

EXISTING SIGNAGE/TYPE:	
_____	_____ Sq. Ft.
_____	_____ Sq. Ft.
_____	_____ Sq. Ft.
Total Existing:	0 Sq. Ft.

FOR OFFICE USE ONLY	
Signage Allowed on Parcel:	
Building	200 Sq. Ft.
Free-Standing	234 Sq. Ft.
Total Allowed:	234 Sq. Ft.

COMMENTS: _____

NOTE: No sign may exceed 300 square feet. A separate sign permit is required for each sign. Attach a sketch, to scale, of proposed and existing signage including types, dimensions and lettering. Attach a plot plan, to scale, showing: abutting streets, alleys, easements, driveways, encroachments, property lines, distances from existing buildings to proposed signs and required setbacks. Roof signs shall be manufactured such that no guy wires, braces or supports shall be visible.

I hereby attest that the information on this form and the attached sketches are true and accurate.

<u>Todd Koshover</u>	<u>6/25/07</u>	<u>Wendy Spurr</u>	<u>6/28/07</u>
Applicant's Signature	Date	Community Development Approval	Date

(White: Community Development) (Yellow: Applicant) (Pink: Code Enforcement)



Sign Permit

Community Development Department
250 North 5th Street
Grand Junction CO 81501
Phone: (970) 244-1430 FAX (970) 256-4031

Sign B

Permit No.	_____
Date Submitted	6/25/07
Fee \$	500
Zone	I-1

TAX SCHEDULE	2701-313-06-008	CONTRACTOR	Bud's Signs
BUSINESS NAME	Cummins Rocky Mtn.	LICENSE NO.	207 0171
STREET ADDRESS	731 Scarlet St	ADDRESS	1055 Wk Ave.
PROPERTY OWNER	SAME	TELEPHONE NO.	245-2200
OWNER ADDRESS	SAME	CONTACT PERSON	TODD

<input checked="" type="checkbox"/> 1. FLUSH WALL	2 Square Feet per Linear Foot of Building Façade
Face change only on items 2, 3 & 4	
<input type="checkbox"/> 2. ROOF	2 Square Feet per Linear Foot of Building Façade
<input type="checkbox"/> 3. PROJECTING	0.5 Square Feet per each Linear Foot of Building Façade
<input type="checkbox"/> 4. FREE-STANDING	2 Traffic Lanes - 0.75 Square Feet x Street Frontage 4 or more Traffic Lanes - 1.5 Square Feet x Street Frontage

Existing Externally or Internally Illuminated - No Change in Electrical Service Non-Illuminated

(1-4) Area of Proposed Sign:	12	Square Feet	Building Façade Direction:	North	South	East	West
(1-3) Building Façade:	100	Linear Feet	Name of Street:	Scarlet			
(4) Street Frontage:	312	Linear Feet	Clearance to Grade:	16	Feet		
(2-4) Height to Top of Sign:	18	Feet					

EXISTING SIGNAGE/TYPE:	
Flush wall Sign A	12 Sq. Ft.
Sign B	12 Sq. Ft.
_____	_____ Sq. Ft.
_____	_____ Sq. Ft.
Total Existing:	24 Sq. Ft.

FOR OFFICE USE ONLY	
Signage Allowed on Parcel:	
Building	200 Sq. Ft.
Free-Standing	234 Sq. Ft.
Total Allowed:	234 Sq. Ft.


COMMENTS: _____

NOTE: No sign may exceed 300 square feet. A separate sign permit is required for each sign. Attach a sketch, to scale, of proposed and existing signage including types, dimensions and lettering. Attach a plot plan, to scale, showing: abutting streets, alleys, easements, driveways, encroachments, property lines, distances from existing buildings to proposed signs and required setbacks. Roof signs shall be manufactured such that no guy wires, braces or supports shall be visible.


I hereby attest that the information on this form and the attached sketches are true and accurate.

<u>Jodel Koshew</u>	<u>6/25/07</u>	<u>Wendy Spurr</u>	<u>6/28/07</u>
Applicant's Signature	Date	Community Development Approval	Date

(White: Community Development) (Yellow: Applicant) (Pink: Code Enforcement)

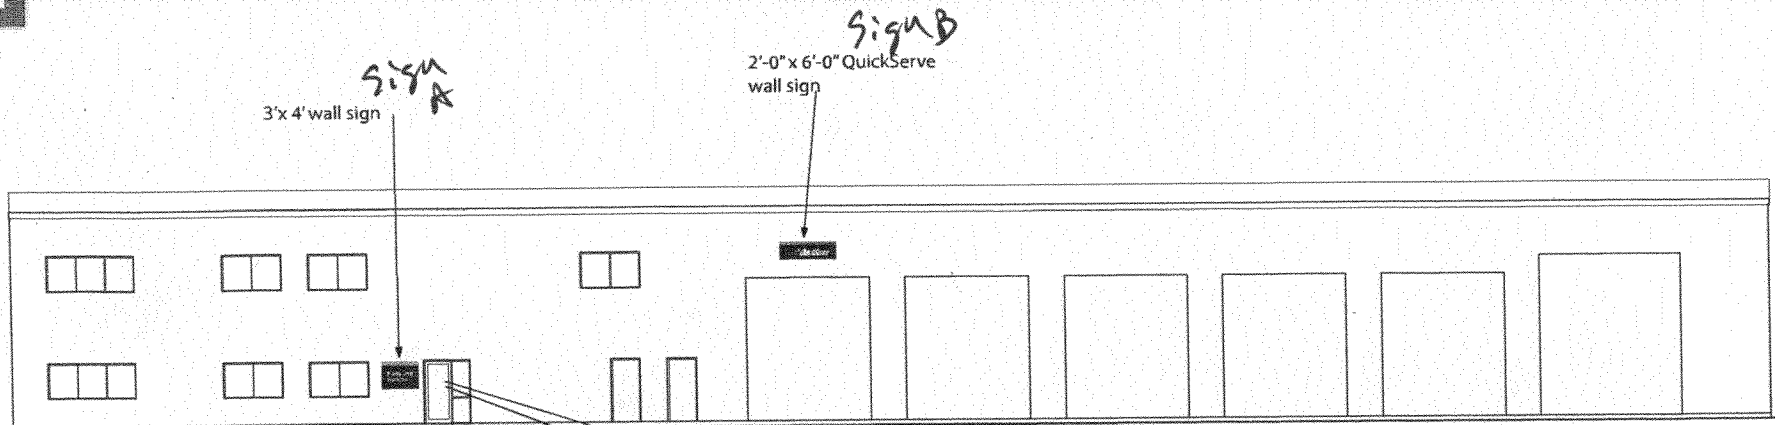

NORTH ELEVATION

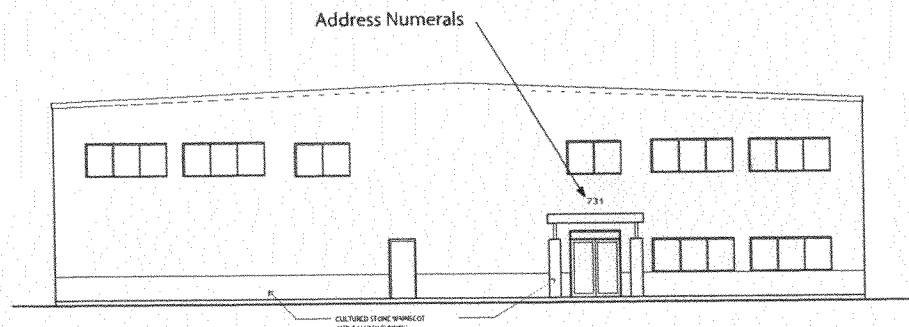

EAST ELEVATION

