


Independent Ave.




North
→

City of Grand Junction GIS Zoning Map ©

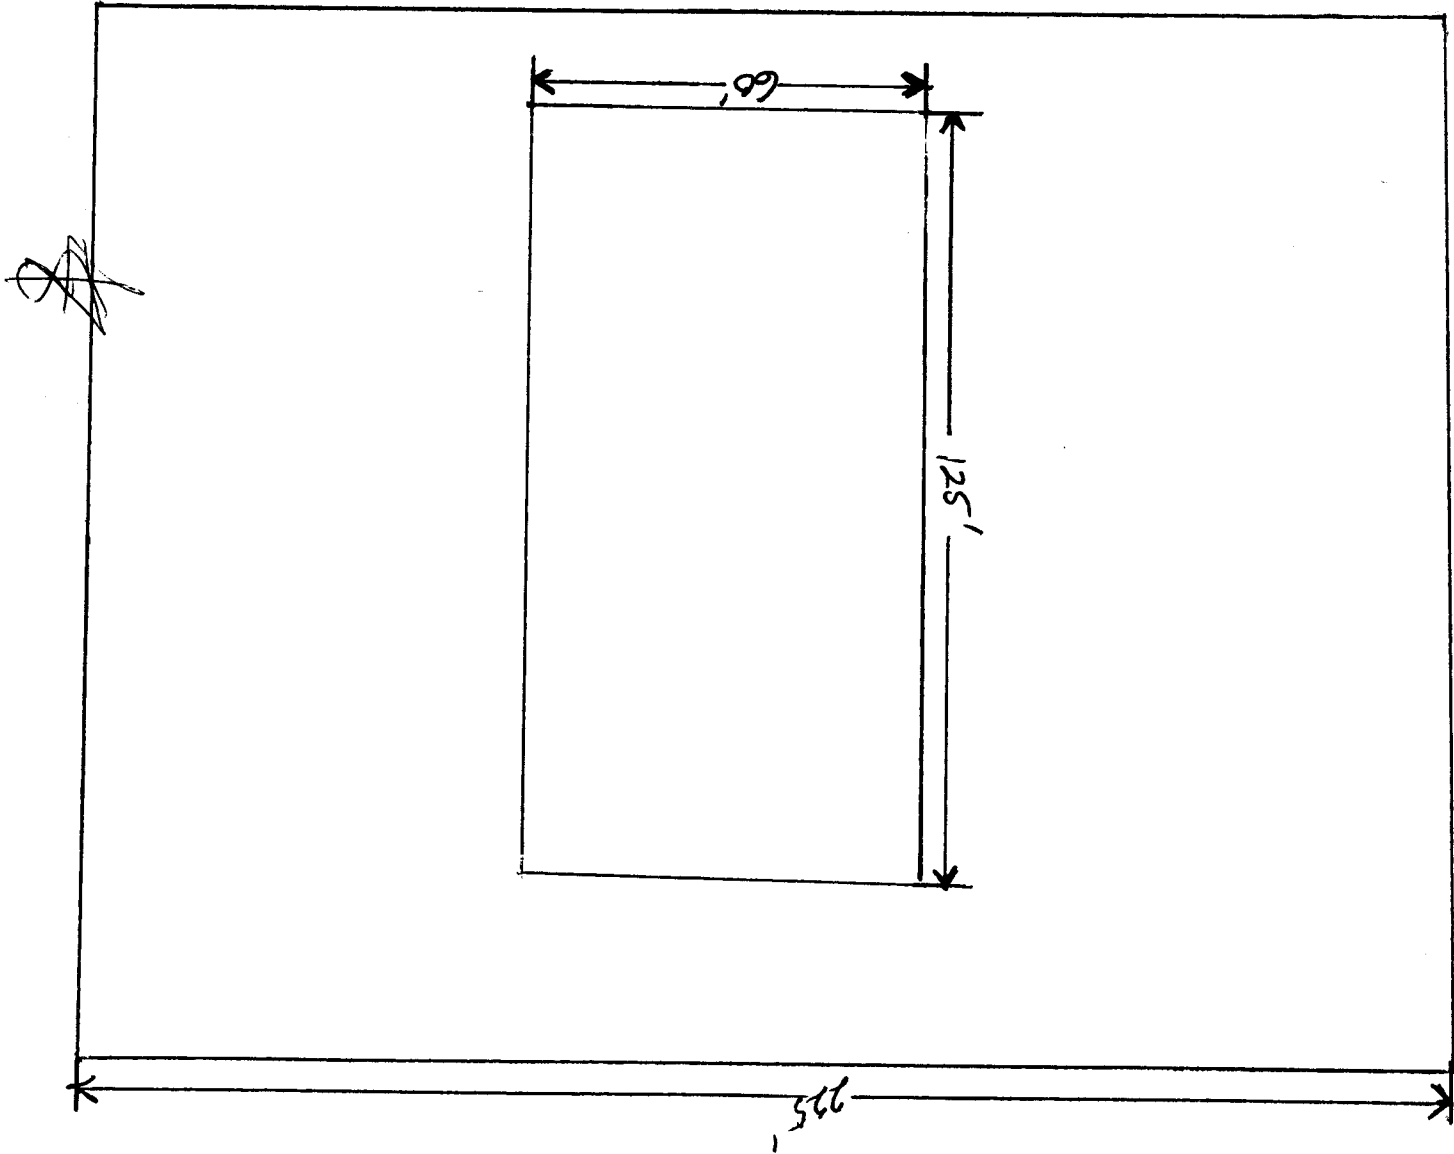

ACCEPTED
ANY CHANGES OR FEEDBACKS MUST BE

East Elev.

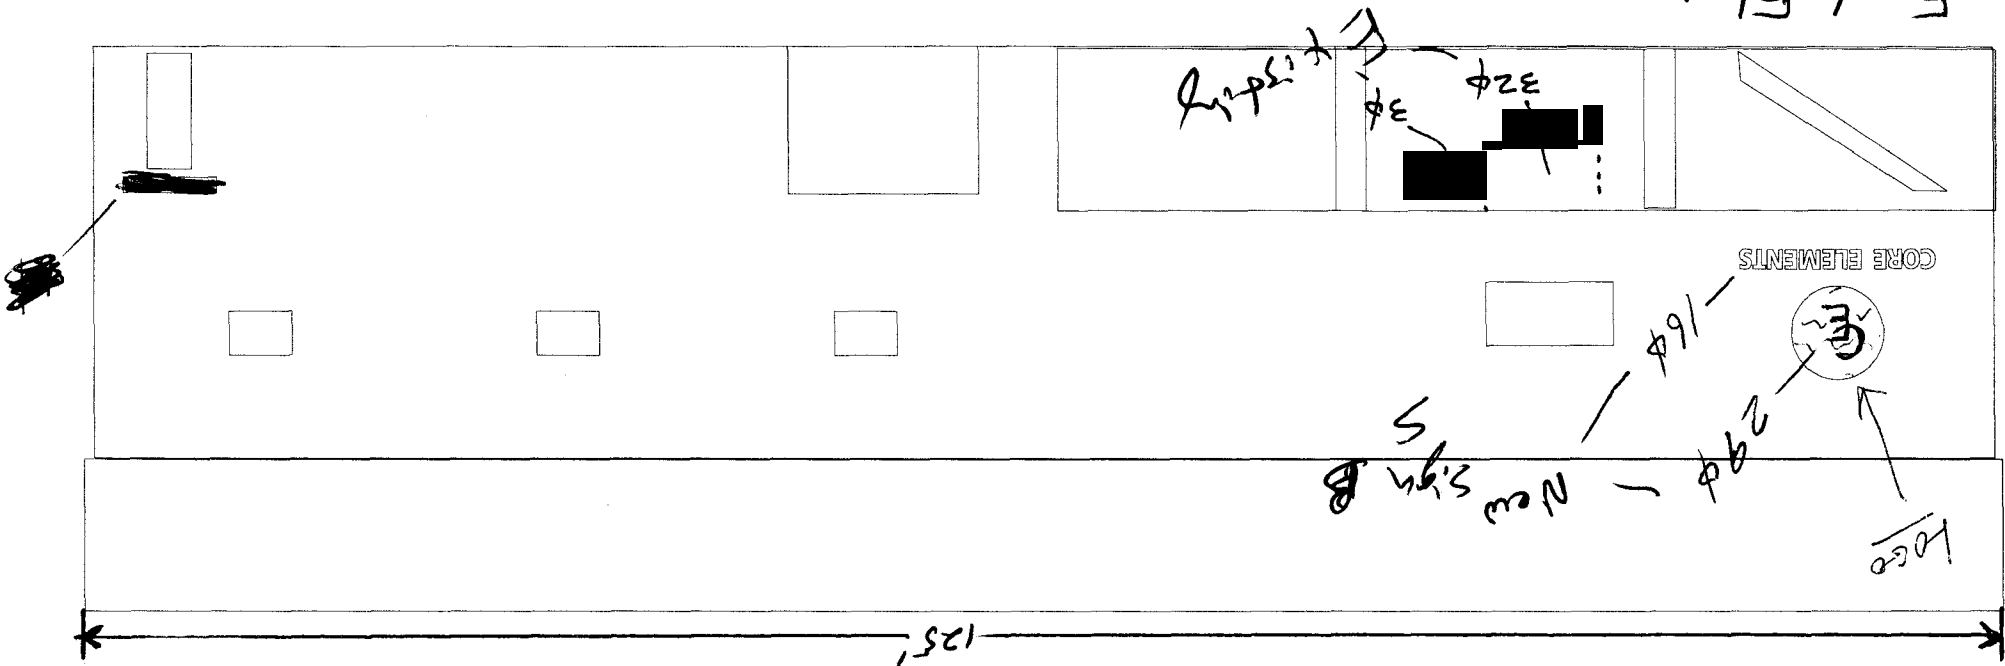

~~North Elev.~~

