

Public Works and Planning Department 250 North 5th Street, Grand Junction CO 81501 Tel: (970) 244-1430 FAX (970) 256-4031

Sign Permit For Signs that DO NOT Require

a Building Permit

Date Submitted	4/26/10
Fee \$_25	pial 4/24/10
Zone	

TAX SCHEDULE NO. 2445-142-25-014 BUSINESS NAME <u>Performance Center</u> STREET ADDRESS <u>616</u> N. 15t PROPERTY OWNER <u>Vicki Budini</u> OWNER ADDRESS <u>Sume</u>	LICENSE ADDRES TELEPHO	CTOR <u>Platinum Sign</u> NO. <u>2051305</u> S <u>2916 I. 70 B</u> DNE <u>248-9677</u> TPERSON <u>Milue</u>	
[] 1. FLUSH WALL 2 Square Feet per Linear Foot of Building Façade [] 2. ROOF 2 Square Feet per Linear Foot of Building Facade [] 3. PROJECTING 0.5 Square Feet per each Linear Foot of Building Facade [] 4. FREE-STANDING 2 Traffic Lanes - 0.75 Square Feet x Street Frontage 4 or more Traffic Lanes - 1.5 Square Feet x Street Frontage			
[] Existing Externally or Internally Illuminated – No Change in Electrical Service [X] Non-Illuminated			
(1-4) Area of Proposed Sign: Square Feet (1-3) Building Façade: ↓ ★ ↓ ↓ ↓ ↓ ↓ ↓ ↓ ↓ ↓ ↓ ↓ ↓ ↓ ↓ ↓ ↓ ↓ ↓			
EXISTING SIGNAGE TYPE & SQUARE FOOTAGE:		FOR OFFICE USE ONLY	
	Sq. Ft.	Signage Allowed on Parcel:	
	Sq. Ft.	Building Sq. Ft.	
	Sq. Ft.	Free-Standing 187.5 Sq. Ft.	
Total Existing:	Sq. Ft.	Total Allowed: 187.5 Sq. Ft.	
COMMENTS: Face Change			

NOTE: No sign may exceed 300 square feet. A separate sign permit is required for each sign. Attach a sketch, to scale, of proposed and existing signage including types, dimensions and lettering. Attach a plot plan, to scale, showing: abutting streets, alleys, easements, driveways, encroachments, property lines, distances from existing buildings to proposed signs and required setbacks. Roof signs shall be manufactured such that no guy wires, braces or supports shall be visible.

I hereby attest that the information on this form and the attached sketches are true and accurate.

Applicant's Signature

4-30-10 Lauren Henderson 426-10 Manning Approval Date


Date

(White: Planning)

(Yellow: Neighborhood Services)

(Pink: Applicant)

City of Grand Junction GIS City Map ©

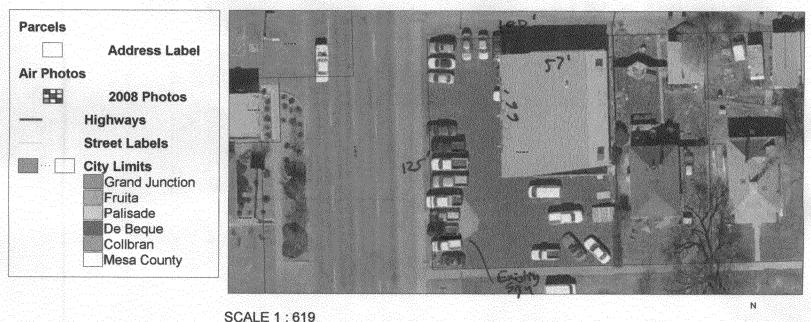

50 0 50 100 150 FEET Å

Vick: Budini 2945-142-25-014

616 N Ist. St



