



Sign Clearance

For Signs that Require a Building Permit

Bldg Permit No.	_____
Date Submitted	<u>1/14/10</u>
Fee \$	<u>250</u>
Zone	<u>C-1</u>

Public Works & Planning Department
 250 North 5th Street, Grand Junction CO 81501
 Tel: (970) 244-1430 FAX (970) 256-4031

TAX SCHEDULE NO. <u>2701-36400-122</u>	CONTRACTOR <u>Western Neon Sign Co., Inc.</u>
BUSINESS NAME <u>Shell</u>	LICENSE NO. <u>2090474</u>
STREET ADDRESS <u>745 Horizon Drive</u>	ADDRESS <u>3183 Hall Ave</u>
PROPERTY OWNER <u>Western States Metal Operations</u>	TELEPHONE NO. <u>523-4045</u>
OWNER ADDRESS <u>745 Horizon Drive</u>	CONTACT PERSON <u>John</u>

- | | |
|--|---|
| <input type="checkbox"/> 1. FLUSH WALL | 2 Square Feet per Linear Foot of Building Facade |
| <input type="checkbox"/> 2. ROOF | 2 Square Feet per Linear Foot of Building Facade |
| <input checked="" type="checkbox"/> 3. FREE-STANDING | 2 Traffic Lanes - 0.75 Square Feet x Street Frontage
4 or more Traffic Lanes - 1.5 Square Feet x Street Frontage |
| <input type="checkbox"/> 4. PROJECTING | 0.5 Square Feet per each Linear Foot of Building Facade |
| <input type="checkbox"/> 5. OFF-PREMISE | See #3 Spacing Requirements; Not > 300 Square Feet or < 15 Square Feet |

Externally Illuminated Internally Illuminated Non-Illuminated

(1 - 5) Area of Proposed Sign: 125 Square Feet

(1,2,4) Building Façade: 44 Linear Feet Building Façade Direction: North South East West

(1 - 4) Street Frontage: 500 Linear Feet Name of Street: Horizon Drive

(2 - 5) Height to Top of Sign: 40 Feet Clearance to Grade: 10 Feet

(5) Distance to Nearest Existing Off-Premise Sign: 10 NA Feet

EXISTING SIGNAGE TYPE & SQUARE FOOTAGE:	
<u>Holiday Inn wall signs</u>	<u>200</u> Sq. Ft.
<u>(2 @ 100 sqft)</u>	_____ Sq. Ft.
<u>Food mart wall sign</u>	<u>8</u> Sq. Ft.
Total Existing:	<u>208</u> Sq. Ft.

FOR OFFICE USE ONLY	
Signage Allowed on Parcel for ROW:	
<u>44 x 2</u> Building	<u>88</u> Sq. Ft.
500 x 1.5 Free-Standing	750 <u>375</u> Sq. Ft.
Total Allowed:	1230 <u>375</u> Sq. Ft.

COMMENTS: Remove the existing price sign cabinet & the western union sign cabinet & installing one new price sign - reader board

NOTE: No sign may exceed 300 square feet. A separate sign clearance is required for each sign. Attach a sketch, to scale, of proposed and existing signage including types, dimensions and lettering. Attach a plot plan, to scale, showing: abutting streets, alleys, easements, driveways, encroachments, property lines, distances from existing buildings to proposed signs and required setbacks. **A SEPARATE PERMIT FROM THE BUILDING DEPARTMENT IS ALSO REQUIRED.**


I hereby attest that the information on this form and the attached sketches are true and accurate.

John O. Adams 1-14-2010 PD Lynda Reynolds 1-26-2010

Applicant's Signature Date Planning Approval Date

(White: Planning) (Yellow: Neighborhood Services) (Pink: Building Permit) (Goldenrod: Applicant)

Existing Sign

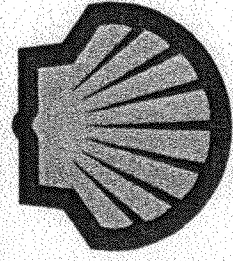



Regular 1.23
 Plus 1.33
 Premium 1.43
 Diesel 2.34




New Sign

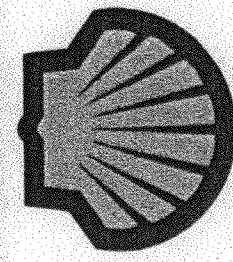


New Price Sign -
 Readerboard

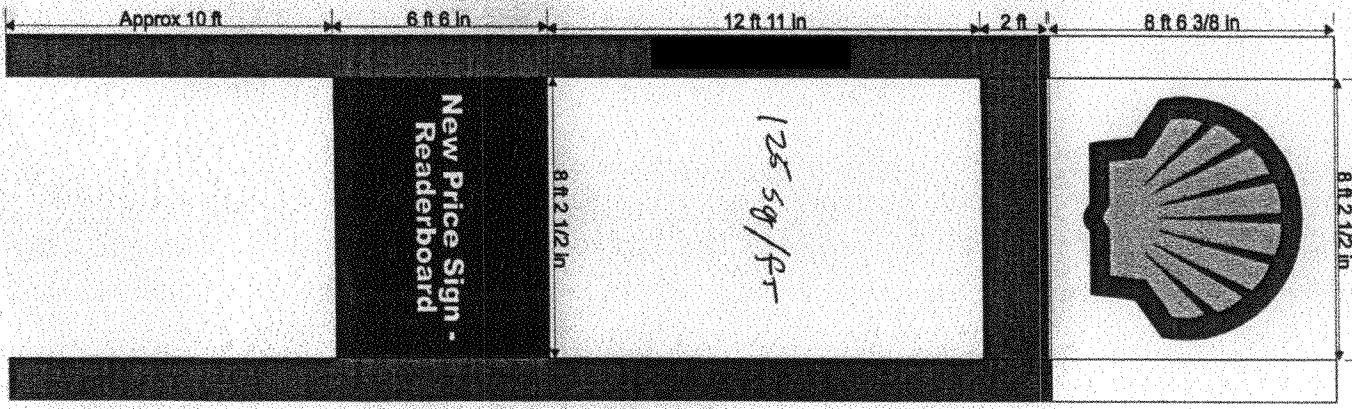


© 2008 W.N.S.C.


Customer: _____
 Company: _____
 Address: _____
 City: _____ State/ZIP: _____
 Phone: _____
 Fax: _____

WESTERN NEON SIGN COMPANY INC.
 Reasonable Rates
SIGN We Do It All!
 Professional Services
 Design - Fabrication - Installation
 Office: (970) 523-4045 Fax: (970) 523-4048
 1-800-886-3661
 5183 Hall Ave, Grand Junction, CO 81504


Job No.: _____ Date: 11/25/2008
 Order Date: _____ Designed by: Jeremy Bergen
 ALL RIGHTS RESERVED No part of this design and layout may be reproduced or utilized in any form or by any means without permission in writing from Western Neon Sign Co. Inc.
 Please sign that this layout is approved, then fax / mail back. Production will start once approval has been received.
 Name: _____ Date: _____

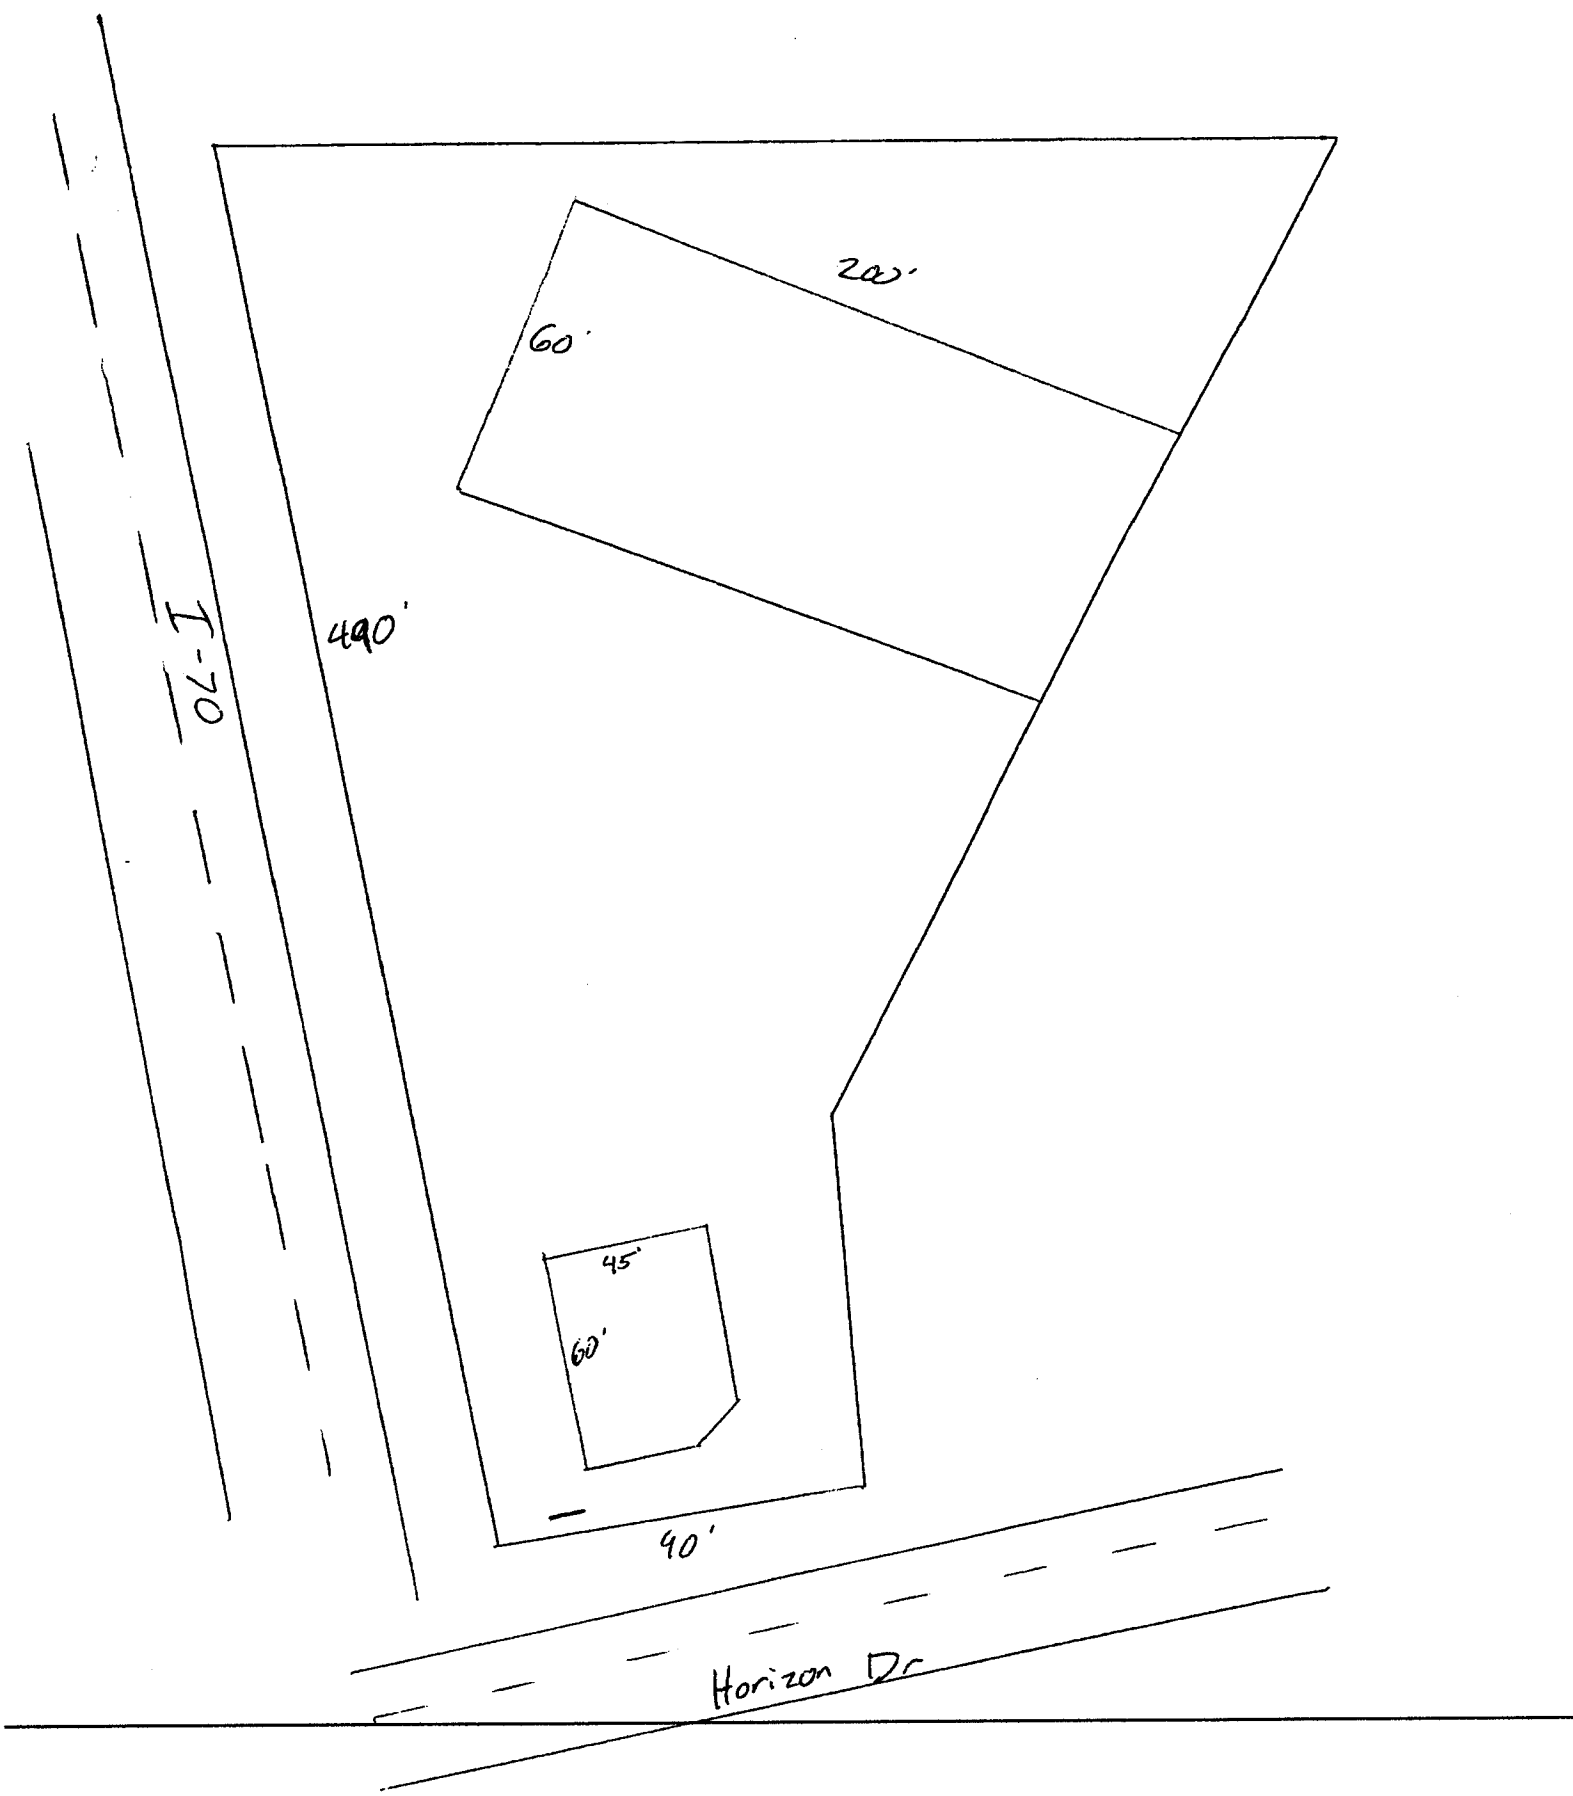

Existing Sign

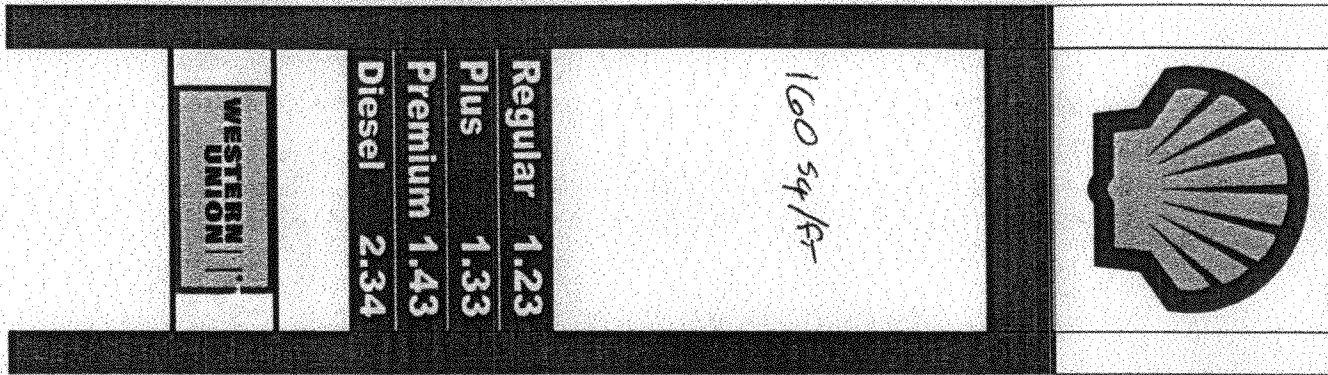

New Sign

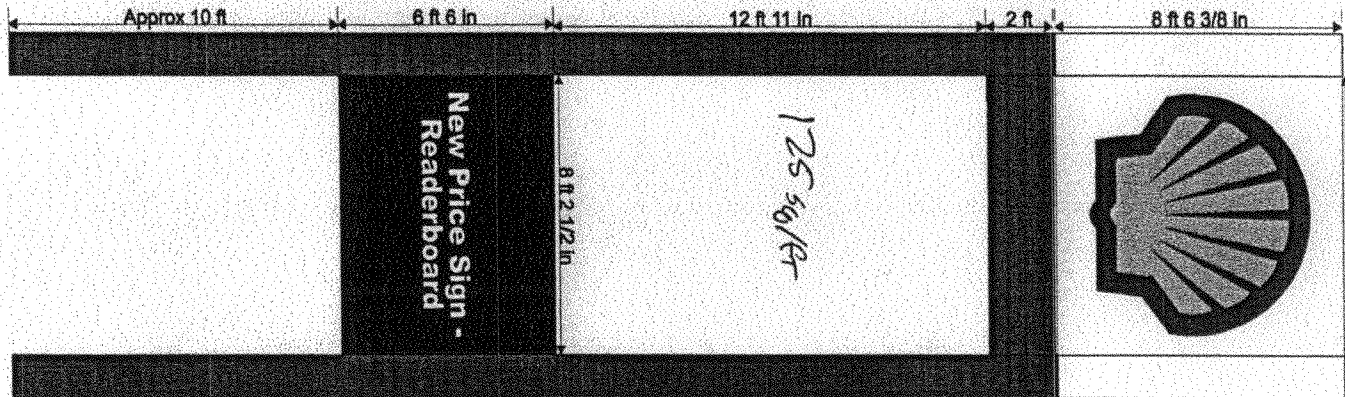

© 2008 W.N.S.C.

Customer:	
Company:	
Address:	
City:	State/ZIP:
Phone:	
Fax:	


WESTERN NEON SIGN COMPANY INC.
 Reasonable Rates
SIGN We Do It All!
 Professional Services
 Design - Fabrication - Installation
 Office: (970) 523-4045 Fax: (970) 523-4046
 1-800-886-3661
 3183 Hall Ave, Grand Junction, CO 81504

Job No.:	Date: 11/25/2008
Order Date:	Designed by: Jeremy Bergen
ALL RIGHTS RESERVED No part of this design and layout may be reproduced or utilized in any form or by any means without permission in writing from Western Neon Sign Co. Inc.	
Please sign that this layout is approved, then fax / mail back. Production will start once approval has been received.	
Name:	Date:

City of Grand Junction GIS Zoning Map ©



SCALE 1 : 779

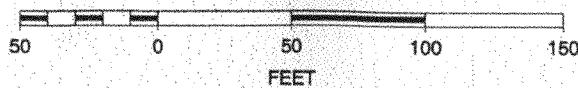

Wednesday, November 26, 2008 9:18 AM