

CDH736TH

TYPE OF RECORD: PERMANENT

CATEGORY OF RECORD: **UMTRA (REPORT)**

NAME OF CONTRACTOR: COLORADO DEPARTMENT OF HEALTH

SUBJECT/PROJECT: RADIATION SURVEY

STREET ADDRESS/PARCEL/SUBDIVISION: 330 SOUTH 6<sup>TH</sup> STREET -  
MAIN FIRE STATION - LOCATION 00434

PARCEL NO.: 2945-143-31-944

CITY DEPARTMENT: PUBLIC WORKS

YEAR: 1973

EXPIRATION DATE: NONE

DESTRUCTION DATE: NONE



COLORADO

DEPARTMENT OF HEALTH

4210 EAST 11TH AVENUE • DENVER, COLORADO 80220 • PHONE 388-6111

R. L. CLEERE, M.D., M.P.H., DIRECTOR

June 29, 1973

City of Grand Junction  
Harvey Rose, City Manager  
Stanley Anderson, Mayor  
City Hall, 5th and Road  
Grand Junction, CO 81501

Re: Location #00434  
Main Fire Station  
330 South 6th St

Gentlemen:

We are pleased to report to you that no indication of uranium mill tailings was found under the structure in our survey of your property.

We must, however, inform you that tailings have been located on your property as indicated on the attached survey report. This location does not present any problem of radiation exposure to you at this time. If, at a later date, construction is considered over the indicated area, we recommend corrective action be considered.

Our survey in Grand Junction is continuing. Because of the time-consuming nature of this evaluation, we are not able to notify all property owners simultaneously of our findings. Thus, some of your friends and neighbors whose homes we have evaluated may not receive notification letters, indicating either the presence or absence of tailings, for some months.

We appreciate your cooperation in this survey. If you have any questions, please feel free to call our Grand Junction Office at 243-7830.

Sincerely,

Roy L. Cleere, M.D., M.P.H.  
Executive Director

Attachment- Survey Map  
cc: Fire Chief  
Main Fire Station  
330 South 6th St.  
Grand Junction, CO 81501

COLORADO DEPARTMENT OF HEALTH

OFFICIAL SURVEY REPORT

Property Address 330 S 6th Street Grand Junction, CO 81501

Property Owner City of G. J., Harvey Rose, City Manager  
Stanley Anderson, Mayor

Owner Address (if different than above) 5th S Road, City Hall

Date of Report June 29, 1973

I.  No indication of uranium mill tailings has been found on this property. See Item III below.

Uranium Mill tailings are indicated to be on this property and are located:

- in yard only walks and lawns
- under or around garage or patio only
- under or around the house
- under or around the house and in yard
- under or around the building (business, church, etc.)

II. RESULTS OF THE RADIATION SURVEY IN THE STRUCTURE INDICATE:

Average gamma radiation exposure rate of background mR/hr. This compares with the Surgeon General's recommendation for corrective action at 0.05 mR/hr. essentially

Average radon daughter concentration of UNDETERMINED WL. This compares with the Surgeon General's recommendation for corrective action at 0.010 WL.

The presence of uranium tailings under occupied areas necessitating corrective action.


III. RECOMMENDATION:

You are advised to remove tailings if feasible or take other means of corrective action to reduce the radiation exposure.

Location of identified tailings and radiation levels do not warrant immediate action. However, if use of the identified area is changed in the future, removal if feasible or other corrective action or control should be considered.

Recommendations will be provided to you when measurements of radon daughter concentration have been completed.

Other radiation sources (non-tailings) have been identified on your property, such as instrument dials, ore samples, etc. Removal is suggested, if practical.

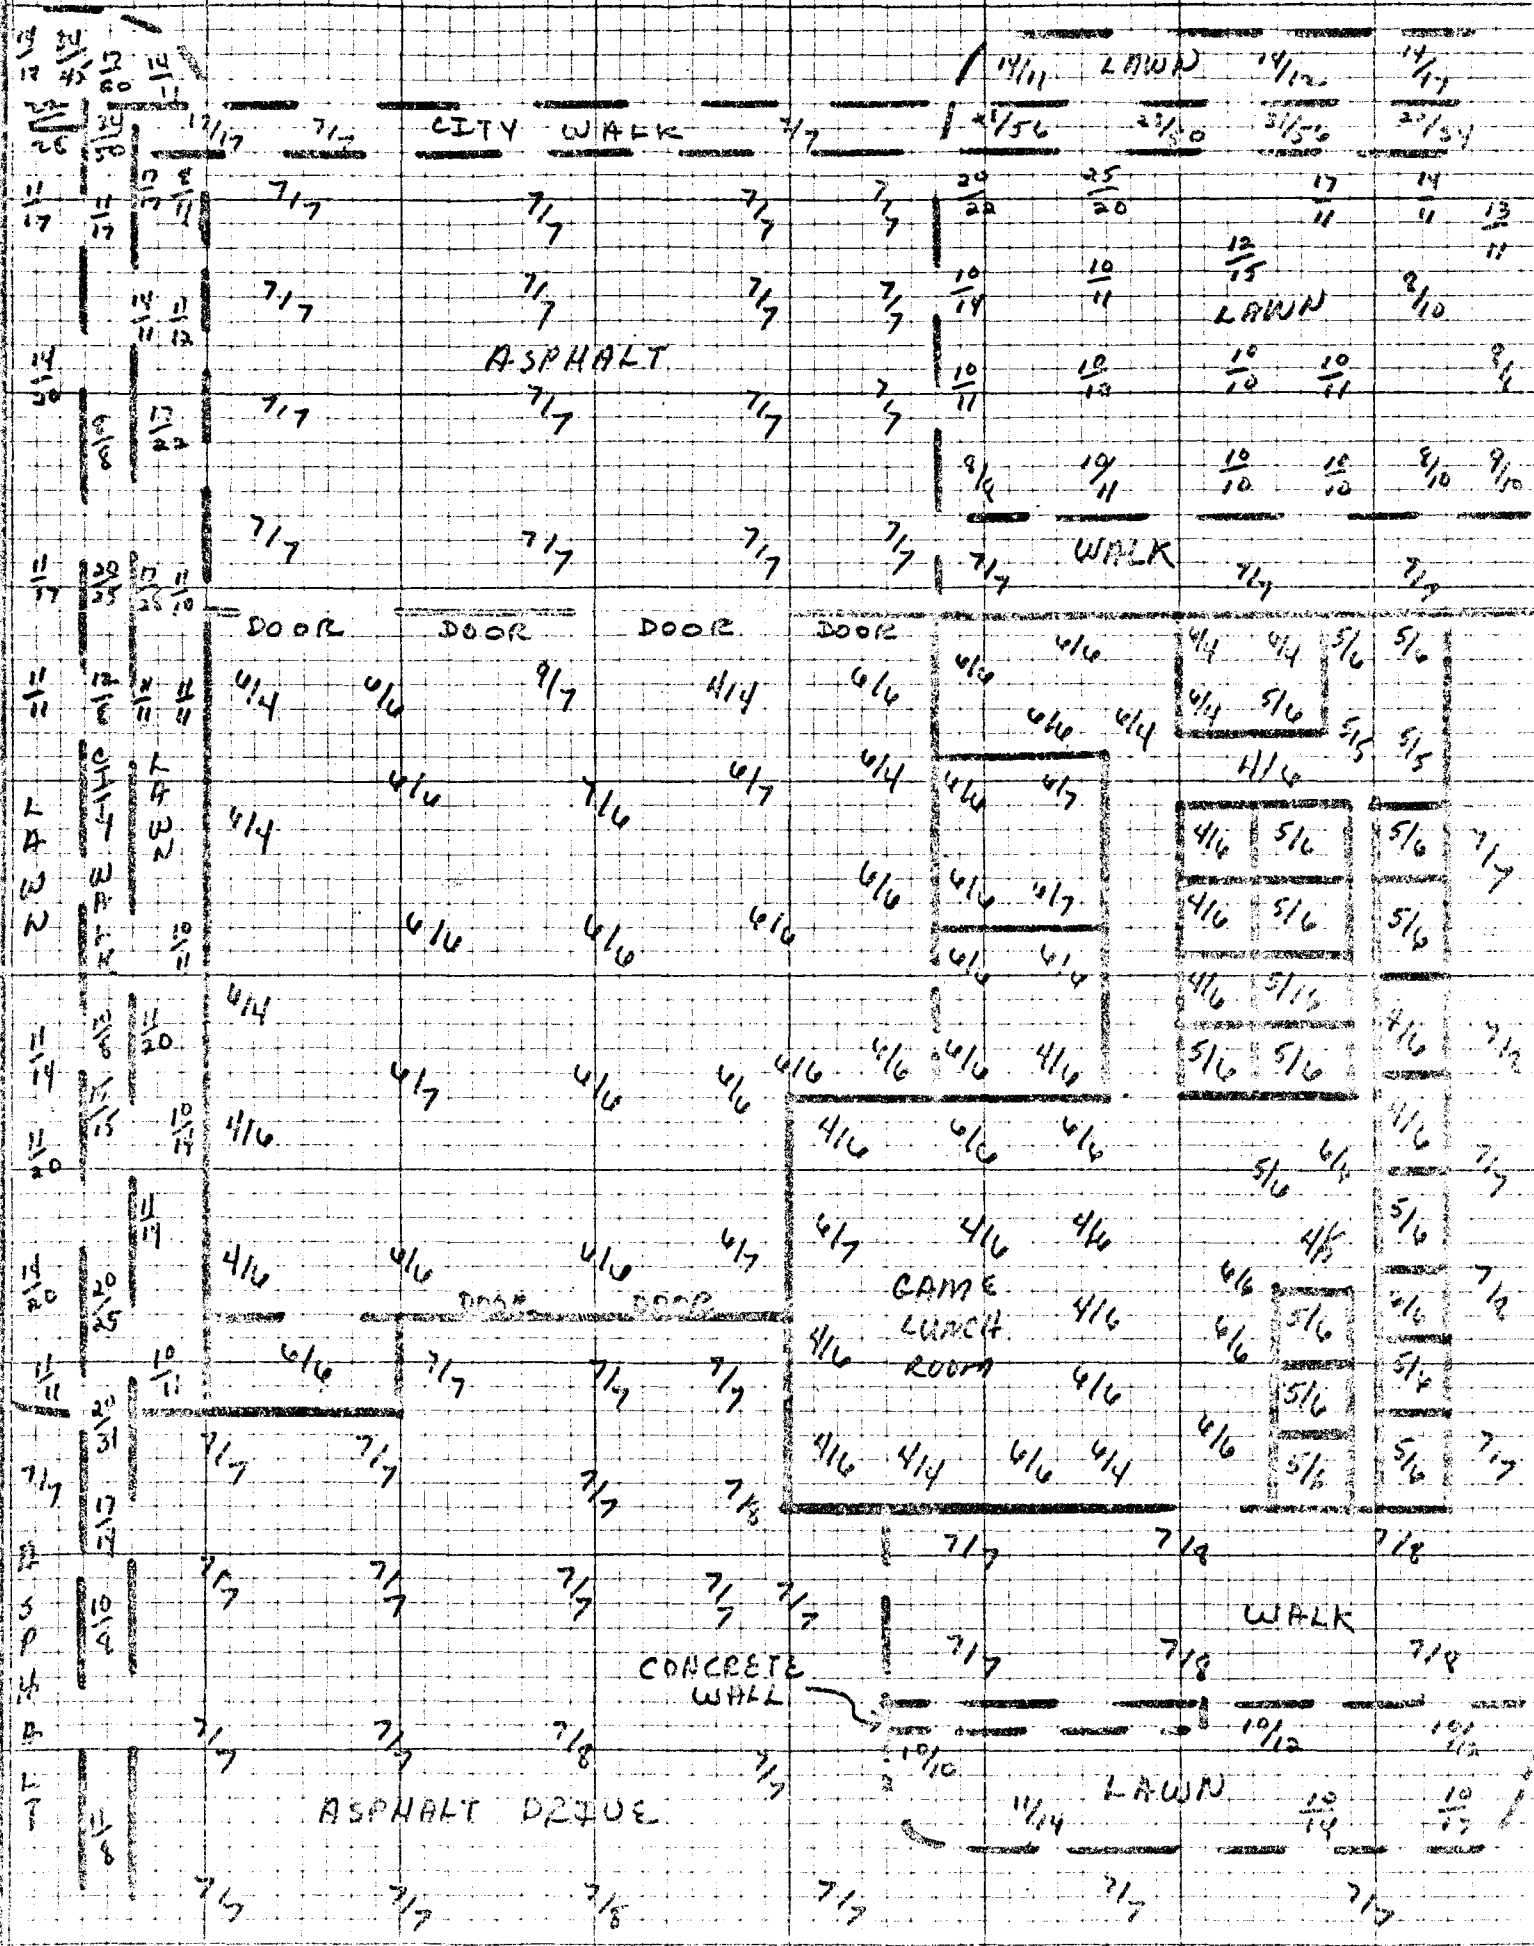

SEE REVERSE SIDE