

DATE SUBMITTED: 9-22-92

PERMIT NO. 49053 ✓

FEE \$ 5.00

# PLANNING CLEARANCE

GRAND JUNCTION COMMUNITY DEVELOPMENT DEPARTMENT

BLDG ADDRESS 2776 Cheyenne Dr SQ. FT. OF BLDG: \_\_\_\_\_

SUBDIVISION \_\_\_\_\_ SQ. FT. OF LOT: \_\_\_\_\_

FILING # \_\_\_\_\_ BLK # \_\_\_\_\_ LOT # \_\_\_\_\_ NO. OF FAMILY UNITS: \_\_\_\_\_

TAX SCHEDULE # 2945-244 04 017 NO. OF BUILDINGS ON PARCEL BEFORE THIS PLANNED CONSTRUCTION: \_\_\_\_\_

OWNER KATHY MERIER USE OF EXISTING BUILDINGS: \_\_\_\_\_

ADDRESS 2776 Cheyenne Dr RESIDENCE

TELEPHONE: 243-8679 DESCRIPTION OF WORK AND INTENDED USE: GARAGE & RATIO COVER

REQUIRED: Two plot plans showing parking, landscaping, setbacks to all property lines, and all streets which abut the parcel.

\*\*\*\*\*  
FOR OFFICE USE ONLY

ZONE \_\_\_\_\_ FLOODPLAIN: YES \_\_\_\_\_ NO \_\_\_\_\_

SETBACKS: FRONT \_\_\_\_\_ GEOLOGIC HAZARD: YES \_\_\_\_\_ NO \_\_\_\_\_

SIDE \_\_\_\_\_ REAR \_\_\_\_\_ CENSUS TRACT: \_\_\_\_\_ TRAFFIC ZONE: \_\_\_\_\_

MAXIMUM HEIGHT \_\_\_\_\_ PARKING REQ'MT \_\_\_\_\_

LANDSCAPING/SCREENING REQUIRED: \_\_\_\_\_ SPECIAL CONDITIONS: \_\_\_\_\_

\*\*\*\*\*  
Modifications to this Planning Clearance must be approved, in writing, by this Department. The structure approved by this application cannot be occupied until a Certificate of Occupancy is issued by the Building Department (Section 307, Uniform Building Code).

Any landscaping required by this permit shall be maintained in an acceptable and healthy condition. The replacement of any vegetation materials that die or are in an unhealthy condition shall be required.

I hereby acknowledge that I have read this application and the above is correct, and I agree to comply with the requirements above. Failure to comply shall result in legal action.

M. Pety  
Department Approval


William Tiefenbach  
Applicant Signature

9-22-92  
Date Approved

21 Sept 92  
Date

VALID FOR SIX MONTHS FROM DATE OF ISSUANCE (Section 9-3-2 D Grand Junction Zoning & Development Code)

ACCEPTED MP 9-22-92  
ANY CHANGE OF SETBACKS MUST BE  
APPROVED BY THE CITY PLANNING  
DEPARTMENT AS THE APPLICANT'S  
RESPONSIBILITY TO PROPERLY  
LOCATE AND SETBACK EASEMENTS  
AND PROPERTY LINES.

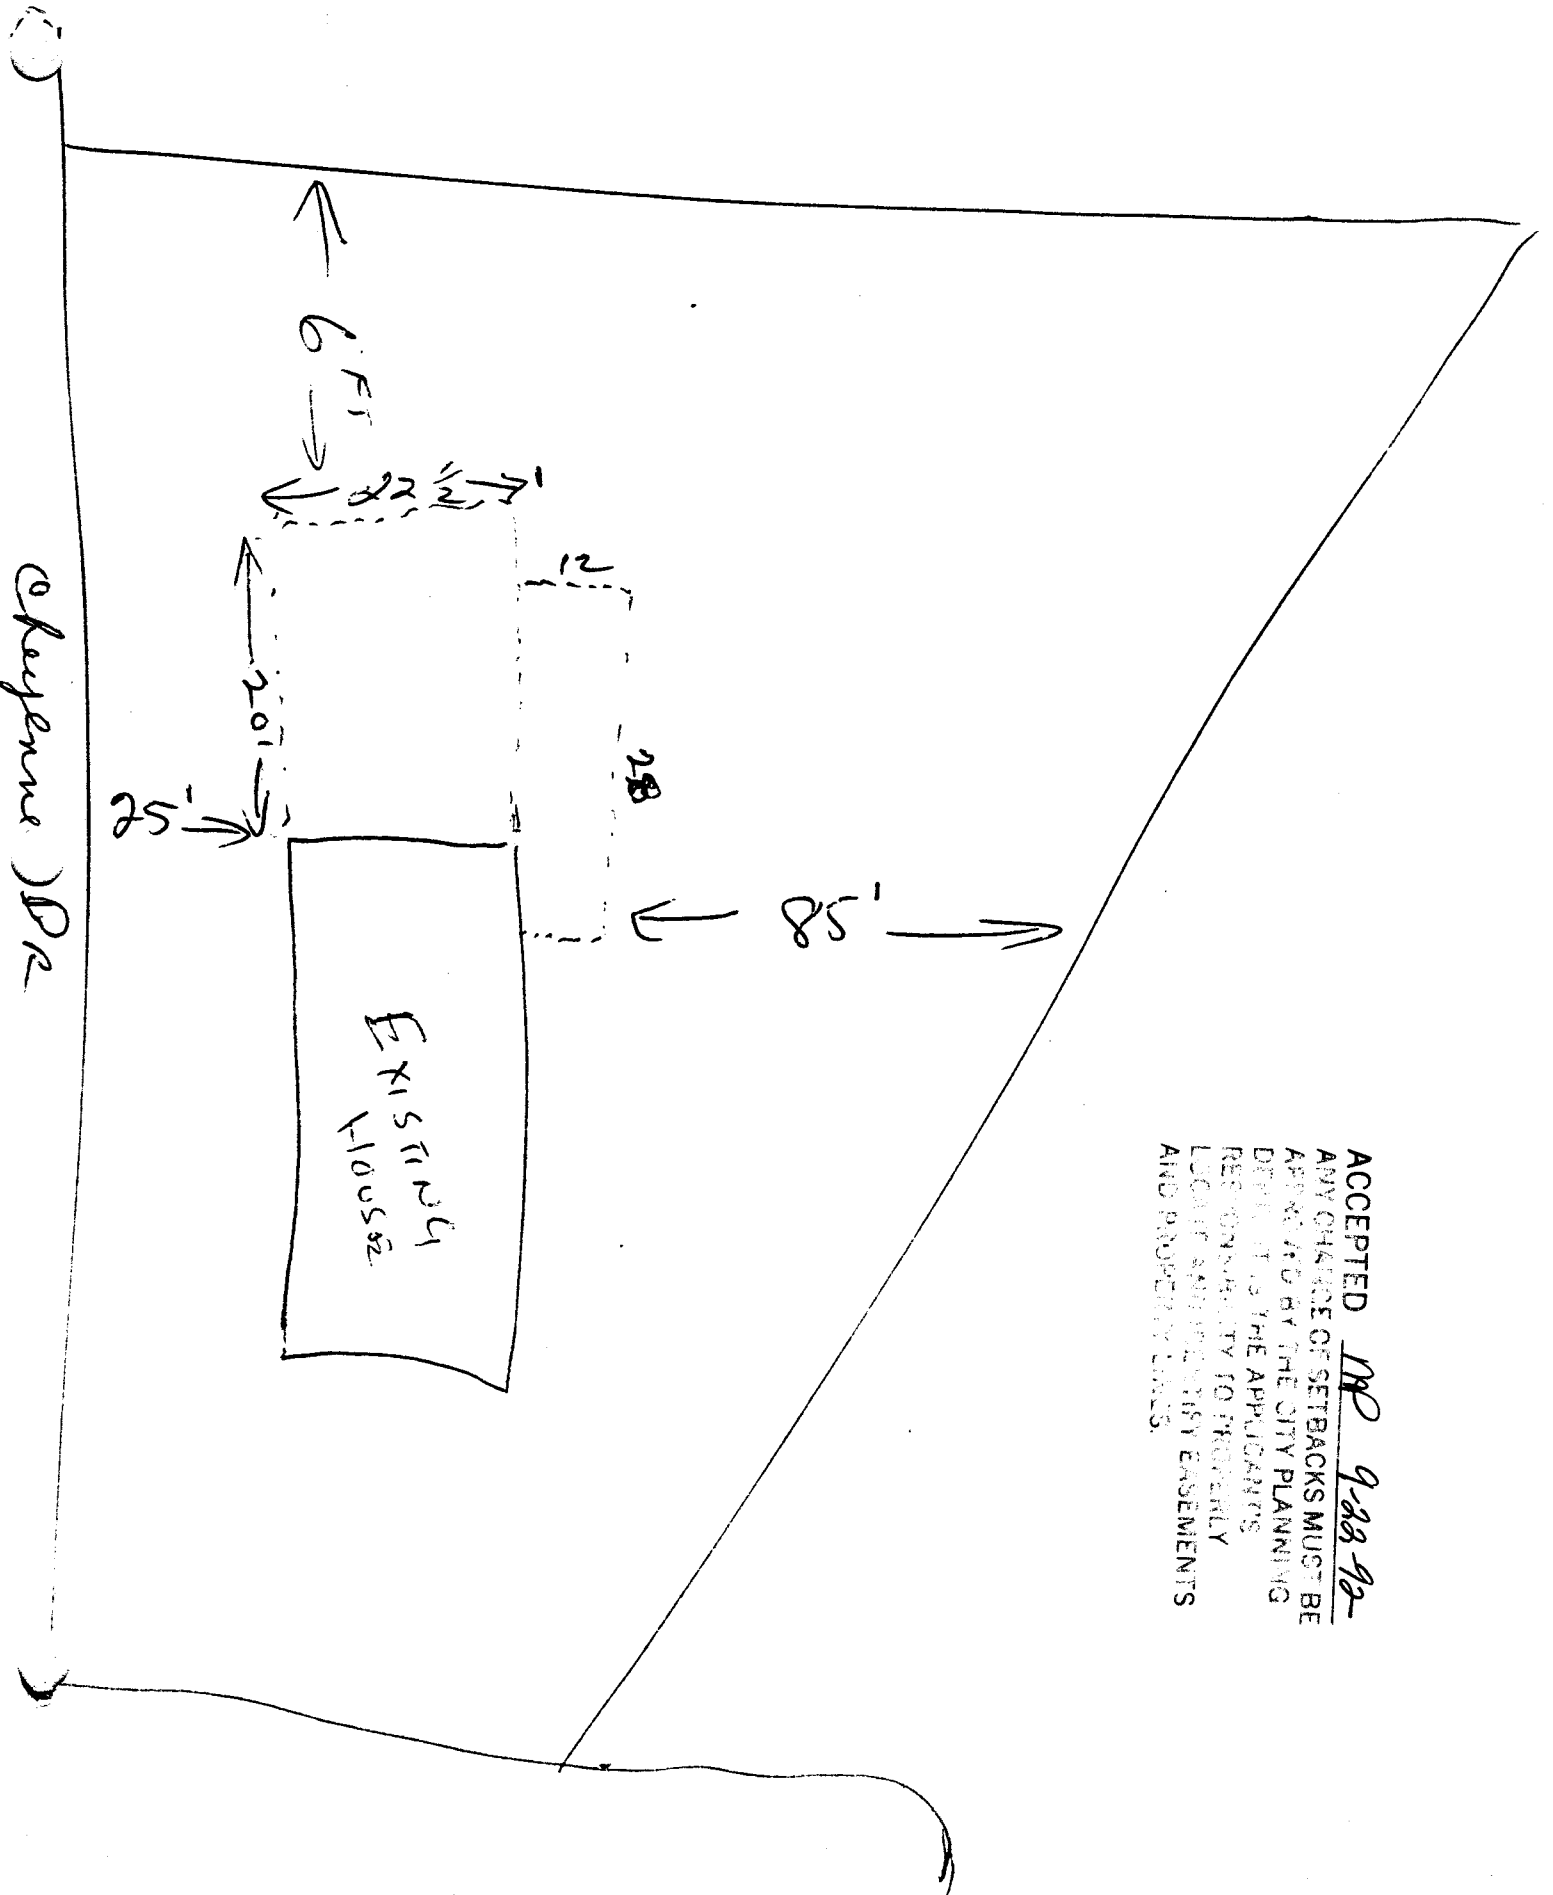

