
DATE SUBMITTED: // - / -	DATE SUBMITTED:	11-2	-92	
--------------------------	-----------------	------	-----	--

PERMIT NO.	A STATE OF THE STA

FEE\$ 5.00

DI /			^ı ı	~ A	n,		\sim \sim
PI /	NIN	IG (PΑ	K.	١N	l.t

2702 \$ 2704	Wash Bir. Cos of BLDG: 1250
BLDG ADDRESS	
SUBDIVISION <u>Indian Wen</u>	SQ. FT. OF LOT: 10 let
TILING # BLK #	LOT # NO. OF FAMILY UNITS:
TAX SCHEDULE # <u>2943 -064-</u>	NO. OF BUILDINGS ON PARCEL BEFORE THE PLANNED CONSTRUCTION:
OWNER <u>Jack Flaner</u>	Atom ItA
ADDRESS <u>521 29 / z</u> TELEPHONE: <u>242 - 2060</u>	DESCRIPTION OF WORK AND INTENDED USE:
	ing, landscaping, setbacks to all property lines, and all streets which abut the parce
Edelines. Two bees brains and and Bearing	
*************************	FOR OPPIOE TICE ONLY
	FOR OFFICE USE ONLY
ZONE	FLOODPLAIN: YES NOX
ETBACKS: FROM	GEOLOGIC HAZARD: YESNO X
REAL REAL	CENSUS TRACT: TRAFFIC ZONE:
MAXING HEIGHT \/\"	PARKING REQ'MT
ANDSCAPING/SCREENING REQUIR	ED: SPECIAL COMPITIONS:
, , ,	Acres #2(-A1)
Modifications to this Planning Clearance	must be approved, in writing, by this Department. The structure approved by the
Modifications to this Planning Clearance application cannot be occupied until a Cer Building Code). Any landscaping required by this permit shapes a second control of the	must be approved, in writing, by this Department. The structure approved by the tificate of Occupancy is issued by the Building Department (Section 307, Uniformall be maintained in an acceptable and healthy condition. The replacement of an







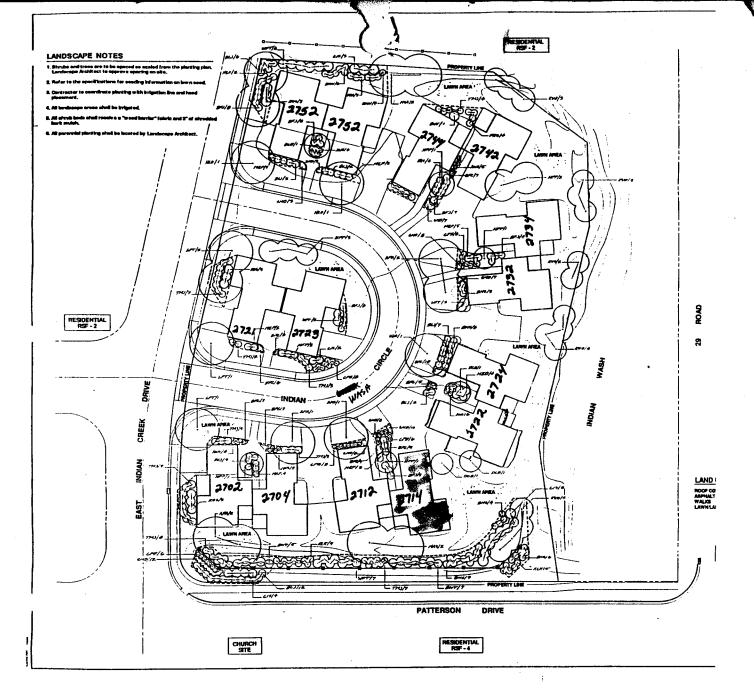

ACCEPTED AU 8-497
ANY CHANGE OF SETBACKS AUST TO
ASTROVED BY THE CITY I-L ANALOS
BESTONEIBLITY OF A STANGENEY
LOCATE AND IDEAL OF CUSTAMENTS
AND FROPERTY LINES.