	114932\$	
date submitted: $5/7/93$	PERMIT NO	
/ /	PERMIT NO. 44932 F FEE \$ 500 94933	
PLANNING CLEARANCE		
GRAND JUNCTION COMMUNITY DEVELOPMENT DEPARTMENT		
BLDG ADDRESS 746 23/2 ROAD	SQ. FT. OF BLDG:	
SUBDIVISION	SQ. FT. OF LOT:	
FILING # BLK # LOT #	NO. OF FAMILY UNITS:	
TAX SCHEDULE # <u>270/-324-00-037</u>	NO. OF BUILDINGS ON PARCEL BEFORE THIS PLANNED CONSTRUCTION:	
OWNER The K Courtney	USE OF EXISTING BUILDINGS:	
ADDRESS <u>K20 Pronjule pt</u>	for fleamarket	
TELEPHONE: 242 24 59	DESCRIPTION OF WORK AND INTENDED USE: NTERIOR REMODEL, KITCHEN	
<b>FINTERIOR FLUMBING IN BIARN</b> REQUIRED: Two plot plans showing parking, landscaping, setbacks to all property lines, and all streets which abut the parcel.		
************		
FOR OFFICE USE ONLY		
<sup>2</sup> ONE FLOO	DPLAIN: YES NO	
SETBACKS: FRONT GEOL	OGIC HAZARD: YES NO	
SIDE REAR // CENSUS TRACT: TRAFFIC ZONE:		
MAXIMUM HEIGHT PARK	ING REQ'MT TO BE DETERMINED WAT FLEA	
LANDSCAPING/SCREENING/REQUIRED: SPECI	AL CONDITIONS: Rost in Droppement Lees	
- to be pai	A prim to issuing autificate	
·····		
Modifications to this Planning Clearance must be approved, in writing, by this Department. The structure approved by this, $   _{1}^{95}$		
application cannot be occupied until a Certificate of Occupancy is issued by the Building Department (Section 307, Uniform () Building Code).		


7

Any landscaping required by this permit shall be maintained in an acceptable and healthy condition. The replacement of any vegetation materials that die or are in an unhealthy condition shall be required.

I hereby acknowledge that I have read this application and the above is correct, and I agree to comply with the requirements above. Failure to comply shall result in legal action.

abover i andre to compty bhan rebuilt in regul action	
Kartos Motrun	Courturen
Department Approval	Applicant Signature
5/13/93	5/13.93
/Date'Approved	Date

VALID FOR SIX MONTHS FROM DATE OF ISSUANCE (Section 9-3-2 D Grand Junction Zoning & Development Code)

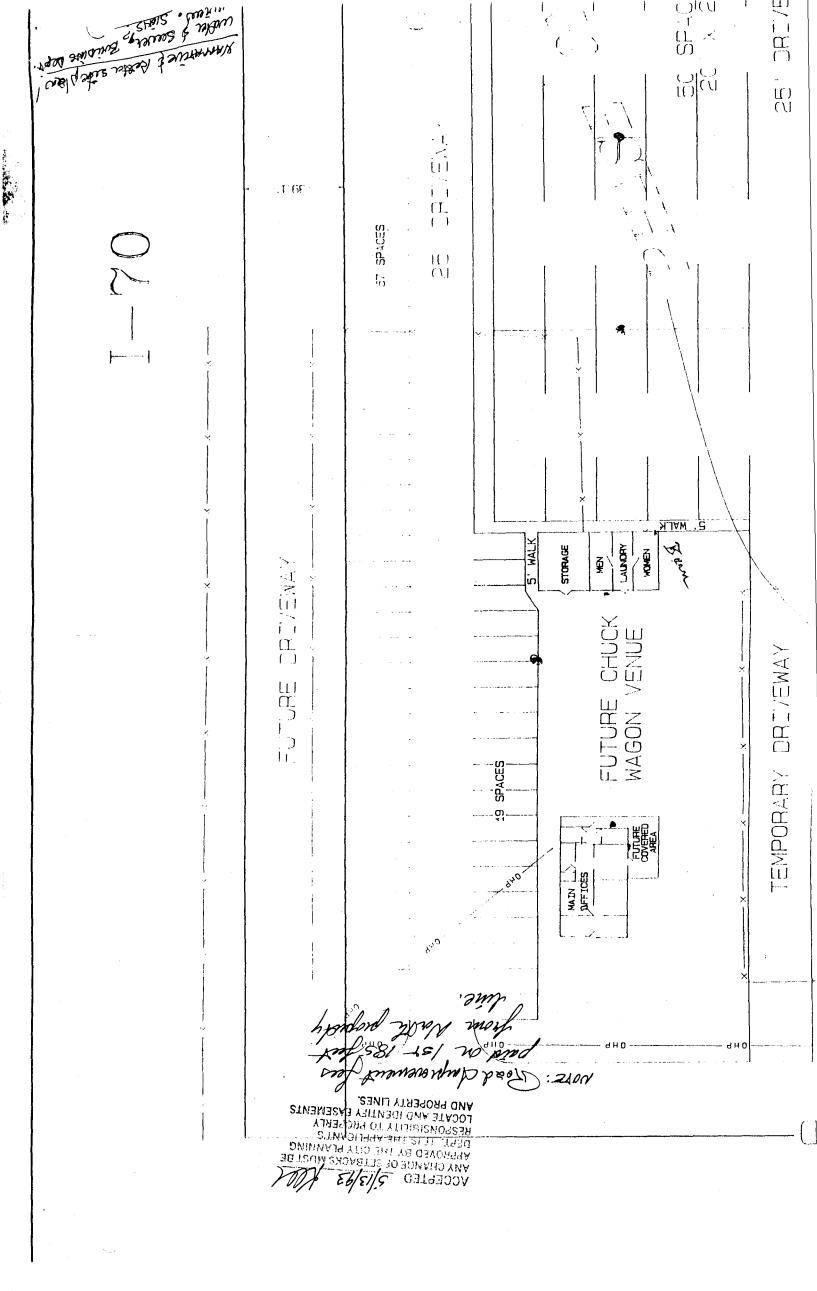

This approval is for Phase One Development. Future development of this property will require additional review. Lader Metzien

.....

-