


ACCEPTED
 ANY CHANGE OF SETBACKS BEING
 MADE TO THIS PROPERTY
 SHALL BE THE RESPONSIBILITY OF THE
 OWNER AND IDENTIFY EASEMENTS
 LOCATE AND IDENTIFY INDEPENDENCE RANCH ROAD
 AND PROPERTY LINES.

XV 10-11-99

2033 F-3/4 ROAD

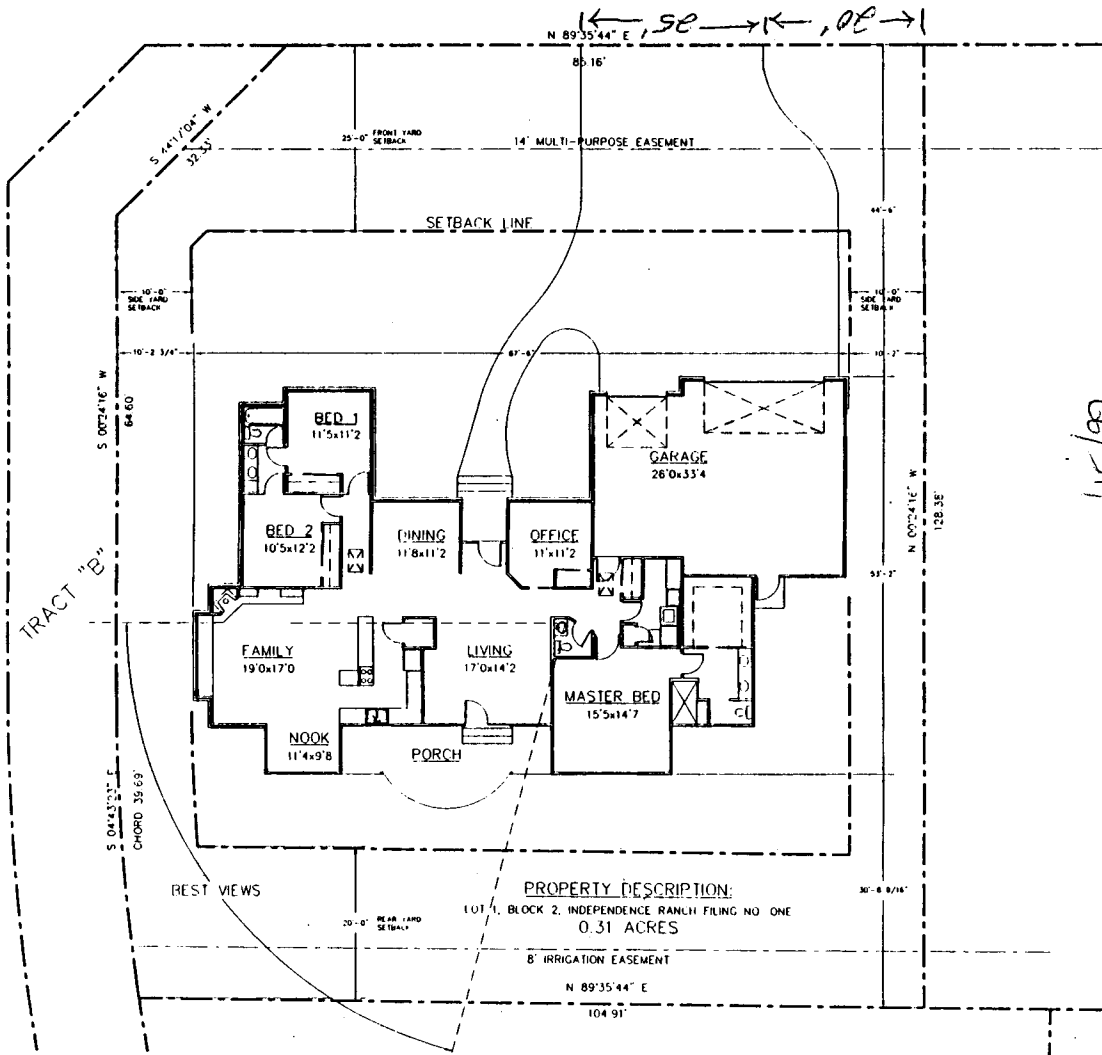

6/15/99
 DRIVE O.K.
 Jm/wh

SITE PLAN
 1/8" = 1'-0"

Copyright 1999
 All designs appearing
 herein shall not be
 duplicated, produced,
 or otherwise used
 without the written
 consent of
 DKO Architecture, PC

DKO
 ARCHITECTURE, PC
 Grand Junction, Colorado
 (970)246-9792

REKEMEYER RESIDENCE
 674 Independence Ranch Road
 Grand Junction, CO

6/09/99
 Project No. 9909 Phase CD
 Sheet No. C1