FEE\$ 10.00 PLANNING CL	EARANCE BLDG PERMIT NO.
TCP \$ (Single Family Residential ar	
SIF \$ Community Develop	ment Department
	Your Bridge to a Better Community
BLOG ADDRESS A774 OK [LUN]	AUL <i>QPROX.</i> SQ. FT. OF PROPOSED BLDGS/ADDITION <u>8-10</u>
TAX SCHEDULE NO. 2945-011-24-010	SQ. FT. OF EXISTING BLDGS
SUBDIVISION upple Crest	TOTAL SQ. FT. OF EXISTING & PROPOSED
FILINGBLKLOT_10	NO. OF DWELLING UNITS:
"OWNER -LOVX Black	Before: After: this Construction NO. OF BUILDINGS ON PARCEL
(1) ADDRESS 2444 CORTLAND ADE	Before: After: this Construction
(1) TELEPHONE 242-2776	USE OF EXISTING BUILDINGS
	DESCRIPTION OF WORK & INTENDED USE
<sup>(2)</sup> ADDRESS	TYPE OF HOME PROPOSED: Site Built Manufactured Home (UBC)
<sup>(2)</sup> TELEPHONE	Manufactured Home (HUD) Other (please specify)
REQUIRED: One plot plan on 8 1/8" x 11" paper showing a	ill existing & nonnsed structure location(s) parking sethacks to all
REQUIRED: One plot plan, on 8 ½" x 11" paper, showing a property lines, ingress/egress to the property, driveway loc	ation & width & all easements & rights-of-way which abut the parcel.









(White: Planning)

ŀ

.


(Yellow: Customer)

(Goldenrod: Utility Accounting)

11-19-02 Hayleen Henderor CCEPTED Hayleen Henderor DN GHANGE OF SETBACKS MUST ST DUCANTS DUCANTS DUCANTS DUCANTS WALR AND IDENTIFY EASEMENTS

AND PROPERTY LINES.

.

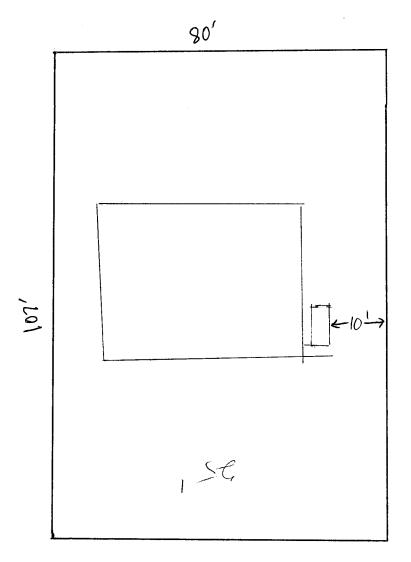

-

۲

нų:

Cortland