


FEE \$	10.00
TCP \$	500.00
SIF \$	292.00

PLANNING CLEARANCE
 (Single Family Residential and Accessory Structures)
Community Development Department

BLDG PERMIT NO. 85640

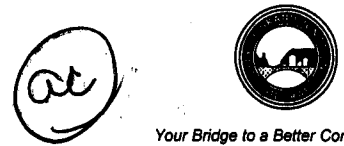

BLDG ADDRESS 388 Myrrh St.
 TAX SCHEDULE NO. 29431910006
 SUBDIVISION White Willows
 FILING 1 BLK 6 LOT 3
 (1) OWNER DAVID m. COOP
 (1) ADDRESS ~~476~~ 476 Olson Dr.
 (1) TELEPHONE 970-261-0417
 (2) APPLICANT _____
 (2) ADDRESS _____
 (2) TELEPHONE _____

SQ. FT. OF PROPOSED BLDGS/ADDITION 1723 House 540 GARAGE
 SQ. FT. OF EXISTING BLDGS 0
 TOTAL SQ. FT. OF EXISTING & PROPOSED 2263
 NO. OF DWELLING UNITS:
 Before: 0 After: 1 this Construction
 NO. OF BUILDINGS ON PARCEL
 Before: 0 After: 1 this Construction
 USE OF EXISTING BUILDINGS New Home
 DESCRIPTION OF WORK & INTENDED USE New Home
 TYPE OF HOME PROPOSED:
 Site Built _____ Manufactured Home (UBC)
 _____ Manufactured Home (HUD)
 _____ Other (please specify) _____

REQUIRED: One plot plan, on 8 1/2" x 11" paper, showing all existing & proposed structure location(s), parking, setbacks to all property lines, ingress/egress to the property, driveway location & width & all easements & rights-of-way which abut the parcel.

THIS SECTION TO BE COMPLETED BY COMMUNITY DEVELOPMENT DEPARTMENT STAFF

ZONE RSF-4
 SETBACKS: Front 20' from property line (PL)
 or _____ from center of ROW, whichever is greater
 Side 7' from PL, Rear 25' from PL
 Maximum Height 35'

Maximum coverage of lot by structures 50%
 Permanent Foundation Required: YES NO _____
 Parking Req'mt 2
 Special Conditions _____
 CENSUS 8 TRAFFIC 60 ANN# _____

Modifications to this Planning Clearance must be approved, in writing, by the Community Development Department. The structure authorized by this application cannot be occupied until a final inspection has been completed and a Certificate of Occupancy has been issued, if applicable, by the Building Department (Section 305, Uniform Building Code).

I hereby acknowledge that I have read this application and the information is correct; I agree to comply with any and all codes, ordinances, laws, regulations or restrictions which apply to the project. I understand that failure to comply shall result in legal action, which may include but not necessarily be limited to non-use of the building(s).

Applicant Signature [Signature] Date 8/1/02
 Department Approval [Signature] Date 8-30-02

Additional water and/or sewer tap fee(s) are required:	YES <input checked="" type="checkbox"/>	NO	W/O No. <u>15264</u>
Utility Accounting	<u>[Signature]</u>	Date	<u>8/30/02</u>

VALID FOR SIX MONTHS FROM DATE OF ISSUANCE (Section 9-3-2C Grand Junction Zoning & Development Code)

(White: Planning) (Yellow: Customer) (Pink: Building Department) (Goldenrod: Utility Accounting)

8-30-02

Gayle Anderson

EAST

ACCEPTED

ANY CHANGE OF SETBACKS MUST BE APPROVED BY THE CITY PLANNING DEPT. IT IS THE APPLICANT'S RESPONSIBILITY TO PROPERLY LOCATE AND IDENTIFY EASEMENTS AND PROPERTY LINES.

97.0'

30'-0"

46'-4"

NORTH

988 Myrrh St.
DMC Builders
201-0417

SOUTH

106.95

5'-0"

17'-2"

14'-10"

5'-0"

DRIVEWAY

16'-0"

25'-4"

23'-4"

WEST

61'-2"

18'-0"

FRONT OF HOUSE

MYRRH ST.

388 Myrrh St.
434-8170

Dave O'Neil
Paul Davis
8-1-02

Revised

9/16/02

C. Jay Nelson

ACCEPTED
ANY CHANGE OF SETBACKS MUST BE
APPROVED BY THE CITY PLANNING
DEPT. IT IS THE APPLICANT'S
RESPONSIBILITY TO PROPERLY
LOCATE AND IDENTIFY EASEMENTS
AND PROPERTY LINES

388
myrrh st.
DMC
Builders
261-0417

33'-0"

SOUTH

NORTH

← 13'-0" →

19'-0"

5'-0"

22'-0"

FRONT OF HOUSE
WEST

DRIVEWAY

16'-0"

side walk
MYRRH ST.

