
FEE\$ 10:00 PLANNING CLEA	
TCP \$ (Single Family Residential and Additional SIF \$ SIF \$ Community Developme	
Building Address 27090mibben	No. of Existing Bldgs <u>3</u> Your Bridge to a Better Community
Parcel No. 270125304016	Sq. Ft. of Existing Bldgs 1974 Proposed
Subdivision PARALISE H1115	Sq. Ft. of Lot / Parcel
Filing Block Lot	Sq. Ft. Coverage of Lot by Structures & Impervious Surface (Total Existing & Proposed)
OWNER INFORMATION:	DESCRIPTION OF WORK & INTENDED USE:
Name MAX \$-JOYAE FLUCKIGEN Address 2)09 CMPN 6 5 FM DK	New Single Family Home (<u>*ch</u> eck type below)
Address 2)09 CMPNB 5FAN DK City/State/Zip C.J. C.B. 81504	Other (please specify):
	*TYPE OF HOME PROPOSED:
APPLICANT INFORMATION: Name	Site Built Manufactured Home (UBC) Manufactured Home (HUD)
Address	Other (please specify):
City / State / Zip	NOTES:
Telephone	
REQUIRED: One plot plan, on 8 ½" x 11" paper, showing all e	xisting & proposed structure location(s), parking, setbacks to all






MUNITY DEVELOPMENT DEPARTMENT STAFF Maximum coverage of lot by structures 50.70 Permanent Foundation Required: YES NO X Parking Requirement 2 Special Conditions i, in writing, by the Community Development Department. The until a final inspection has been completed and a Certificate of epartment (Section 305, Uniform Building Code). information is correct; I agree to comply with any and all codes, is project. I understand that failure to comply shall result in legal on-use of the building(s). Munities $12 - 16 - 03$ Date $12 / 10 / 03$

·

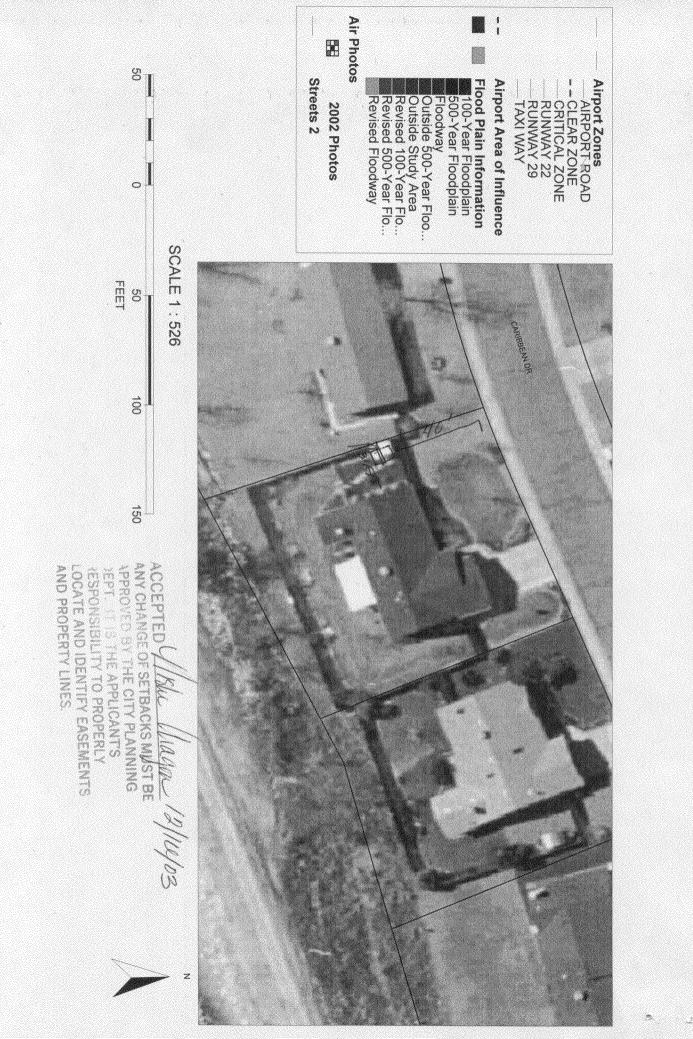

City of Grand Junction GIS Zoning Map ©

http://gis-web-fs.ci.grandjct.co.us/maps/zoning.mwf

Tuesday, December 16, 2003 1:01 PM