
	BLDG PERMIT NO. 90730
Community	idential and Accessory Structures)
SIF \$ 292.00	
Building Address 2369 CLAYS	TOJECT No. of Existing Bldgs Proposed
Parcel No. 2945-204-01-0	Sq. Ft. of Existing Bldgs Proposed 2900 g
Subdivision REDLANDS ME	
Filing / Block / Lot	23 Sq. Ft. Coverage of Lot by Structures & Impervious Surface (Total Existing & Proposed) 5500 \$\varphi\$
OWNER INFORMATION:	
Name TED: MARY Elley M	
Address 520 Shadbury CT	Interior Remode! Addition
City/State/Zip for2t Collins co	*TYPE OF HOME PROPOSED:
APPLICANT INFORMATION:	
Name BENKHMARK CM LLC/13	STEVC Site Built Manufactured Home (UBC) Context (please specify):
Address 1959 BROADWAY	
City/State/Zip GRAND JCt.	
Telephone 973-243-4847	/250-7700
	showing all existing & proposed structure location(s), parking, setbacks to all
property lines, ingress/egress to the property, di	riveway location & width & all easements & rights-of-way which abut the parcel.






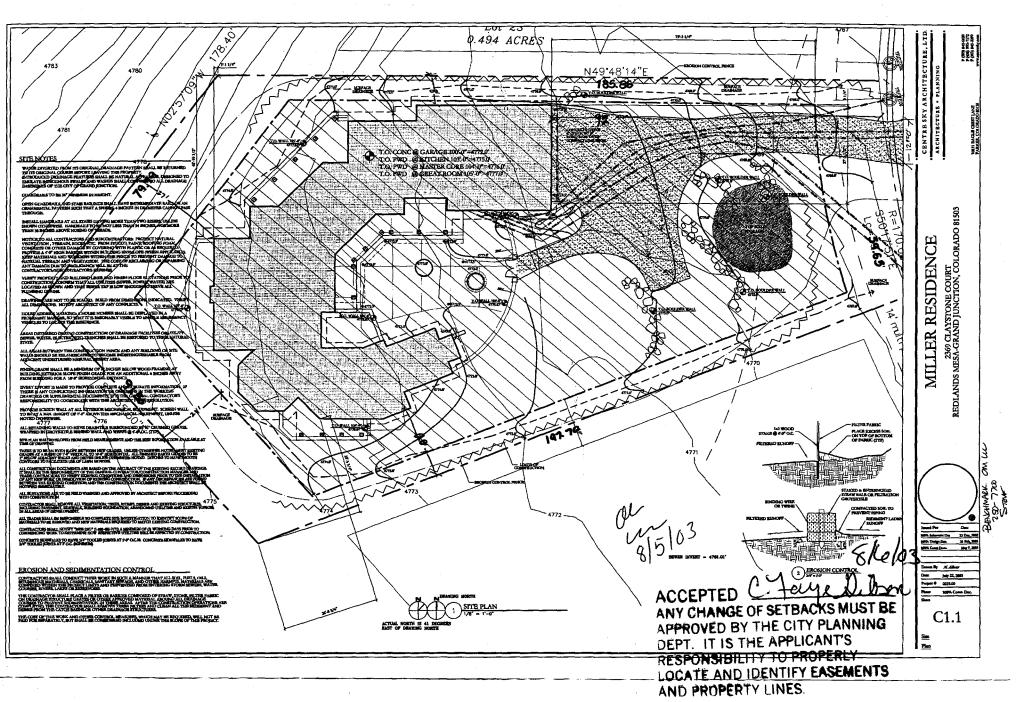

•