FEE\$	10.00
TCP\$	Ø
SIF\$	Ø

## PLANNING CLEARANCE

BLDG PERMIT NO.

(Single Family Residential and Accessory Structures)


Community Development Department





Building Address 6405 Hwy 50 #2  Parcel No. 2945-262-00-033	No. of Existing Bldgs Proposed
Parcel No. 2945-262-00-033	Sq. Ft. of Existing Bldgs Proposed
Subdivision	Sq. Ft. of Lot / Parcel
Filing Block Lot	Sq. Ft. Coverage of Lot by Structures & Impervious Surface (Total Existing & Proposed)
OWNER INFORMATION:	
Name Darrell Johnson	DESCRIPTION OF WORK & INTENDED USE:
Name Darrell Johnson Address 640 S. Hwy 50 # 2	New Single Family Home (*check type below) Interior Remodel Addition
City/State/Zip Grand Jet CO 81503	Other (please specify): 10×10 ≤ hed
APPLICANT INFORMATION:	*TYPE OF HOME PROPOSED:
Name <u>Same</u>	Site Built Manufactured Home (UBC) Manufactured Home (HUD) Other (please specify):
Address	Carles (piecese operary).
	NOTES:
Telephone 257-1981 payer 255-3045	<u> </u>
REQUIRED: One plot plan, on 8 ½" x 11" paper, showing all existing & proposed structure location(s), parking, setbacks to all property lines, ingress/egress to the property, driveway location & width & all easements & rights-of-way which abut the parcel.	
property lines, ingress/egress to the property, driveway location	on o width o an easements o rights-of-way which abut the parcel. 🗈
	MUNITY DEVELOPMENT DEPARTMENT STAFF
THIS SECTION TO BE COMPLETED BY COM	MUNITY DEVELOPMENT DEPARTMENT STAFF
ZONE C-/	MUNITY DEVELOPMENT DEPARTMENT STAFF  Maximum coverage of lot by structures  Permanent Foundation Required: YESNO
ZONE	MUNITY DEVELOPMENT DEPARTMENT STAFF  Maximum coverage of lot by structures  Permanent Foundation Required: YES NO  Parking Requirement
ZONE	MUNITY DEVELOPMENT DEPARTMENT STAFF  Maximum coverage of lot by structures  Permanent Foundation Required: YESNO  Parking Requirement  Special Conditions
SETBACKS: Front /5/25 from property line (PL)  Side 0 / 0 from PL Rear _ 10 / 10 from PL  Maximum Height of Structure(s)  Driveway  Voting District Driveway  Modifications to this Planning Clearance must be approved	MUNITY DEVELOPMENT DEPARTMENT STAFF  Maximum coverage of lot by structures  Permanent Foundation Required: YESNO  Parking Requirement  Special Conditions  in writing, by the Community Development Department. The until a final inspection has been completed and a Certificate of
THIS SECTION TO BE COMPLETED BY	MUNITY DEVELOPMENT DEPARTMENT STAFF  Maximum coverage of lot by structures  Permanent Foundation Required: YES NO  Parking Requirement  Special Conditions  in writing, by the Community Development Department. The until a final inspection has been completed and a Certificate of epartment (Section 305, Uniform Building Code).  ie information is correct; I agree to comply with any and all codes, he project. I understand that failure to comply shall result in legal
SETBACKS: Front /5/25 from property line (PL)  Side 0/0 from PL Rear /0/10 from PL  Maximum Height of Structure(s)  Driveway Location Approval (Engineer's Initials)  Modifications to this Planning Clearance must be approved structure authorized by this application cannot be occupied Occupancy has been issued, if applicable, by the Building D  I hereby acknowledge that I have read this application and the ordinances, laws, regulations or restrictions which apply to the	MUNITY DEVELOPMENT DEPARTMENT STAFF  Maximum coverage of lot by structures  Permanent Foundation Required: YESNO  Parking Requirement  Special Conditions  in writing, by the Community Development Department. 



## City of Grand Junction GIS Zoning Map ©

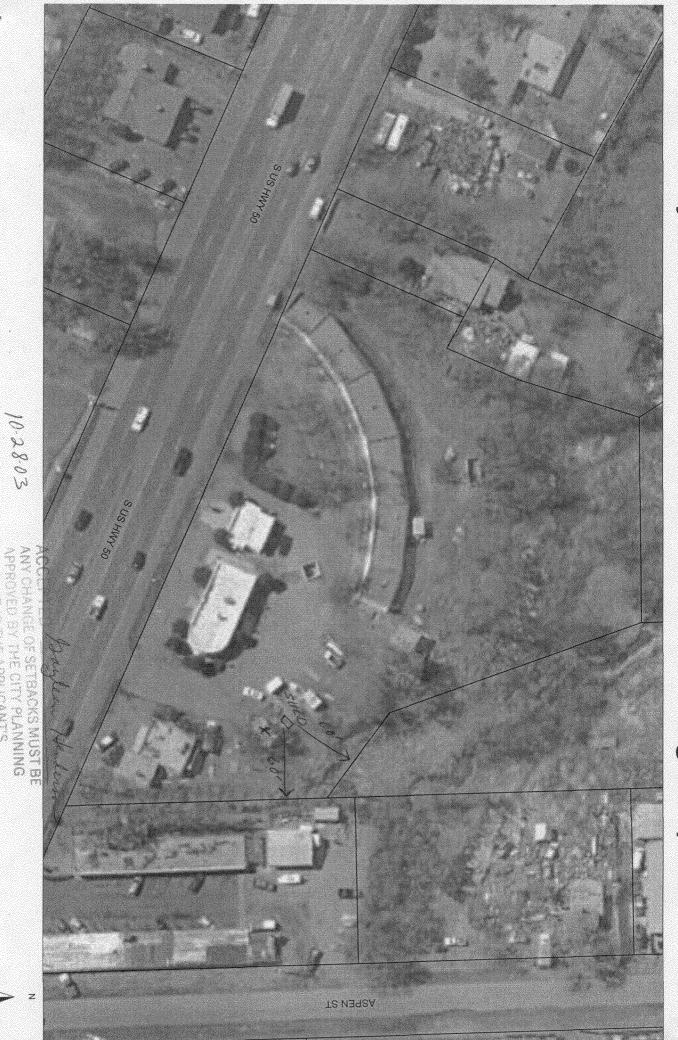

http://gis-web-fs.ci.grandjct.co.us/maps/zoning.mwf

Tuesday, October 28, 2003 12:26 PN

NO PROPERTY LINES

RESPONSIBILITY TO PROPERLY LOCATE AND IDENTIFY EASEMENTS